

SCALE: 1"=60'


NARRATIVE

The purpose of this survey is to add Lot 152 to the existing survey of Lot 268 which was completed in May, 1998. The northerly corners of 268 were set during the survey of Lot 269 in 1985. Control for the survey is from a traverse connecting the 6 exterior Section and Quarter corners of the subdivision.

LEGAL DESCRIPTION

All of Lots 268, 152, Evergreen Park Subdivision, according to the official Subdivision plat on file and of record with the Weber County Surveyor's office.

MAY 30, 2003

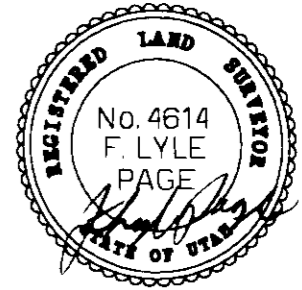

LEGEND

- Property corner--set 5/8" rebar and yellow cap at two southerly corners.
- Power Pole (2)

NOTE: Added Lot 152 to survey April 21, 2003.

RECEIVED  
JUN 05 2003  
Weber County Surveyor

003061

003061

SURVEY FOR		SECTION	TOWNSHIP	RANGE	DATE	SCALE
Phillip Ronk 2891 Evergreen Park Dr. Huntsville, Ut. 84317		30	7 No.	3 E.	5-14-03	1"=60'
LOT	BLOCK	PLAT	SURVEY			
152		1	EVERGREEN PARK SUBDIVISION			

**CONTRACT SURVEYORS**  
REGISTERED LAND SURVEYORS  
9740 SO. SITZMARK DR. SANDY, UTAH 84092