



SURVEYOR'S CERTIFICATE

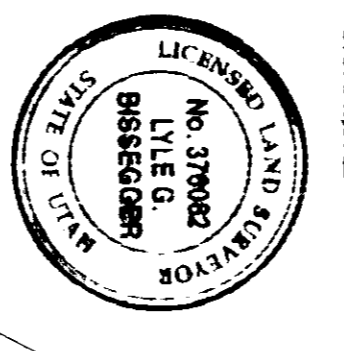

SURVEYED DESCRIPTION

NARRATIVE

BASIS OF BEARINGS
 THE BASIS OF BEARINGS FOR THIS PLAN IS THE EVERGREEN PARK SUBDIVISION NO. 1, S.L.B.M., U.S. SURVEY, SHOWN HEREON AS: S00°04'14" W.

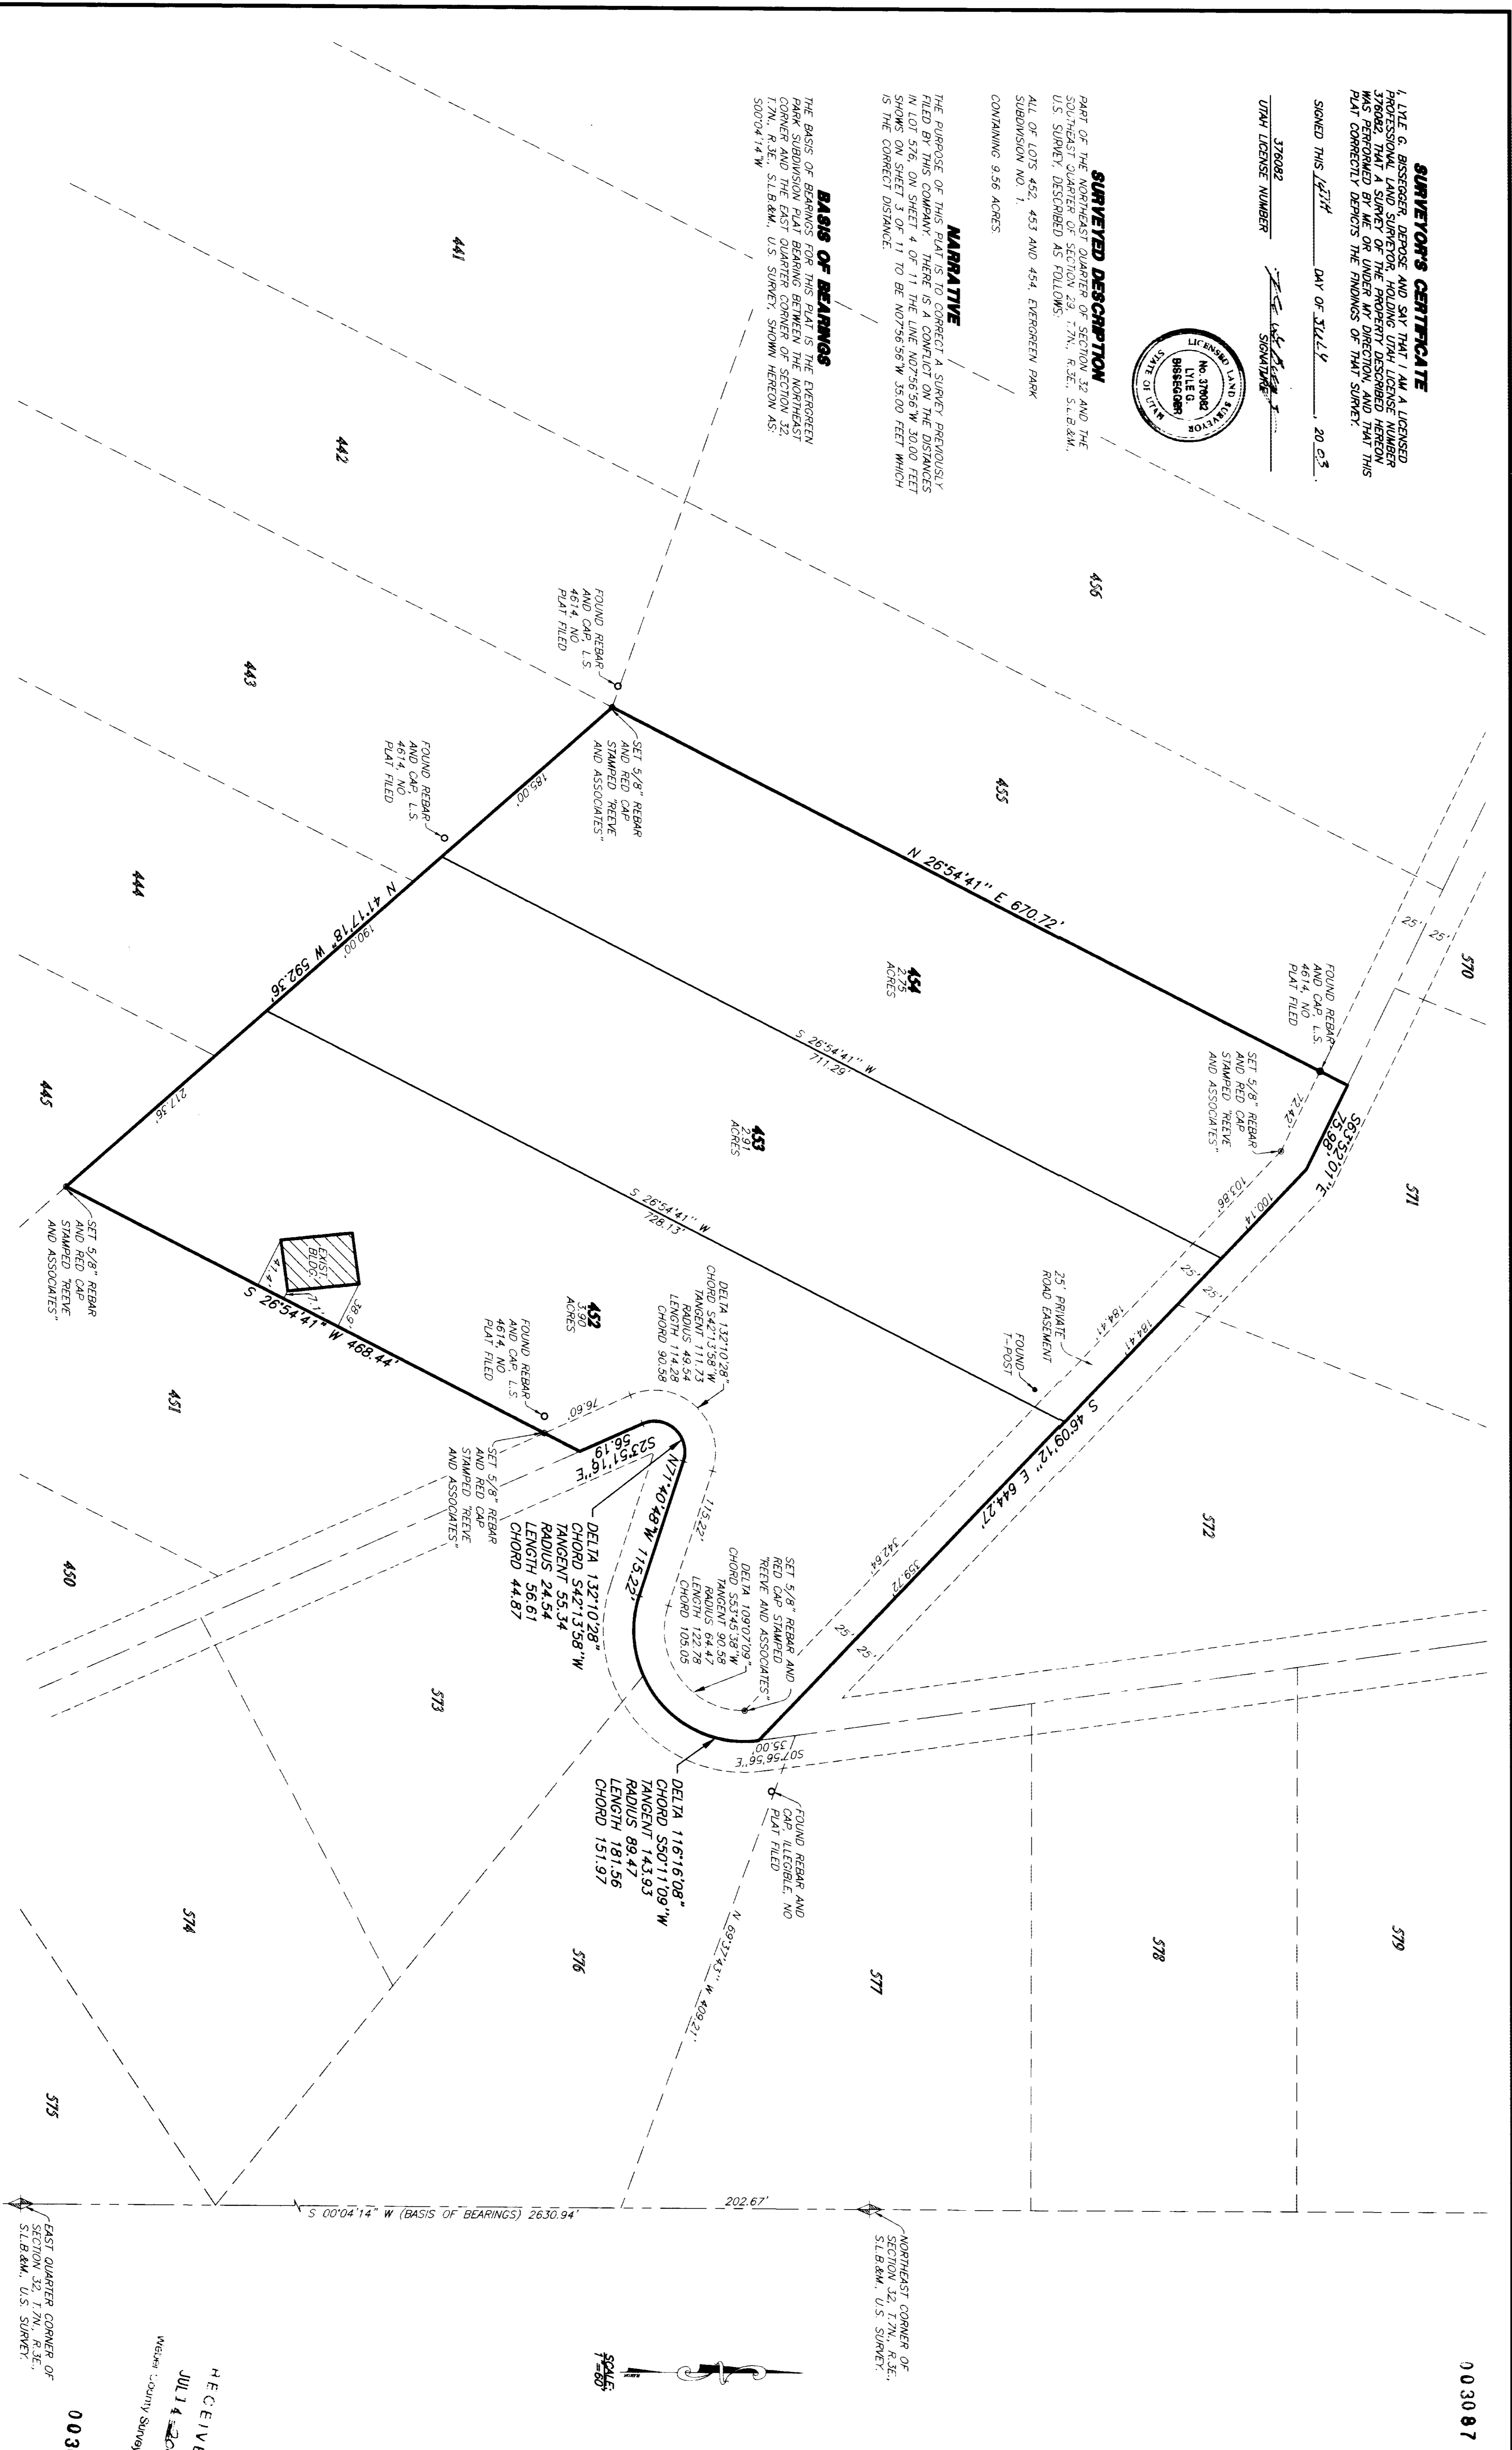

REVISIONS

1					
2					
3					
4					
5					
6					

PROJECT NO. 453-01 SURVEY AREA 1200
 DATE 07-02-03 DRAWN BY A.B.L.
 SCALE 1"=80' CHECKED BY

REEVE & ASSOCIATES, INC.
 Civil Engineering & Structural Engineering
 Surveying & Land Planning & Landscape Architecture
 EXECUTIVE BLDG. 4155 S. JAMISON BLVD. #110
 OGDEN, UTAH 84403
 (801) 853-7000 FAX (801) 857-2988

RECORD OF SURVEY

LOT 8 453-454, EVERGREEN PARK SUBDIVISION NO. 1
 PART OF THE NE 1/4 OF SEC. 32 AND WEST QUARTER, UTAH
 JULY, 2003

SHEET 1 OF 1 SHEETS

THESE PLANS AND SPECIFICATIONS ARE THE PROPERTY OF REEVE & ASSOC., INC., 3870 QUINCY AVE., OGDEN, UTAH. REEVE & ASSOC. SHALL NOT BE COPIED OR REDUCED OR REPRODUCED WITHOUT THEIR WRITTEN PERMISSION.

RECEIVED
 JUL 14 2003
 County Surveyors
 003087

003087