


**RECORD OF SURVEY**  
**PART OF LOT 5, BLOCK 24, PLAT "A",**  
**OGDEN CITY SURVEY, WEBER COUNTY, UTAH**


03088

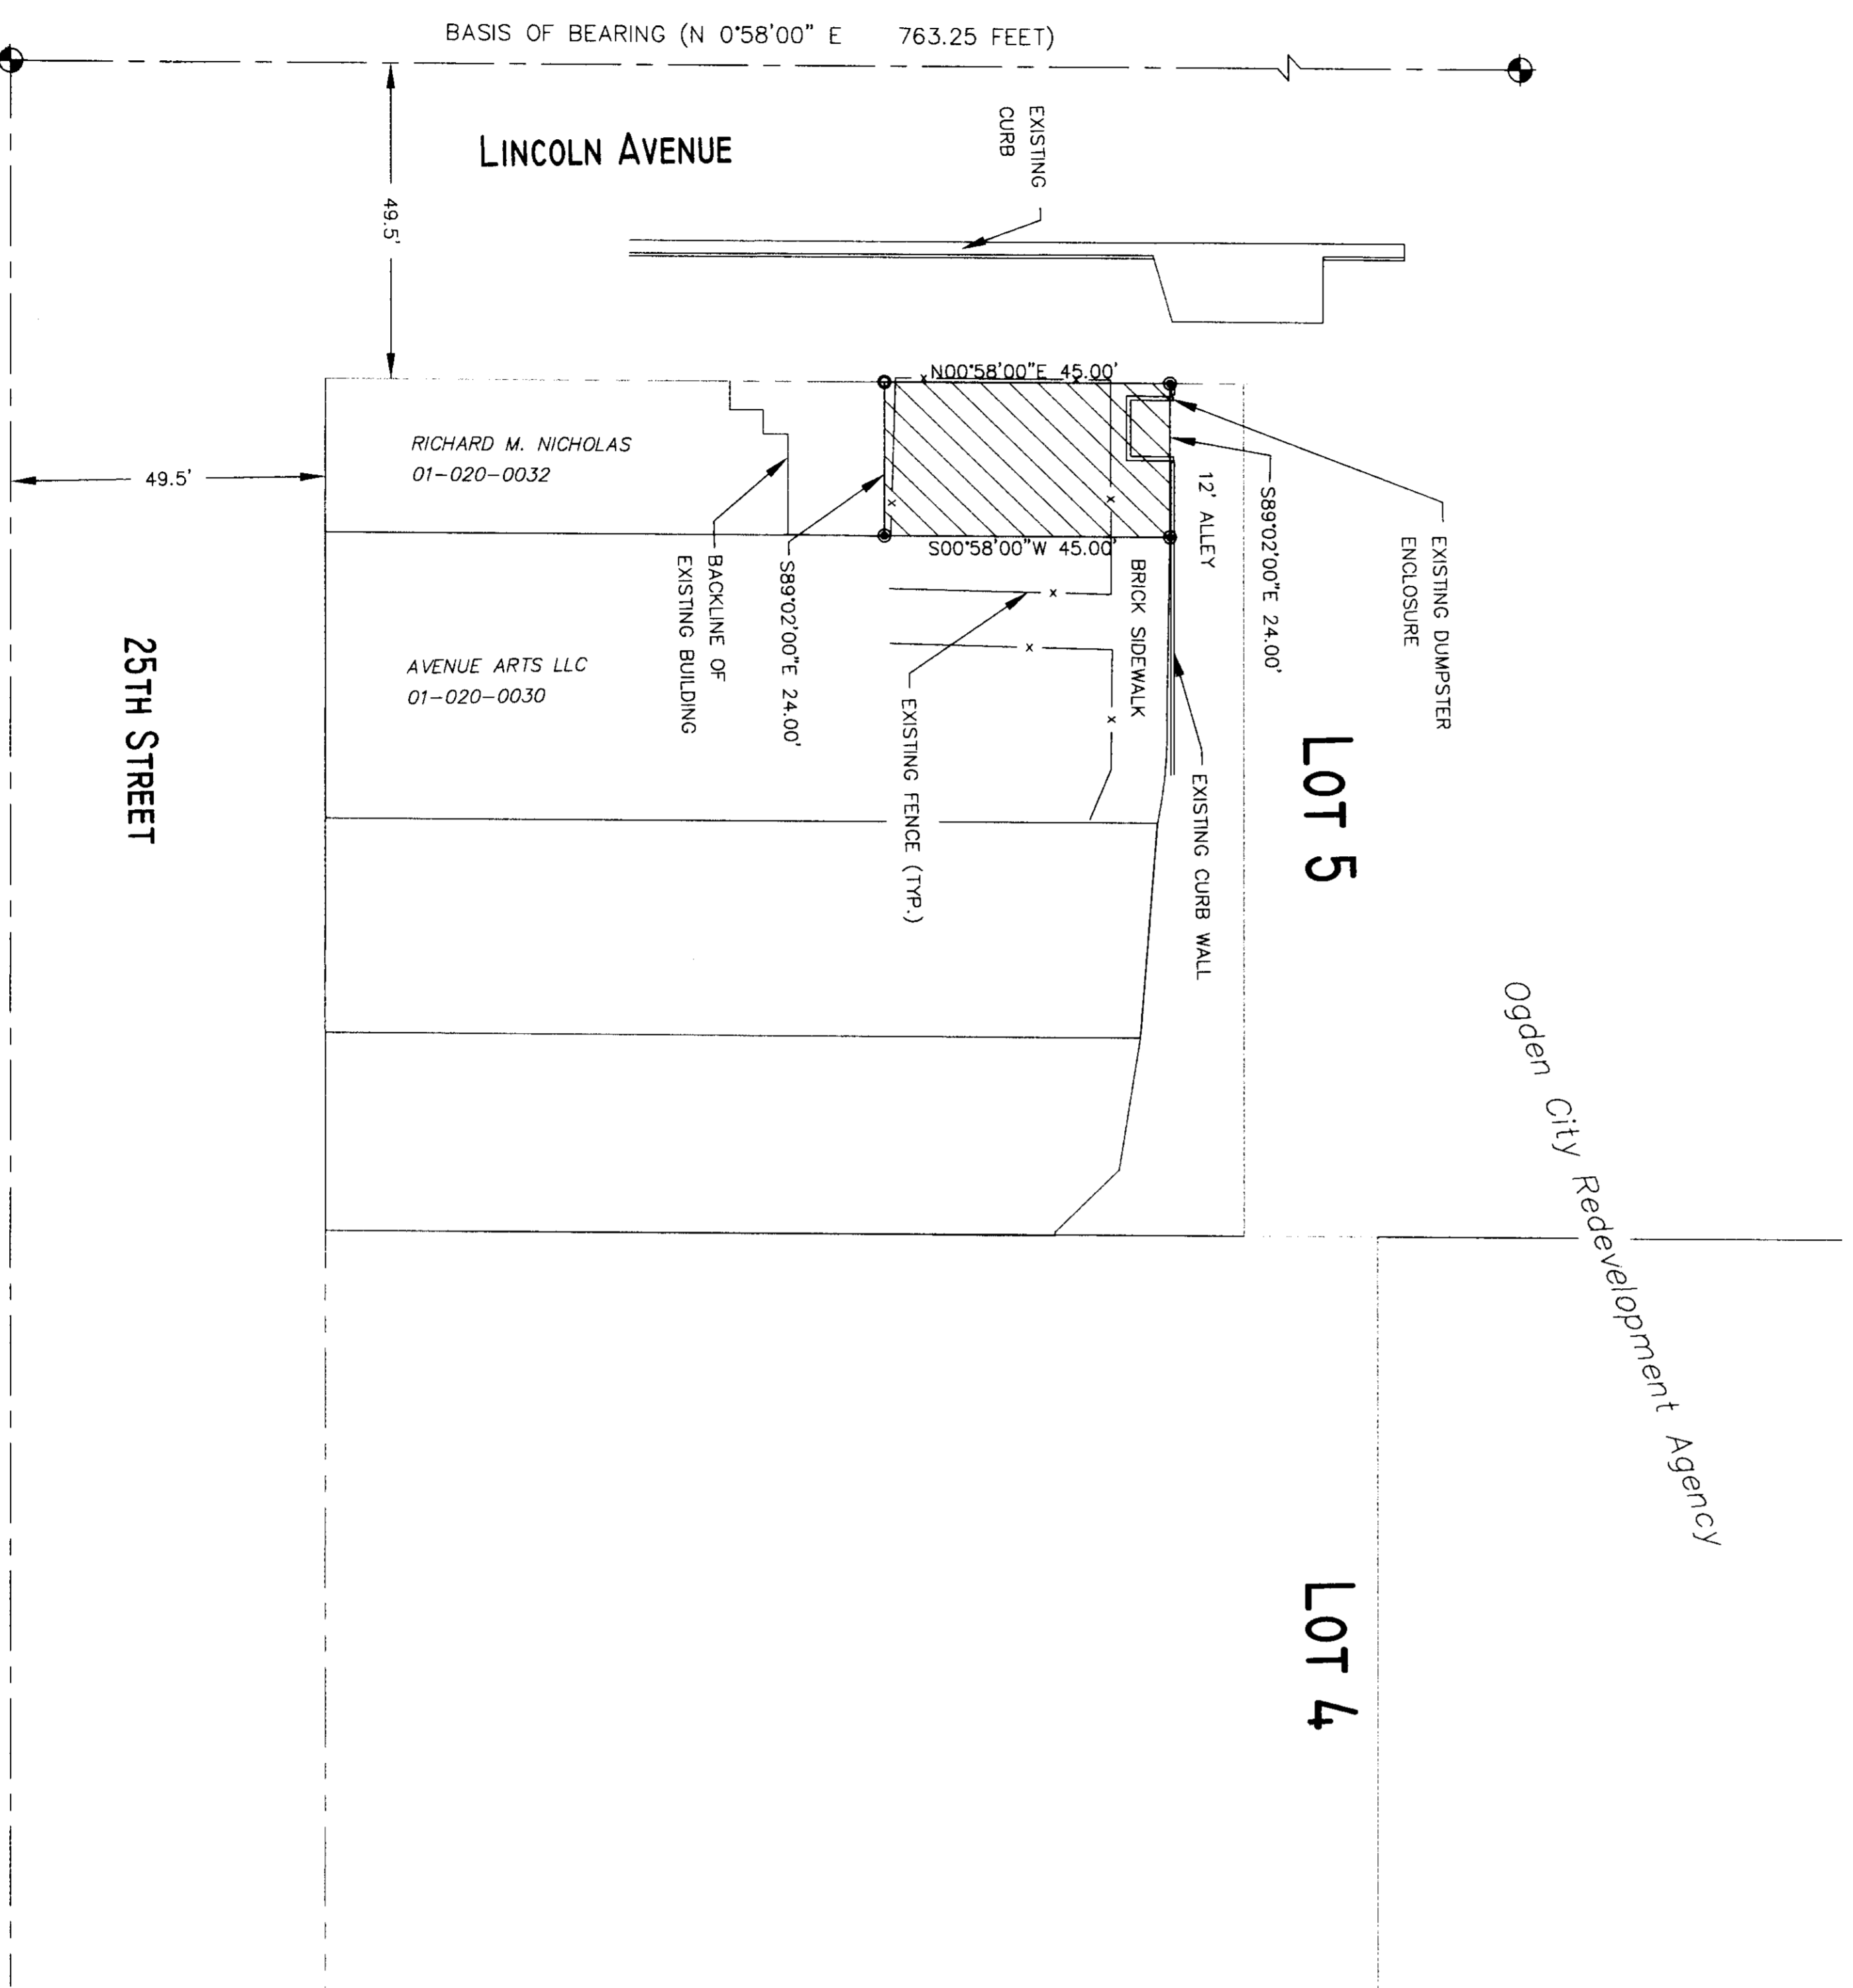

Ogden City Redevelopment Agency

**LOT 5**

**LOT 4**

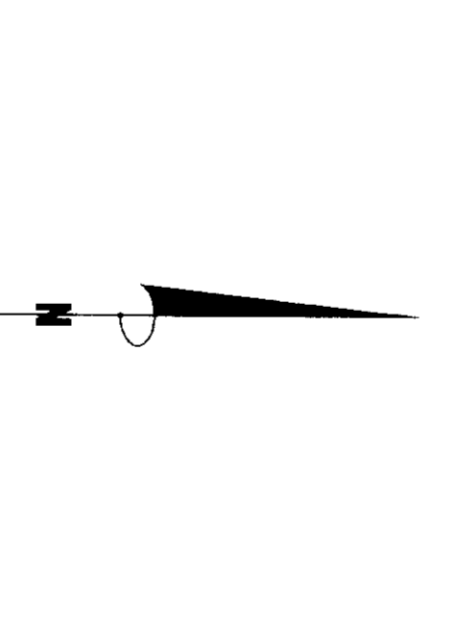

- - Ogden City Monument
- - SFR rebar with Ogden City Engineering cap
- - PVC Nail

**BOUNDARY DESCRIPTION**


**NARRATIVE**

This survey was requested by Ogden City Redevelopment Agency for the site of this parcel to the adjoining property owner.

**SURVEYOR CERTIFICATE**

I, **Scott A. Benge**, a Registered Land Surveyor as provided by the laws of the State of Utah and holding license number **17621**, do hereby certify that a survey of the above described property has been made by myself or under my direction and the plat herein is a true and correct representation of said survey to the best of my knowledge and belief.

Date: 7/6/03

Signed:



**RECEIVED**  
**JUL 15 2003**  
 Weber County Surveyor

03088