

**NARRATIVE**

This Survey was requested by Darlene Bates to determine the boundary of a parcel to be sold. A previous survey for Mr. Fred Brown (75-76-123) had been done by Great Basin Engineering, 1/2" = 20'. # Rebars were found along the boundary of the parcel. The monument corner of the property, Brass Cap Monument Survey of the Northwest 1/4 of Section 34, Township 7N, Range 1E, Section 34, T7N, R1E, S188M, U.S. Survey. A line bearing North 89°08'32" West between the Brass Cap monument was used as the basis of bearings. Property corners were monumented as depicted on this drawing.


**BOUNDARY DESCRIPTION**

A part of the Northwest Quarter of Section 34, Township 7 North, Range 1 West, Soil Lake Base and Meridian, U.S. Survey; Corporate Limits of North Ogden City; said point being 442.13 feet South 89°08'32" East along the Section line and 277.40 feet South 0°42'42" West from the Northwest corner of said Section 34; running thence South 82°40'39" East 20.81 feet along said Corporate Limits; thence S 63 feet North 82°00' East 352.3 feet; North 12.5 feet; East 6.5 feet; East 6.5 feet; North 88°00' East 346.42 feet; East 116.38 feet; thence South 88°57'45" East 103.31 feet; thence North 0°49'53" East 74.57 feet to the point of Beginning;



**SURVEYOR'S CERTIFICATE**

I, Gary L. Newman, do hereby certify that I am a Registered Land Surveyor and that the above described survey was made by me or under my supervision in the State of Utah, and I have made a survey of the here on described property, I further certify that the above plat correctly shows the true location of the property surveyed.

Date 6-24-2003

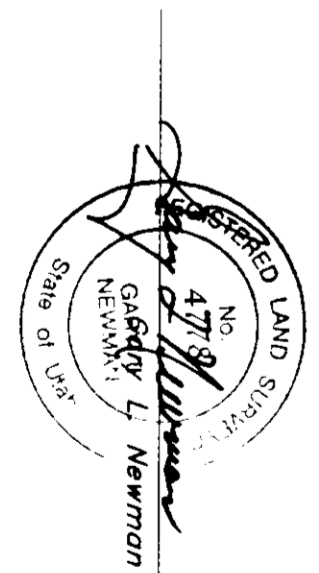

North 1/4 corner of Section 34, Township 7N, Range 1E, Section 34, T7N, R1E, S188M, U.S. Survey (Found Brass Cap Monument)

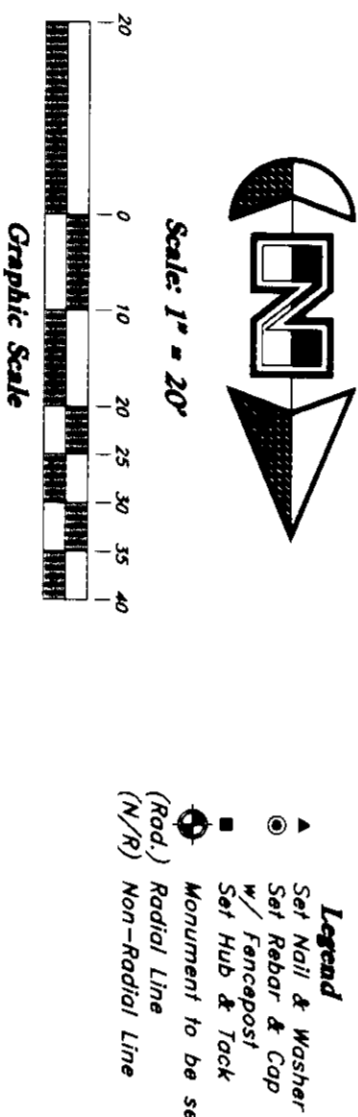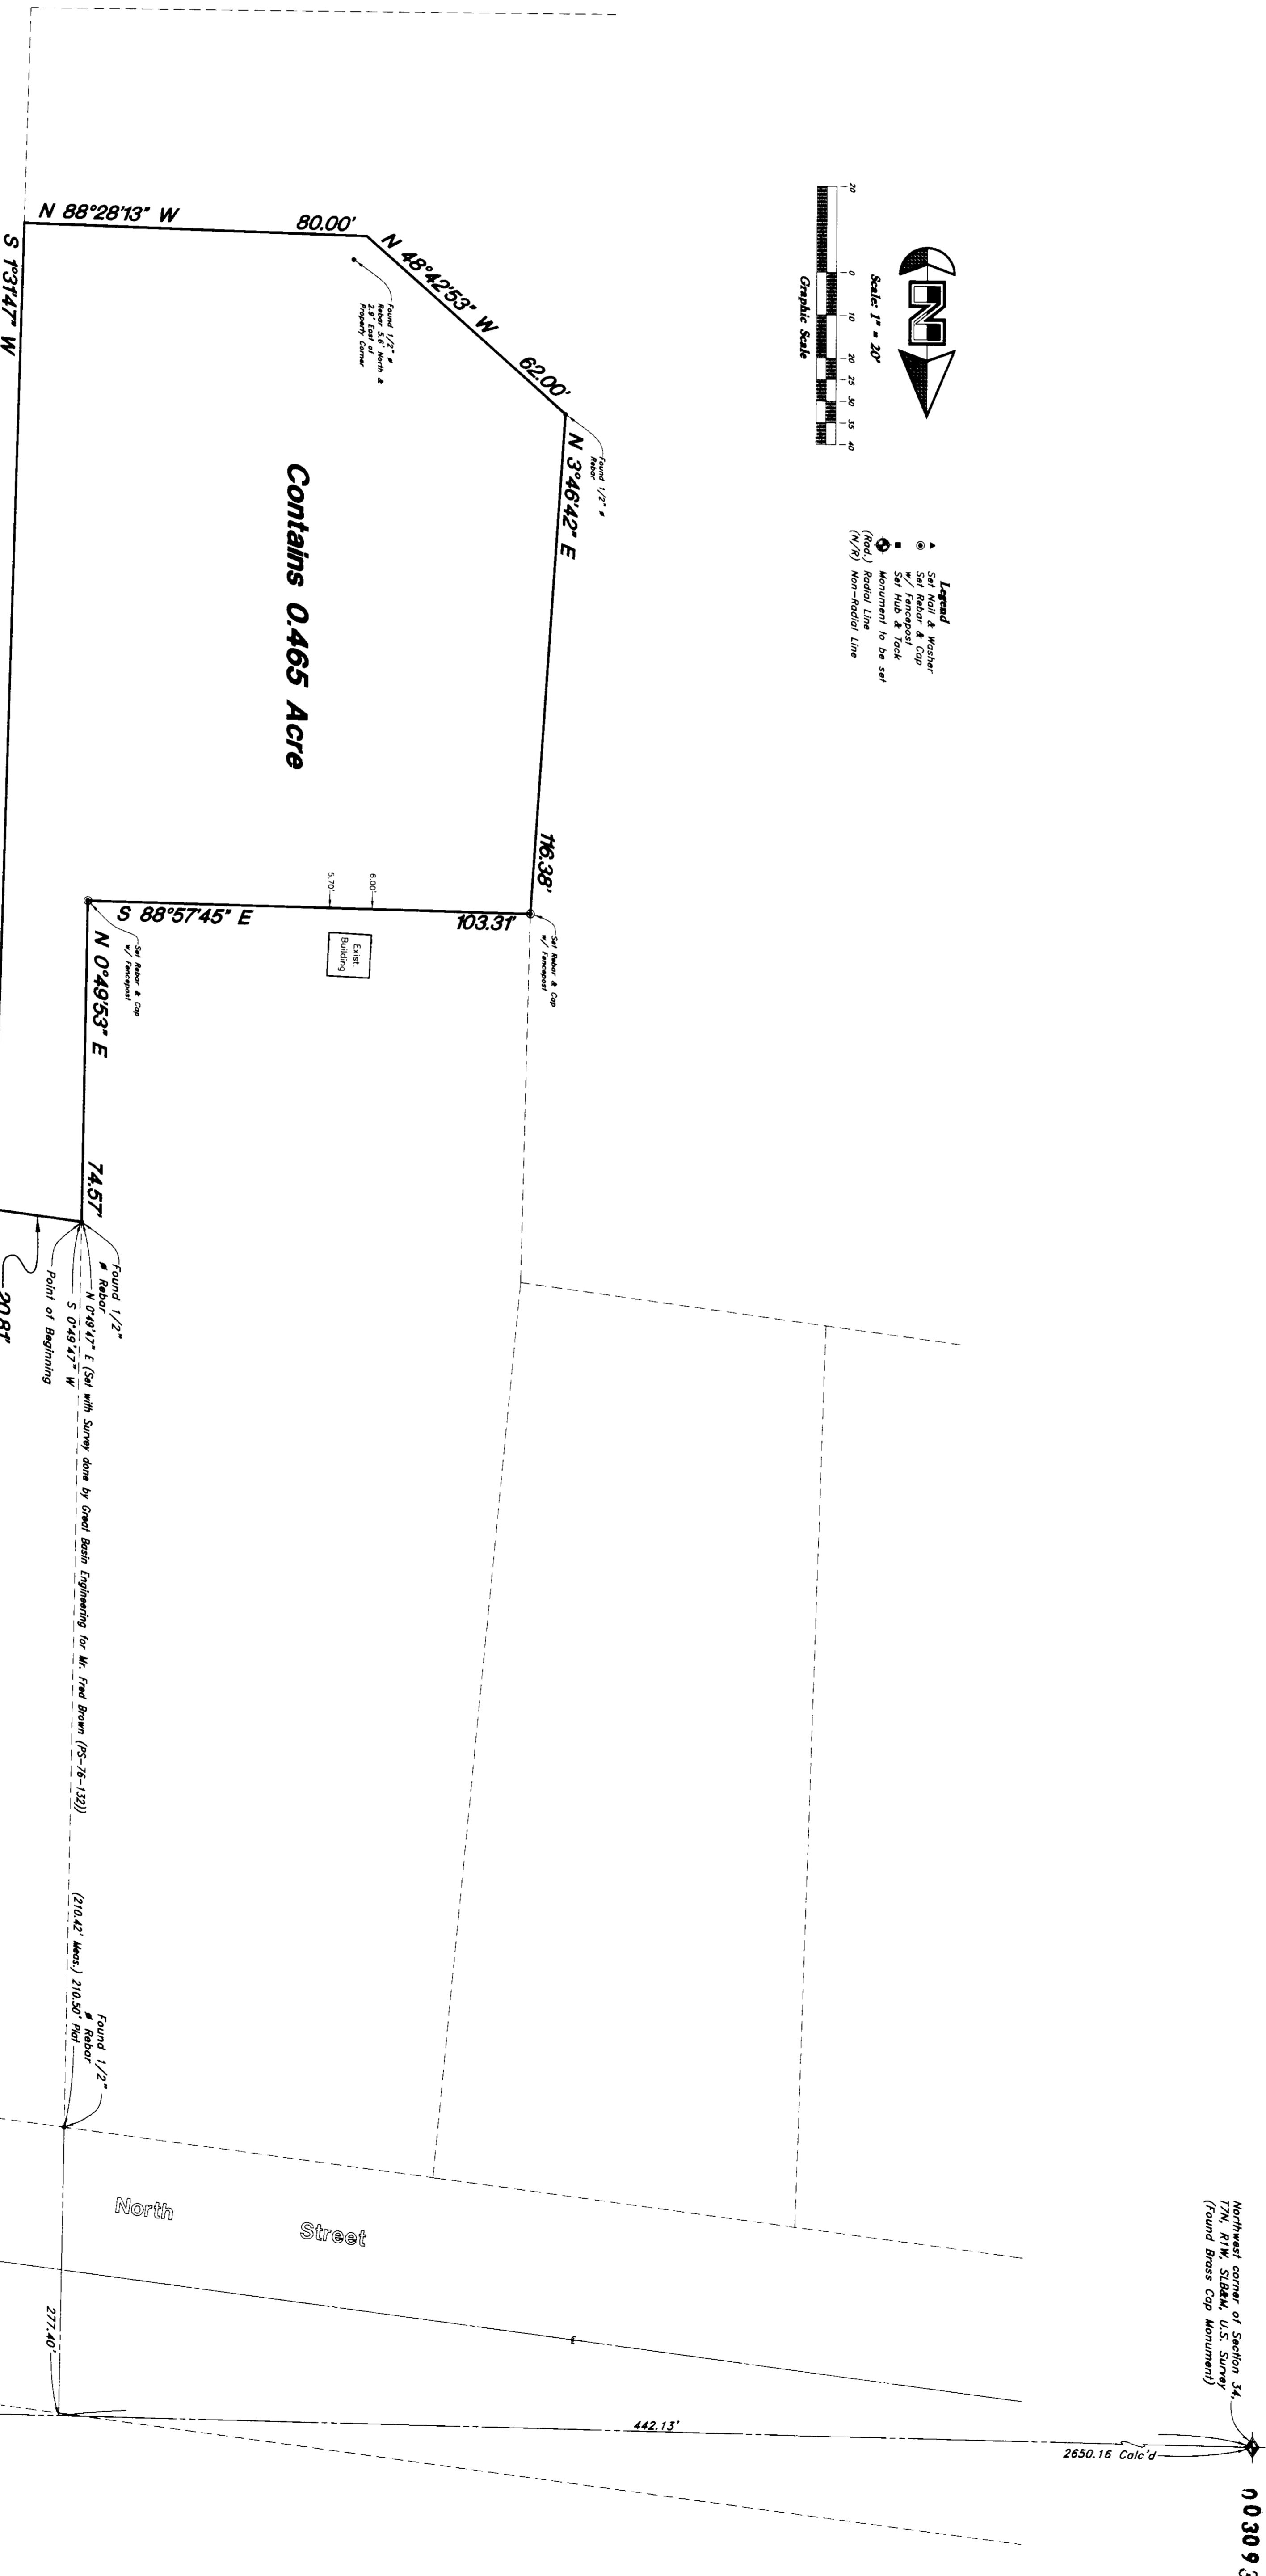


RECEIVED  
AUG 04 2003  
Weber County Surveyor

**Property Survey**

**Darlene Bates**  
A part of the Northwest 1/4 of Section 34, Township 7N, Range 1E, Section 34, T7N, R1E, S188M, U.S. Survey

SCALE: 1" = 20'  
DATE: 18 Jun, 2003  
DRAWN: AH  
REVISIONS: 03N312V  
003093  
DATE: 03N312

GREAT BASIN ENGINEERING NORTH  
5746 South 1425 East - Suite 200  
Ogden, Utah 84403 4415  
Phone: (801)384-4415 Fax: (801)384-4422 (in Utah)384-2344