


003100

003100

003100

003100

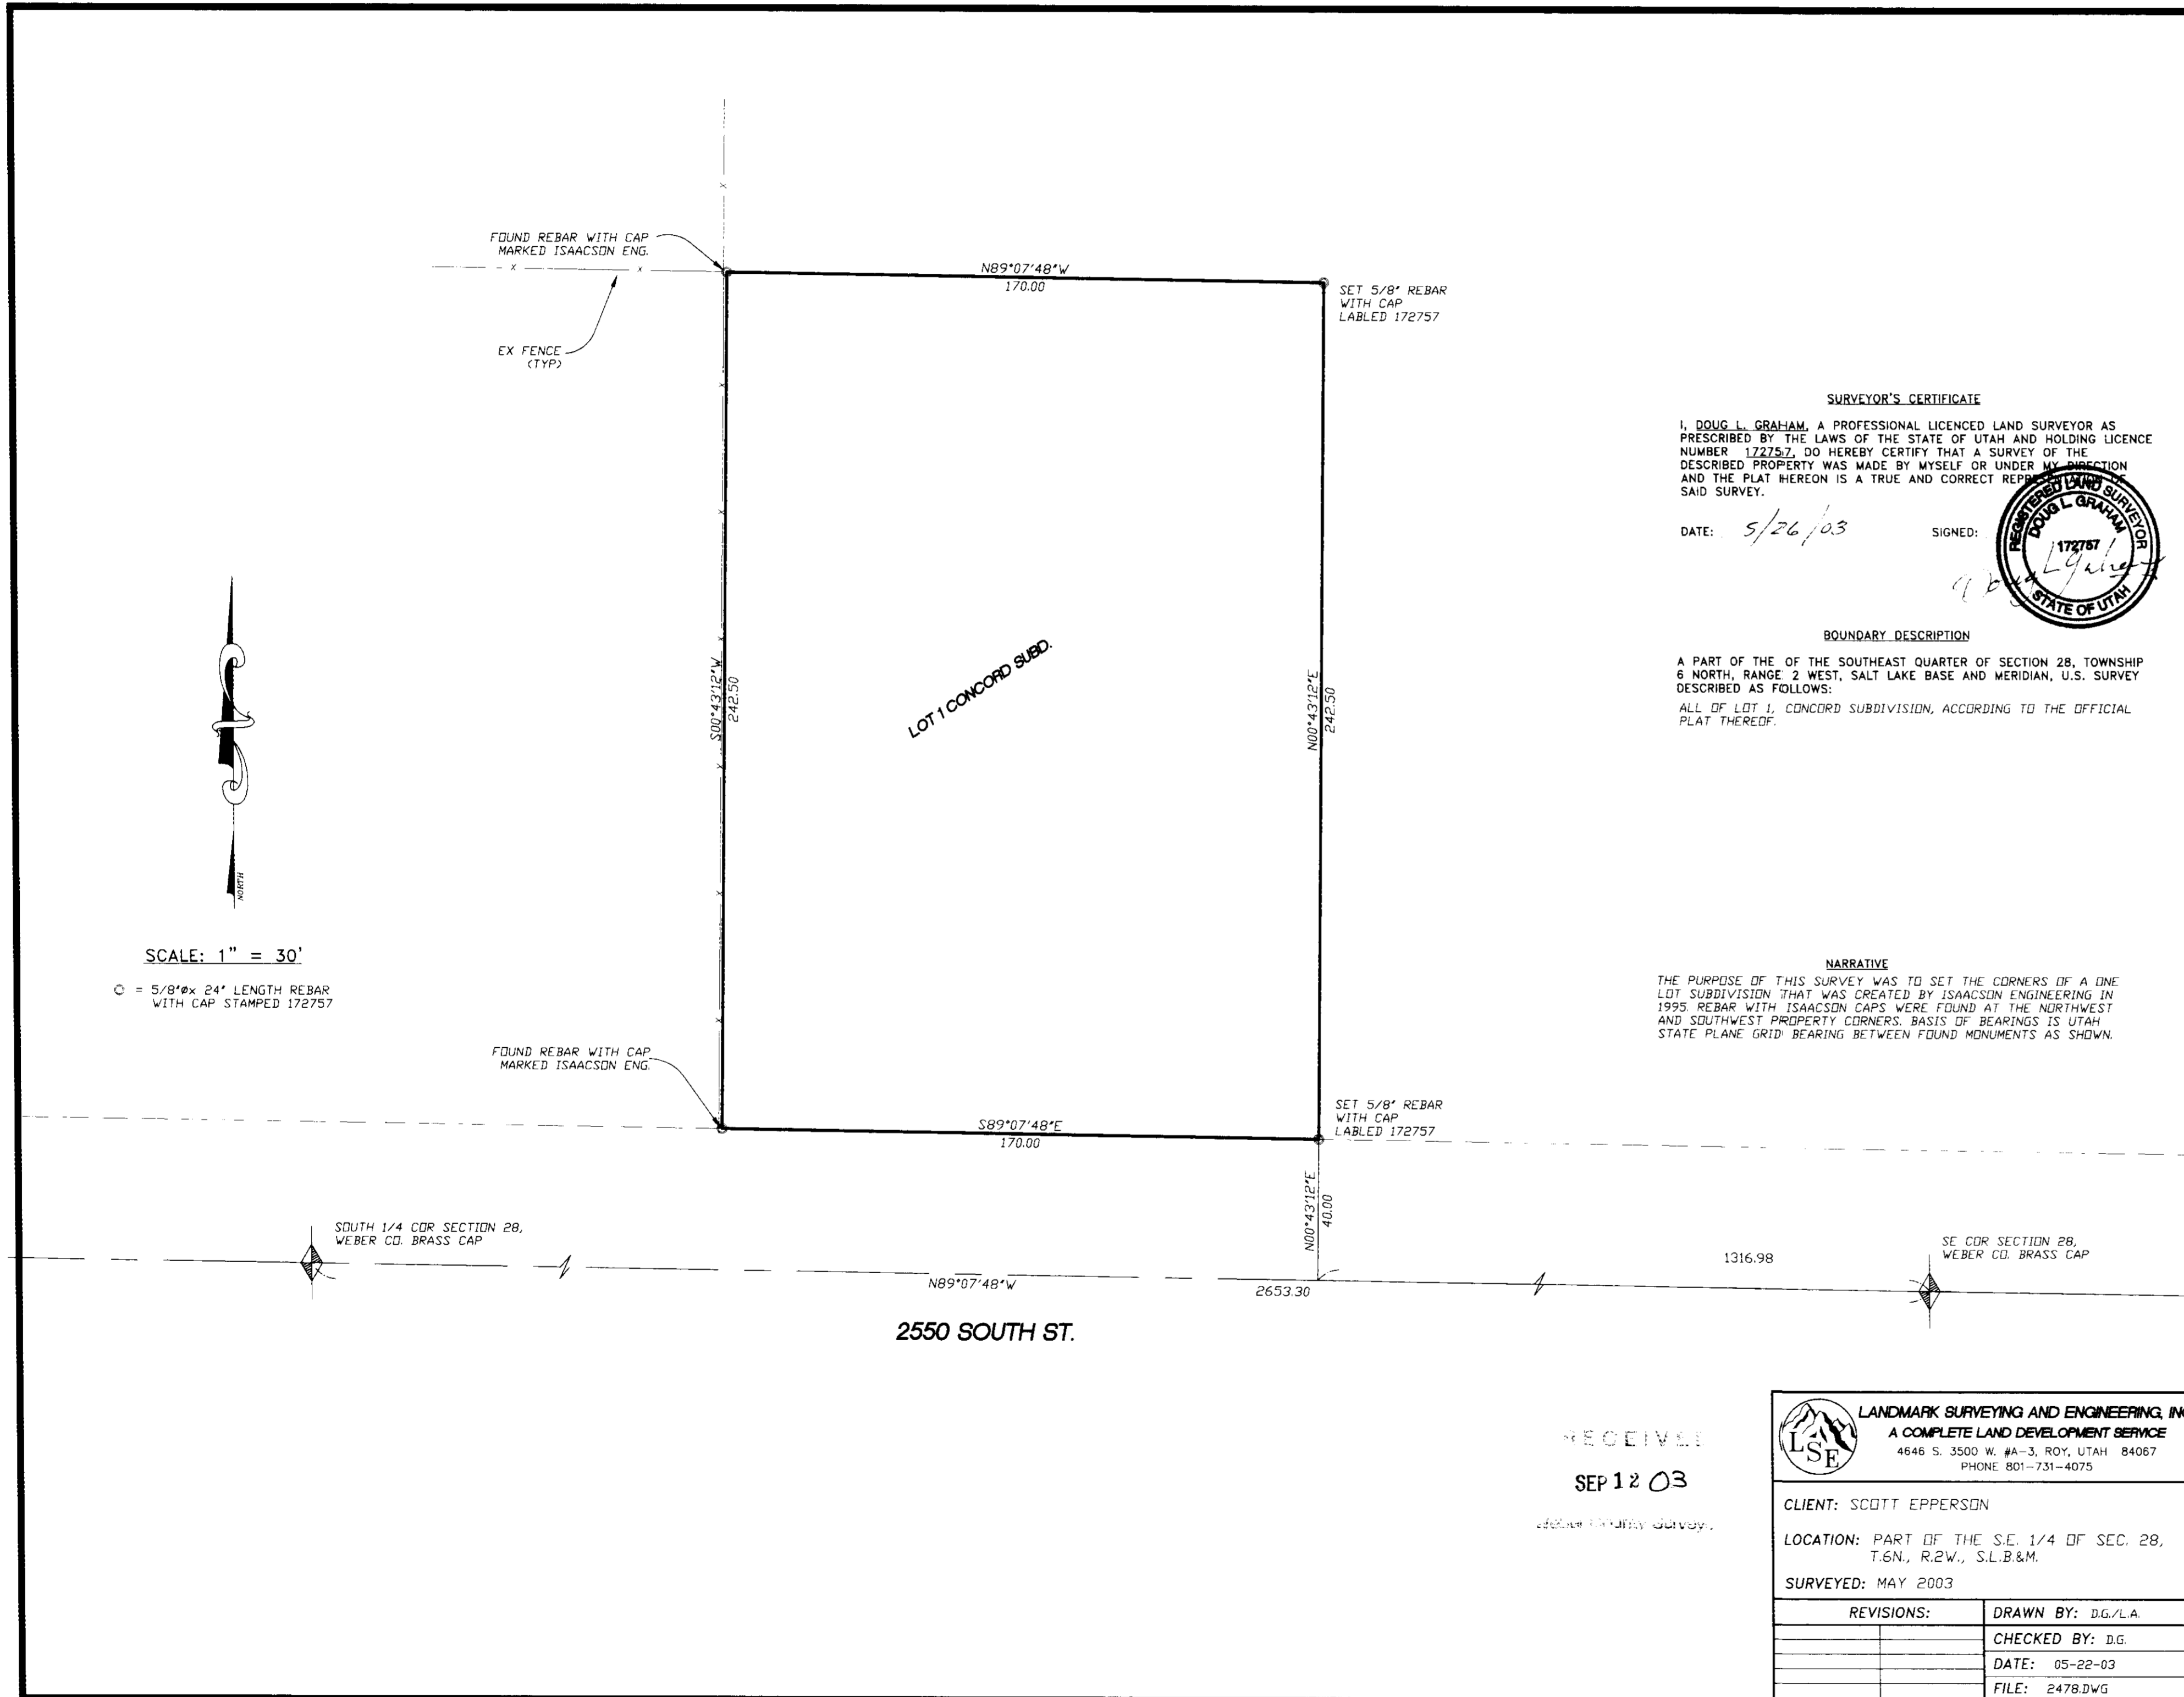

003100

003100