

003110

003110

003110

003110

**RECORD OF SURVEY**  
 PART OF THE N.W. 1/4 OF SECTION 16, T.6N., R.1W., S.L.B.&M.




**SURVEYOR'S CERTIFICATE**

I, **DALLAS K. BUTTARS**, A PROFESSIONAL LICENSED LAND SURVEYOR AS PRESCRIBED BY THE LAWS OF THE STATE OF UTAH AND HOLDING LICENSE NUMBER **167594** DO HEREBY CERTIFY THAT A SURVEY OF THE BELOW DESCRIBED PROPERTY HAS BEEN MADE BY MYSELF OR UNDER MY DIRECTION AND THE PLAT HEREON IS A TRUE AND CORRECT REPRESENTATION OF SAID SURVEY.

DATE: **2-01-02**

SIGNED

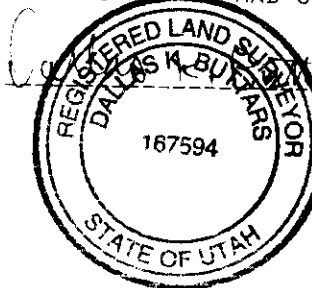

**PARCEL 1 BOUNDARY DESCRIPTION**

ALL OF LOTS 1 AND 2, BLOCK E, WM. LUND'S LYNNE ADDITION, OGDEN CITY, WEBER COUNTY, UTAH, ACCORDING TO THE OFFICIAL PLAT THEREOF.

**PARCEL 2 BOUNDARY DESCRIPTION**

ALL OF LOTS 3 AND 4, BLOCK E, WM. LUND'S LYNNE ADDITION, OGDEN CITY, WEBER COUNTY, UTAH, ACCORDING TO THE OFFICIAL PLAT THEREOF.

**PARCEL 3 BOUNDARY DESCRIPTION**

ALL OF LOTS 5, 6 AND 7, BLOCK E, WM. LUND'S LYNNE ADDITION, OGDEN CITY, WEBER COUNTY, UTAH, ACCORDING TO THE OFFICIAL PLAT THEREOF.

**NARRATIVE**

THE PURPOSE OF THIS SURVEY WAS TO SPLIT THE PARENT PARCEL INTO THREE (3) PARCELS AS SHOWN. BASIS OF BEARING IS OGDEN CITY STREET MONUMENTS BEARING.

RECEIVED

SEP 12 2003

SCALE: 1" = 20'

Webber County Clerk

5/8"X2 1/2" LENGTH REBAR WITH CAP STAMPED 167594

**LANDMARK SURVEYING AND ENGINEERING, INC.**  
 A COMPLETE LAND DEVELOPMENT SERVICE  
 4646 S. 3500 W. #A-3, ROY, UTAH 84067  
 PHONE 801-731-4075

CLIENT: **KIM BEITELSPACHER**

LOCATION: **PART OF THE N.W. 1/4 OF SEC. 16, T.6N., R.1W., S.L.B.&M.**

SURVEYED: **JAN 2002**

REVISIONS:	DRAWN BY: <b>L.A.</b>
	CHECKED BY: <b>D.B.</b>
	DATE: <b>02-01-02</b>
	FILE: <b>2350R03.DWG</b>

003110

003110