


N:\2003\03-3-129 Harrisville City\Drawings\03-3-129-CONT.dwg, 8/1/2003 3:59:43 PM, MIKEJ

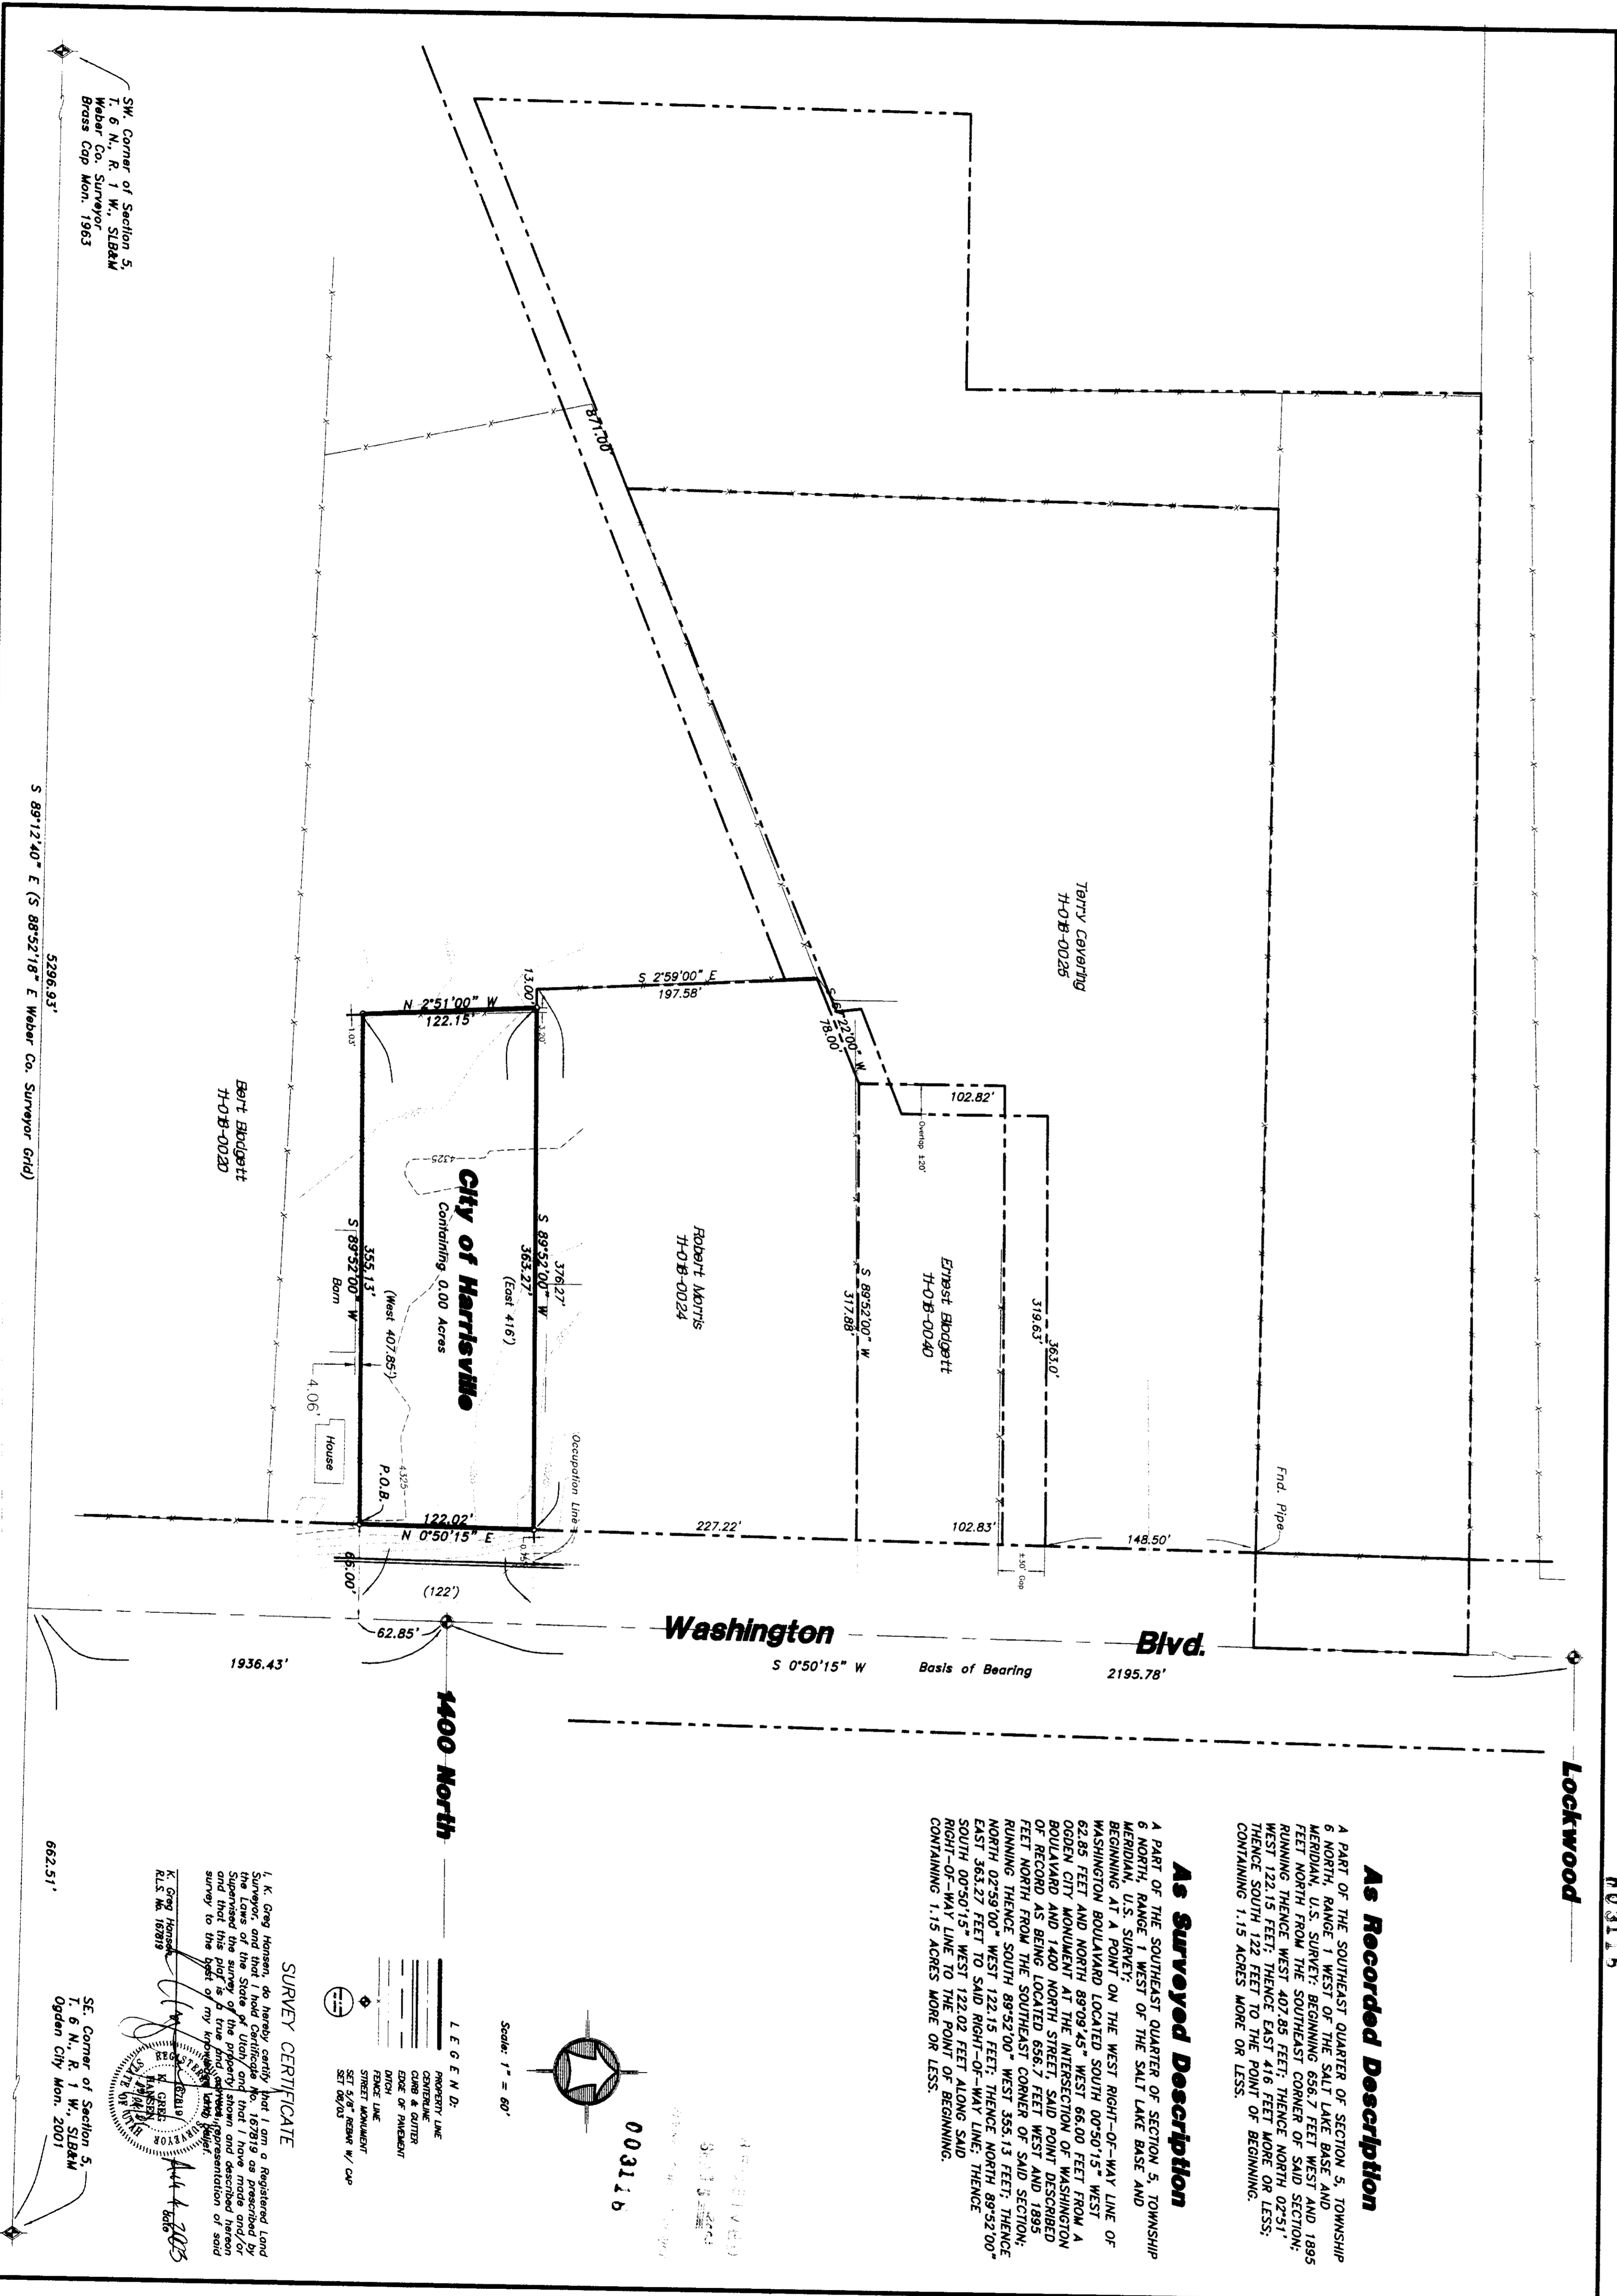

As Recorded Description


As Surveyed Description


SURVEY CERTIFICATE




PROPERTY SURVEY FOR Harrisville City ± 1400 North Washington Blvd, Harrisville, Weber County, Utah A PART OF THE SOUTHEAST QUARTER OF SECTION 5, TOWNSHIP 6 NORTH, RANGE 1 WEST, S.L.B. & M.		Drawn By: <u>Sub</u> Date: <u>08/01/03</u> Designed By: Checked By: Approved By: Scale: <u>1" = 60'</u> Drawing File: <u>03-3-129.dwg</u> JOB NUMBER: <u>03-3-129</u>	HANSEN & ASSOCIATES, INC. Consulting Engineers and Land Surveyors 538 North Main Brigham City, Utah 84302 Ogden Brigham City 723-3481 Logan 398-4905 723-8272	<table border="1"> <thead> <tr> <th>No.</th> <th>Date</th> <th>By</th> <th>Revision</th> </tr> </thead> <tbody> <tr><td> </td><td> </td><td> </td><td> </td></tr> <tr><td> </td><td> </td><td> </td><td> </td></tr> <tr><td> </td><td> </td><td> </td><td> </td></tr> <tr><td> </td><td> </td><td> </td><td> </td></tr> <tr><td> </td><td> </td><td> </td><td> </td></tr> <tr><td> </td><td> </td><td> </td><td> </td></tr> <tr><td> </td><td> </td><td> </td><td> </td></tr> <tr><td> </td><td> </td><td> </td><td> </td></tr> <tr><td> </td><td> </td><td> </td><td> </td></tr> <tr><td> </td><td> </td><td> </td><td> </td></tr> </tbody> </table>	No.	Date	By	Revision	
No.	Date	By	Revision	