


**SURVEYS WARRANT AND DISCLAIMER**



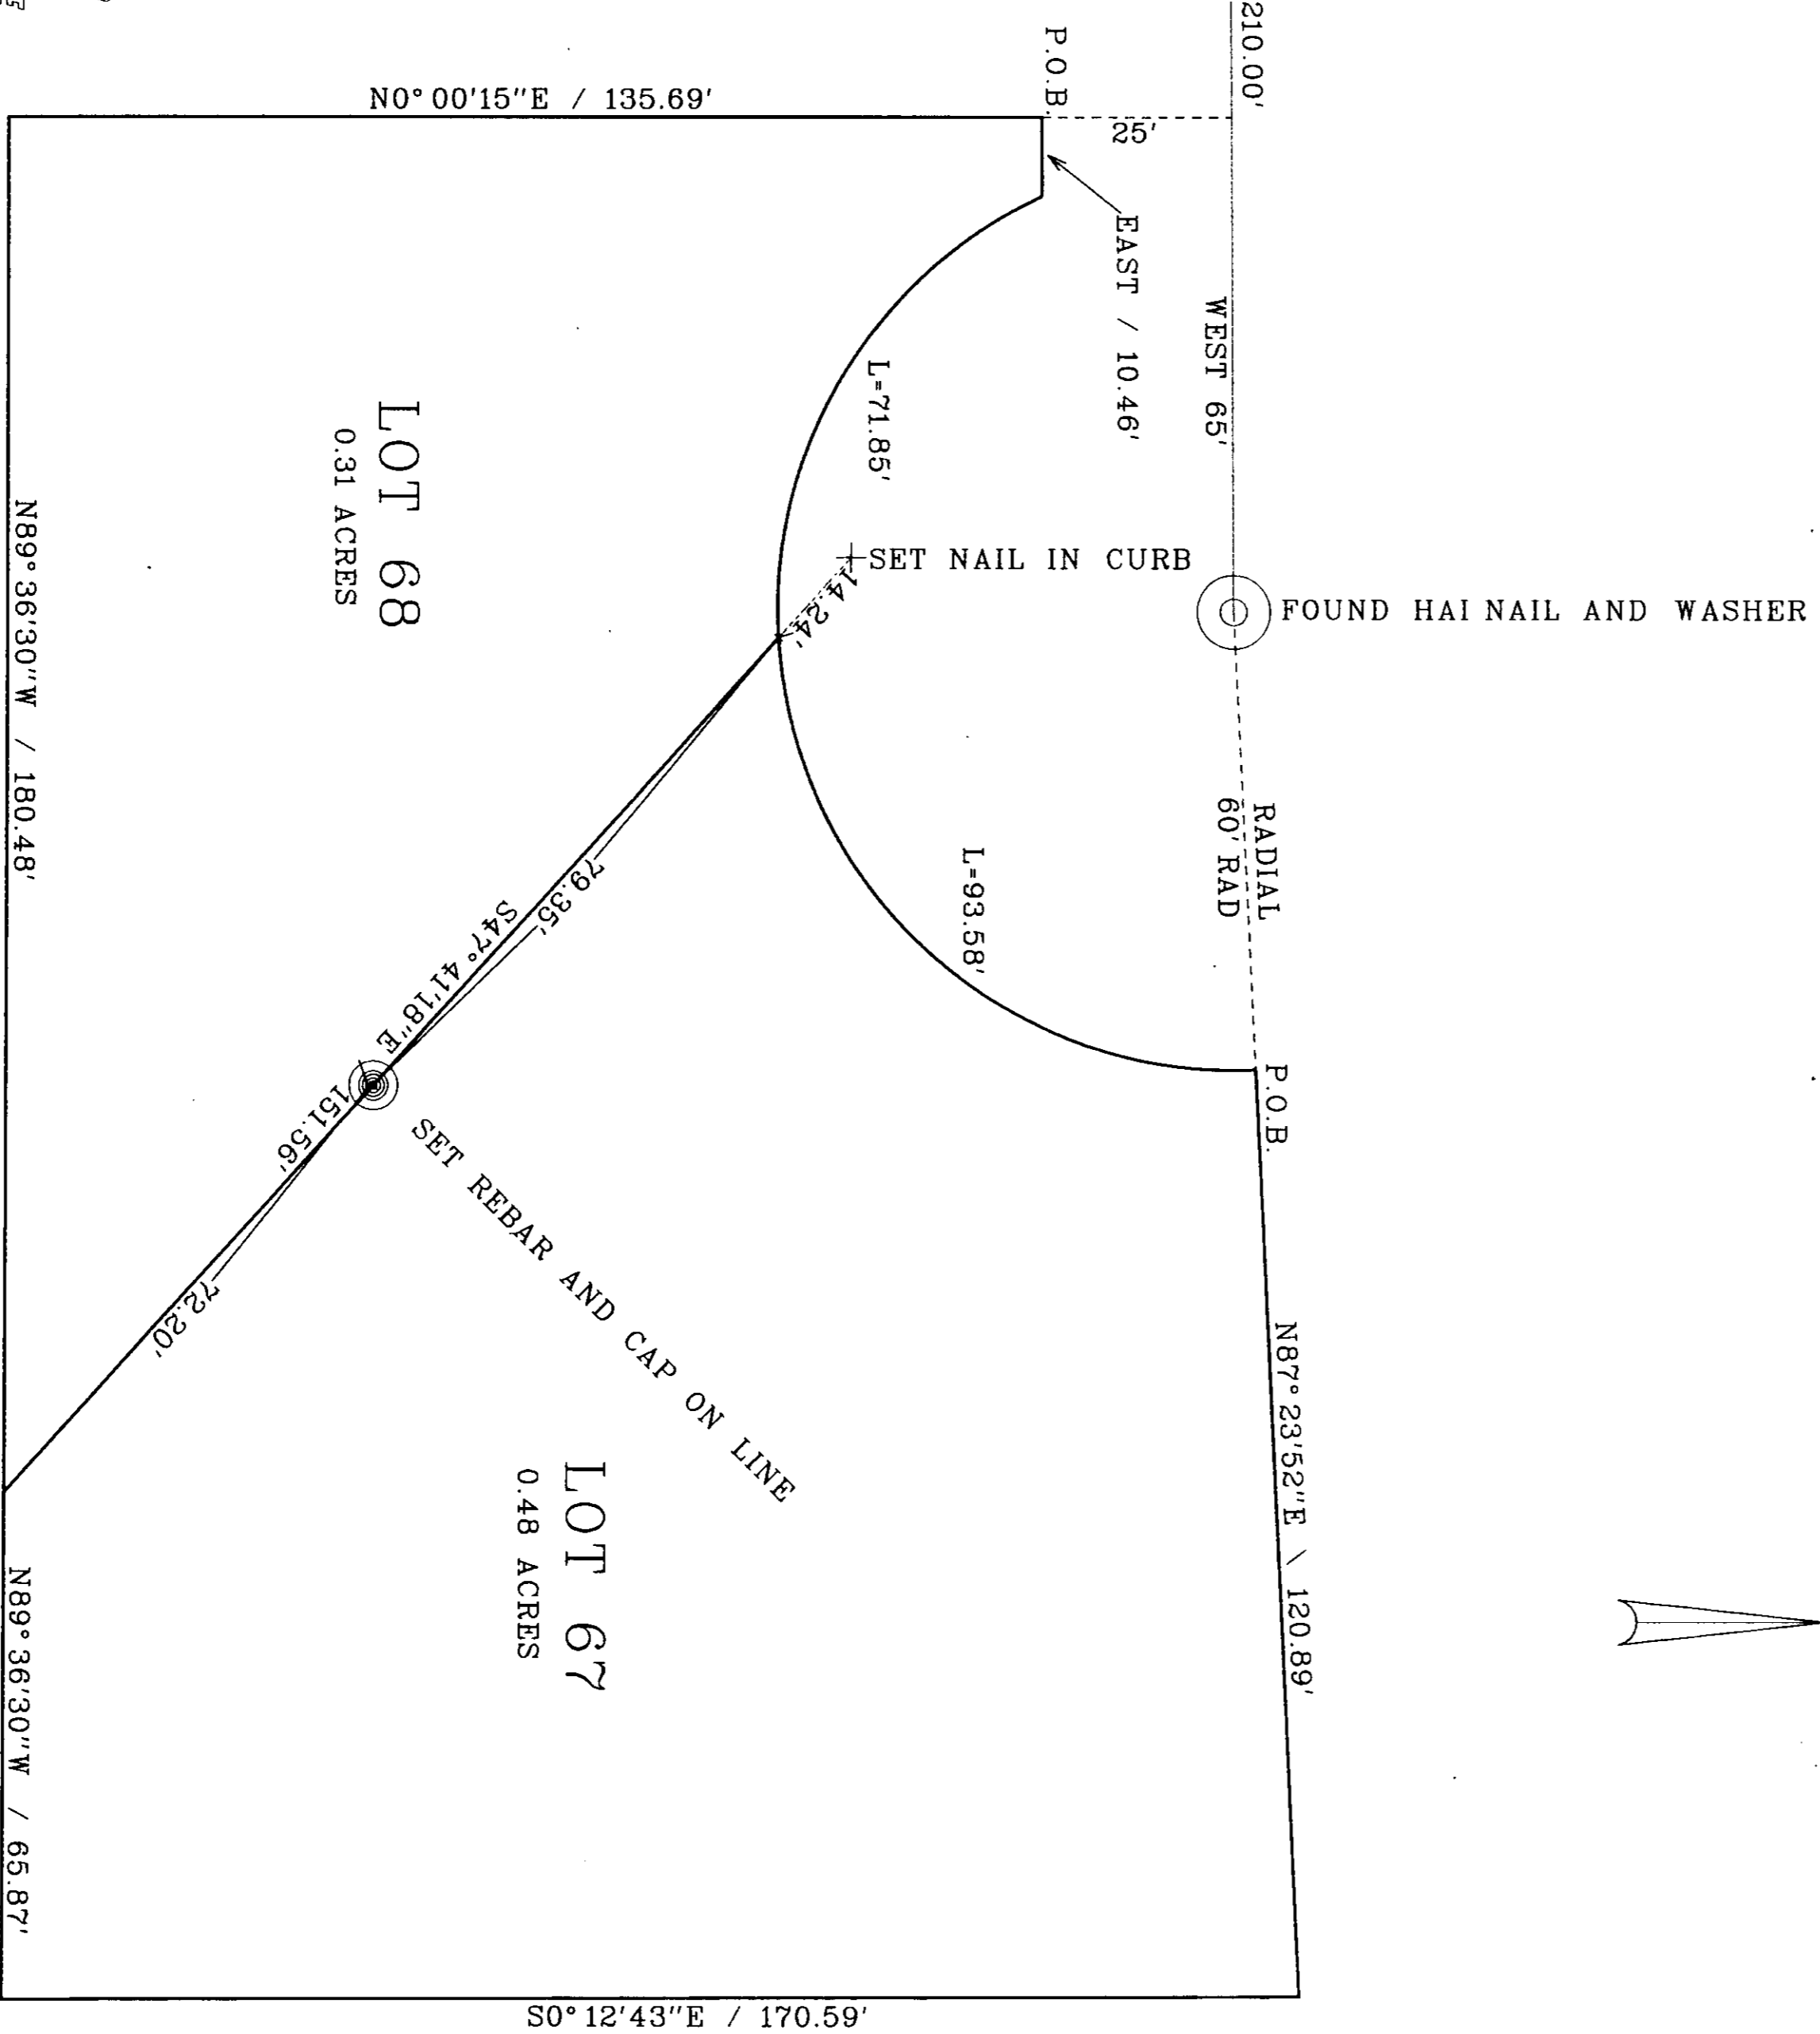

SCALE: 1"=20'

**CHRIS-CORP**  
STAKING-CONTRACT SURVEYS  
2779 E. 2450 N. LAYTON, UTAH 84040  
801-544-6536

003133

**SURVEYOR'S CERTIFICATE**

I, Ryan B. Christensen, do hereby certify that I am a Registered Land Surveyor and that I hold Certificate No. 30663 as presented by the laws of the State of Utah, and that I have conducted a survey on the ground as shown hereon.

DATE: 02/24/12

**RYAN B. CHRISTENSEN**

REGISTERED PROFESSIONAL LAND SURVEYOR  
STATE OF UTAH  
NO. 30663  
EXPIRES 12/31/13

**REARSD BOUNDARY DESCRIPTION FOR LOT 67 OF EASTWOOD SUBDIVISION NO. 5, WEBER COUNTY, UTAH**



CONTAINS 0.48 ACRES

**REARSD BOUNDARY DESCRIPTION FOR LOT 68 OF EASTWOOD SUBDIVISION NO. 5, WEBER COUNTY, UTAH**



CONTAINS 0.31 ACRES

RECEIVED  
OCT 30 2012  
Weber County Survey

RECORD OF SURVEY FOR:  
JIM DIAMOND  
ALL OF LOTS 67 AND 68, EASTWOOD  
SUBDIVISION NO. 5, WEBER COUNTY  
UTAH

003133