
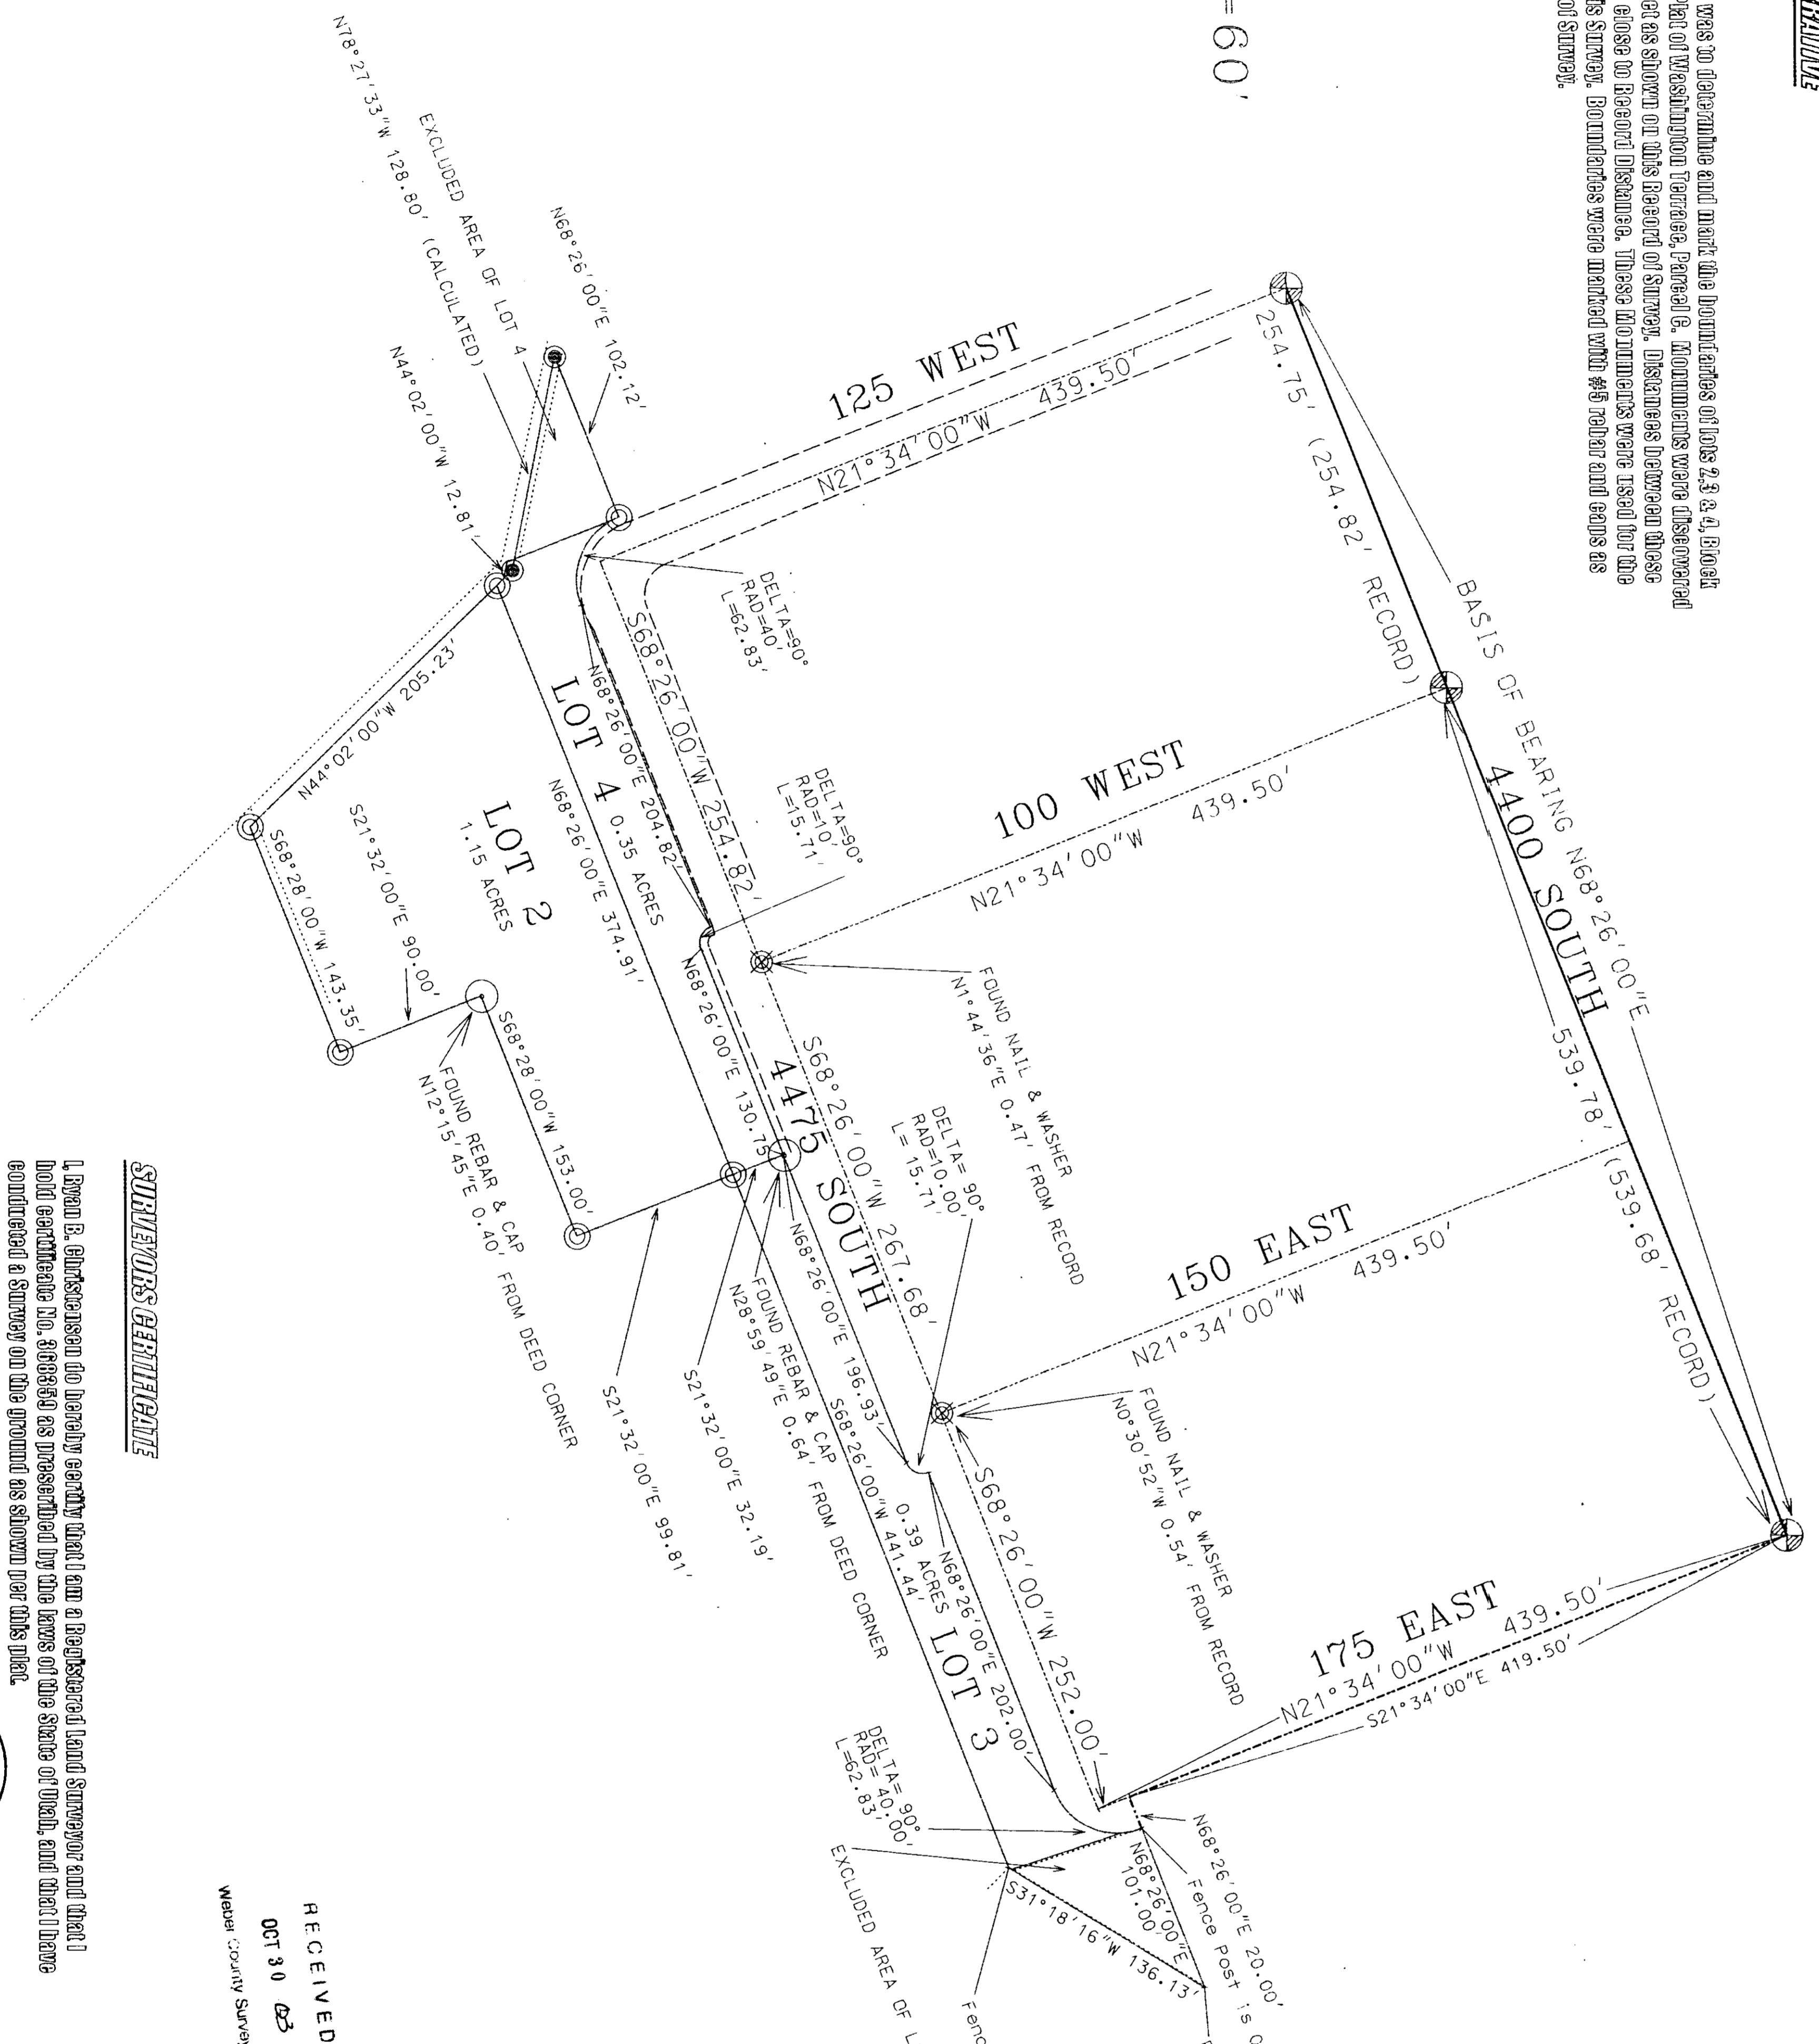





SCALE: 1" = 60'

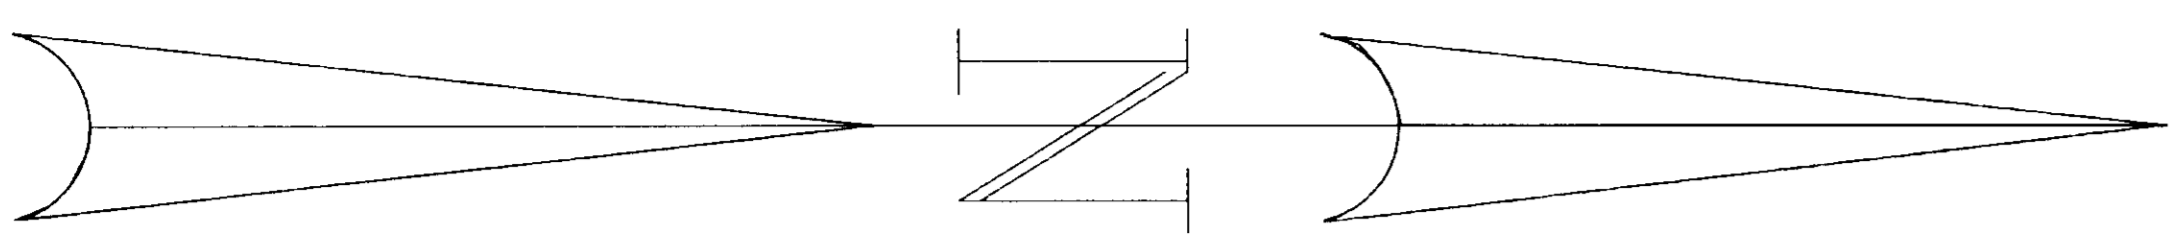





RECEIVED  
OCT 30 03  

**LEGEND**

- FOUND OCTAGON SHARDED BRASS DISK WITH PINCH MARK
- ⊗ FOUND NAIL AND WASHER
- ⊙ FOUND REBAR AND CAP SET BY REVE & REVE
- ⊙ SET #8 REBAR AND CAP MARKED CHRIS-CORP
- SET MAG NAIL
- ..... CHAIN LINK FENCE
- TOP BACK OF CURB

**DESCRIPTION OF PROPERTIES**

ALL OF LOT 2, Block 9, Parcel B, Amended Plat, Washington Terrace, Weber County, Utah, DEPENDS UPON THE ORIGINAL PLAT THEREON.


ALL OF LOT 3, Block 9, Parcel B, Amended Plat, Washington Terrace, Weber County, Utah, DEPENDS UPON THE ORIGINAL PLAT THEREON.



**RECORD OF SURVEY FOR**

**THE LDS CHURCH**  
LOT 2 AS WELL AS A PORTION OF LOTS 3 & 4  
OF BLOCK NO. 9, AMENDED PLAT OF  
WASHINGTON TERRACE - PARCEL C

003134  
CHRIS-CORP  
CONSTRUCTION STAKING \* CONTRACT SURVEYS  
2779 E. 2450 N. LAYTON, UT. 84040  
PHONE: 801-544-6526 \* FAX: 801-544-6539

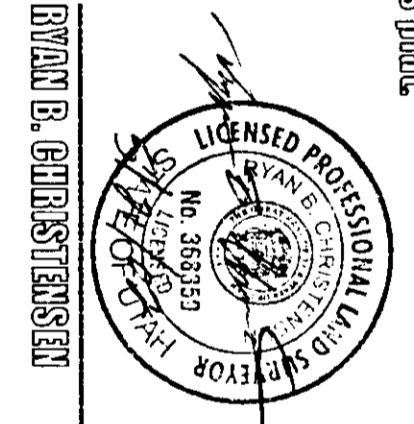

DATE

003134