

BOUNDARY DESCRIPTION


NARRATIVE


LEGEND

- FOUND WEIR COUNTY MONUMENT TO BE SET AFTER ROAD CONSTRUCTION
STREET MONUMENTS TO BE SET AFTER ROAD CONSTRUCTION
FOUND REBAR AND CAP WITH LABELS AS SHOWN BELOW


MIDLAND BUSINESS PARK
Record of Survey Map
PART OF SECTION 36 TOWNSHIP 6 NORTH, RANGE 2 WEST,
SALT LAKE BASE AND MERIDIAN, WEBER COUNTY, UTAH
DECEMBER 1995

SURVEYOR'S CERTIFICATE

I, Ernest D. Rowley, do hereby certify that I am a registered land surveyor in the State of Utah and hold certificate number 88-11781-2201...

BASIS OF BEARING

The basis of bearing is as contained in the boundary description.
N 00°17'06" E 2624.58' record
S 89°08'07" E 2846.00' record

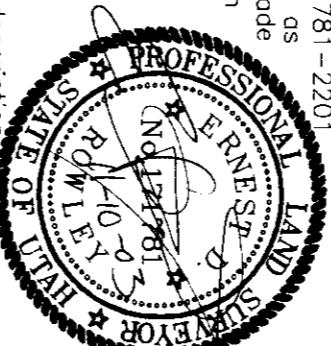

NARRATIVE (Continued A)







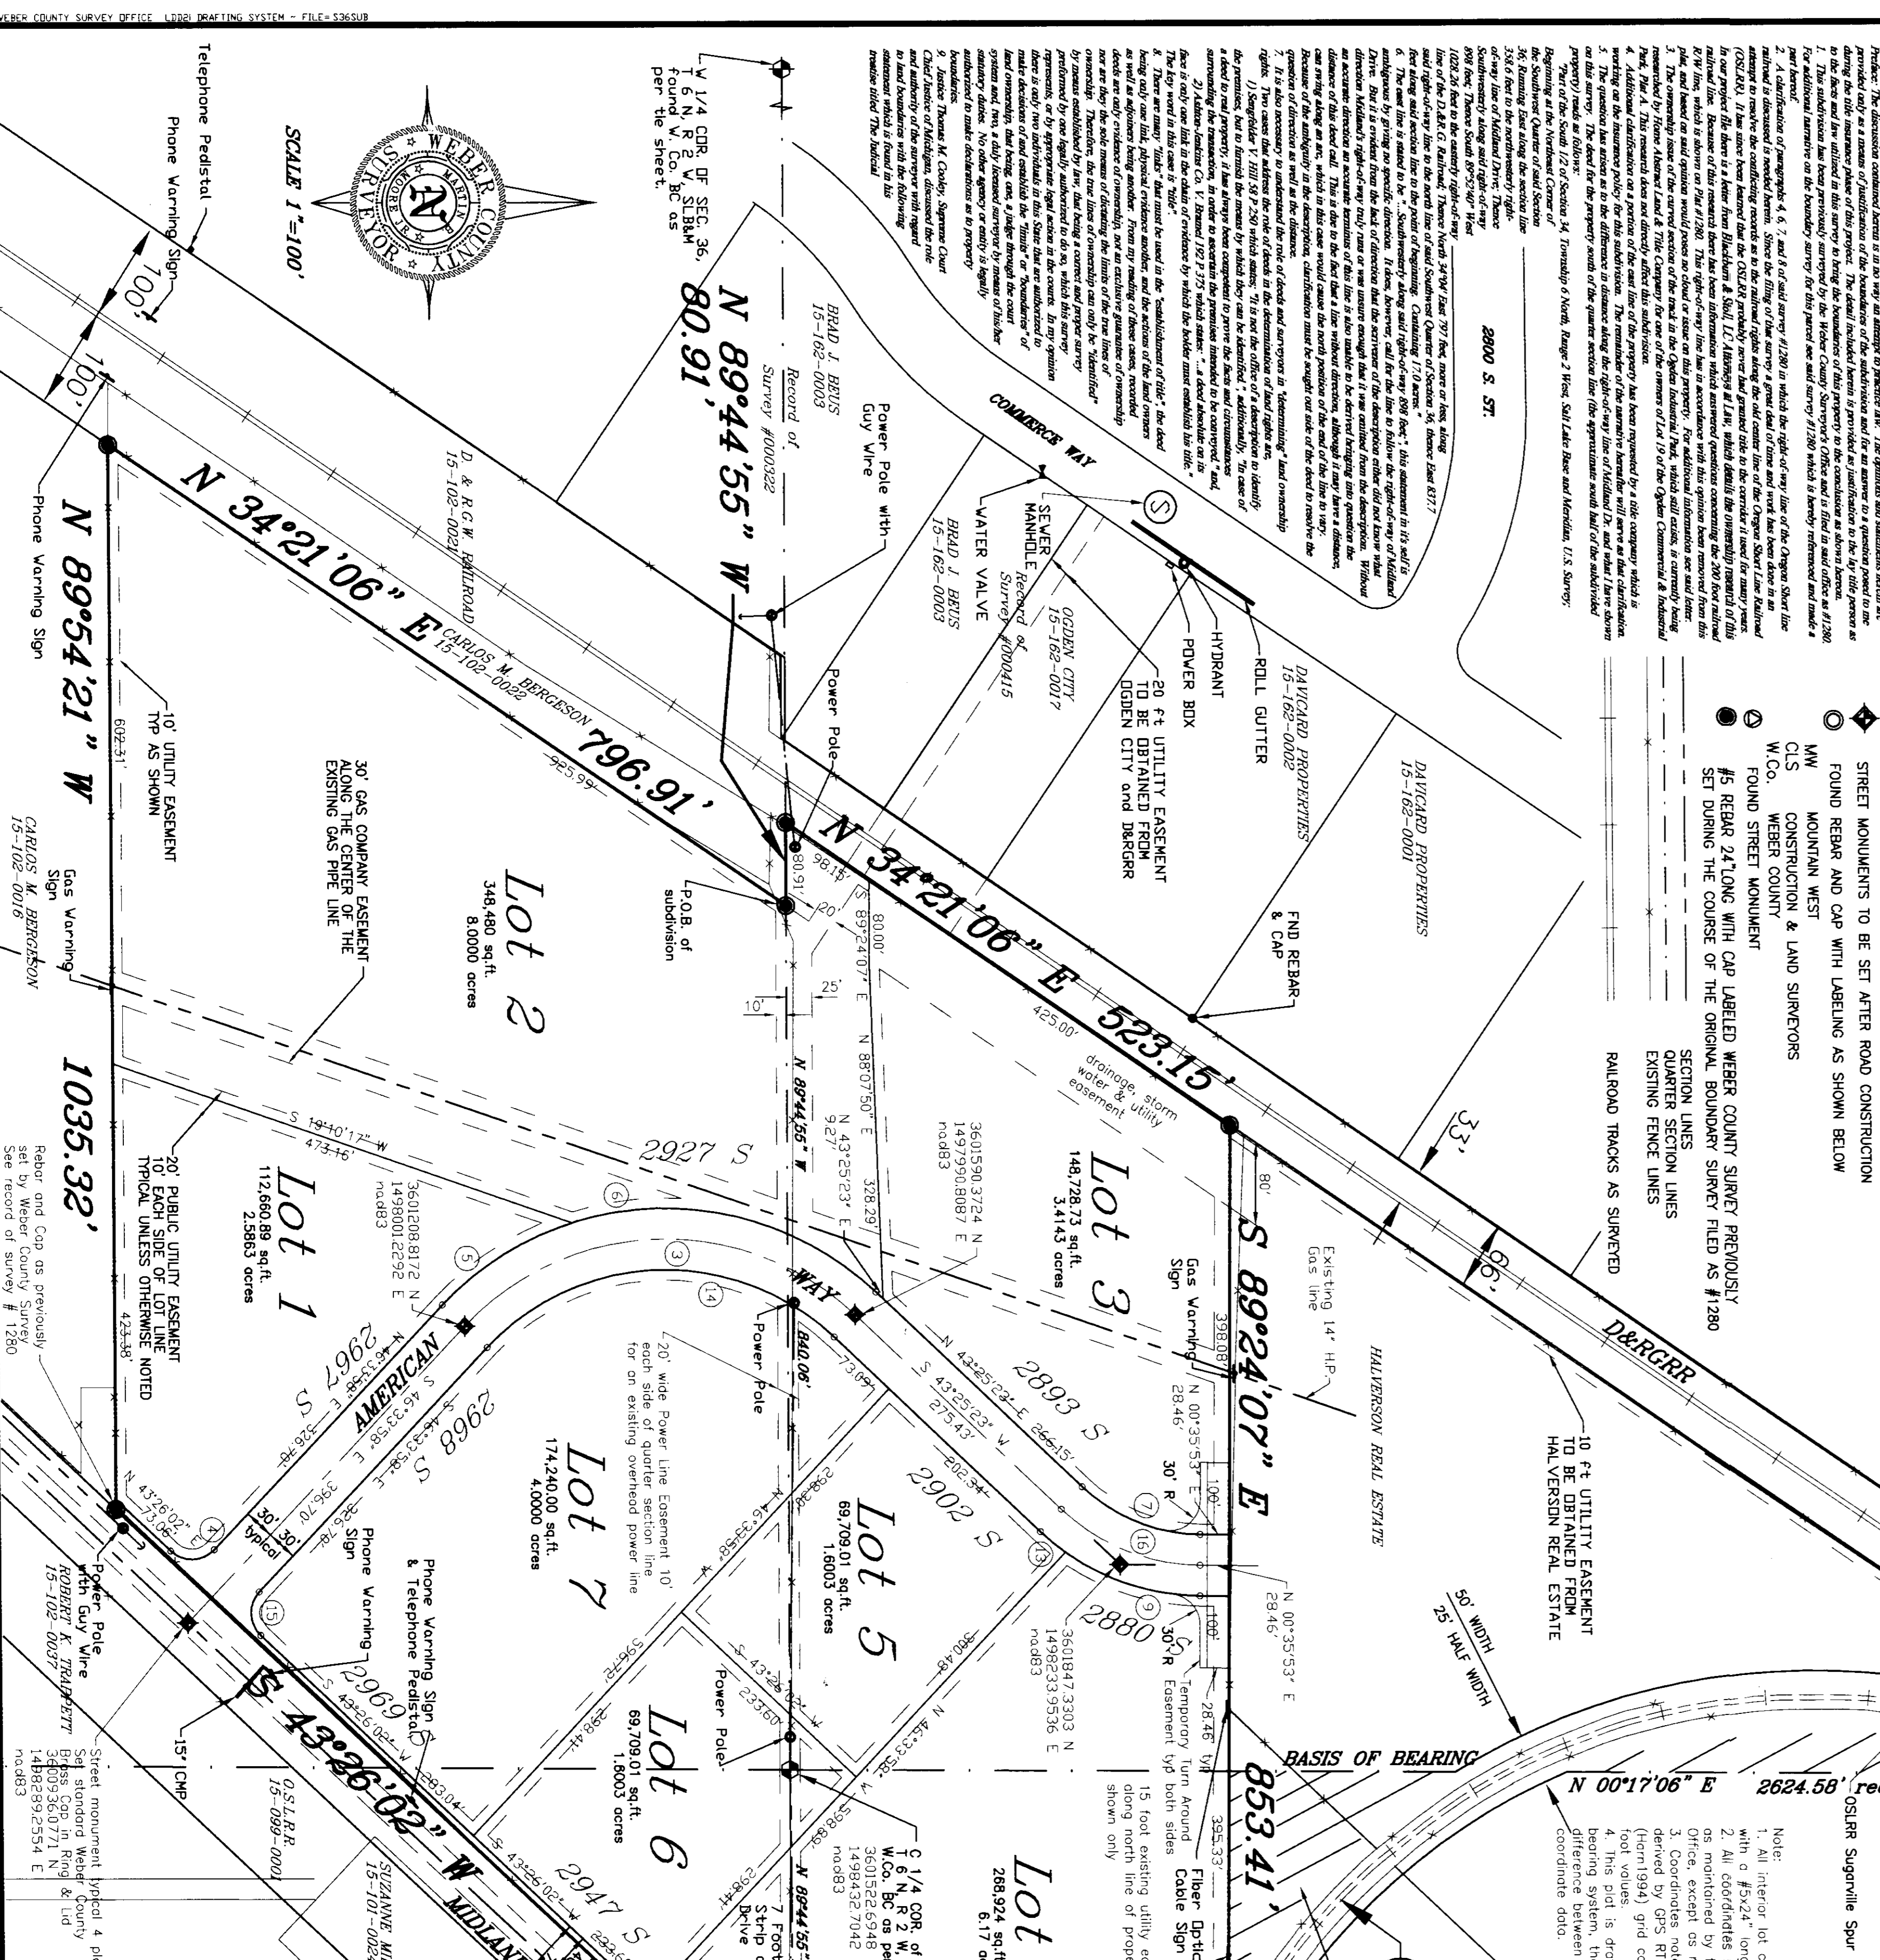




