


PLAN HOLD CORPORATION • IRVINE, CALIFORNIA
REORDER BY NUMBER 075AR

PLAN HOLD CORPORATION • IRVINE, CALIFORNIA
REORDER BY NUMBER 075AR

PLAN HOLD CORPORATION • IRVINE, CALIFORNIA
REORDER BY NUMBER 075AR

PLAN HOLD CORPORATION • IRVINE, CALIFORNIA
REORDER BY NUMBER 075AR

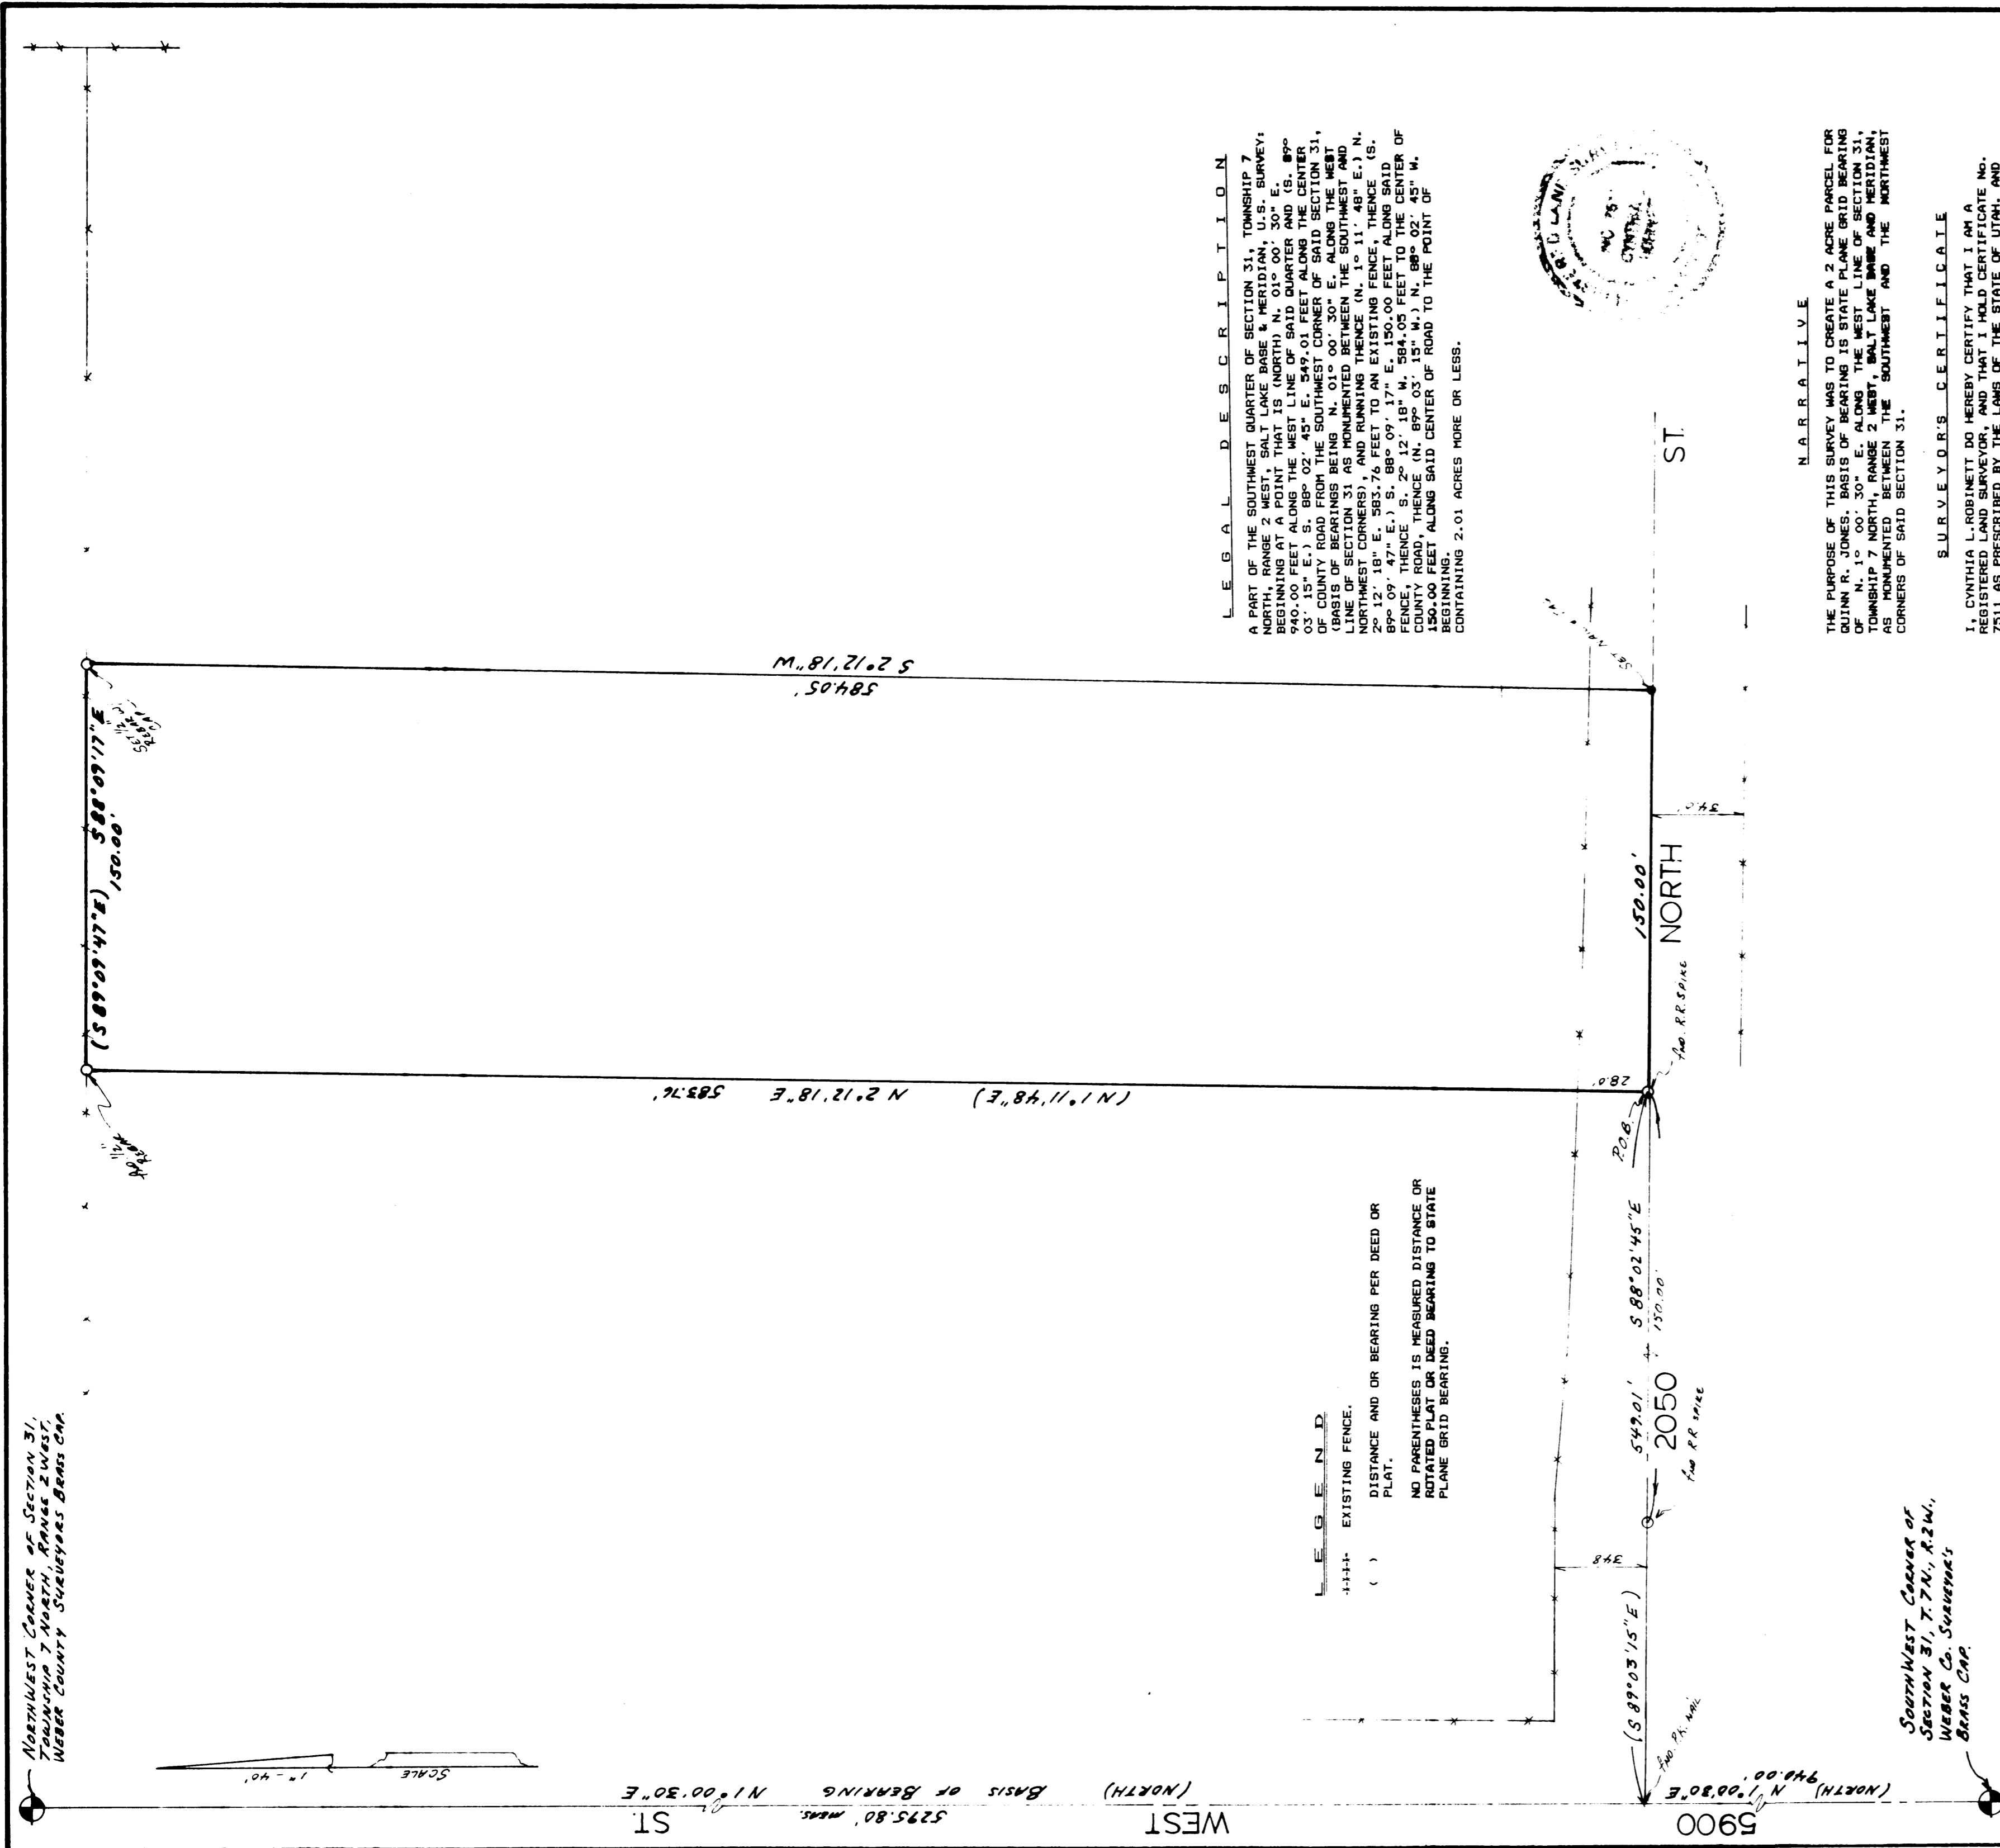

L E G A L D E S C R I P T I O N

A PART OF THE SOUTHWEST QUARTER OF SECTION 31, TOWNSHIP 7 NORTH, RANGE 2 WEST, SALT LAKE MERIDIAN, U.S. SURVEY, BEING A POINT THAT IS (NORTH) N. 01° 00' 30" E. 940.00 FEET ALONG THE WEST LINE OF SAID QUARTER AND (S. 

L E G E N D

- - - - - EXISTING FENCE.

() DISTANCE AND OR BEARING PER DEED OR PLAT.

NO PARENTHESES IS MEASURED DISTANCE OR ROTATED PLAT OR DEED BEARING TO STATE PLANE GRID BEARING.



NARRATIVE

THE PURPOSE OF THIS SURVEY WAS TO CREATE A 2 ACRE PARCEL FOR GUNN R. JONES. BASIS OF BEARING IS STATE PLANE GRID BEARING OF N. 1° 00' 30" E. ALONG THE WEST LINE OF SECTION 31, TOWNSHIP 7 NORTH, RANGE 2 WEST, SALT LAKE MERIDIAN, AND MONUMENTED BETWEEN THE SOUTHWEST AND THE NORTHWEST CORNERS OF SAID SECTION 31.

SURVEYOR'S CERTIFICATE


01-12-70 DATE
Cynthia L. Robinson
CYNTHIA L. ROBINETT R.L.S. No. 7811

SOUTHWEST CORNER OF SECTION 31, T.7N., R.2W., WEBER CO. SURVEYOR'S BRASS CAP.

RECEIVED
MAR 09 1990
Weber County Surveyor

CONSTRUCTION & LAND SURVEYORS INC.	
1500 N. 6900 W. OGDEN, UTAH 84404 (801) 731-1131	
CLIENT: GUNN R. JONES	
SURVEY LOCATION: S.W. 1/4 SEC. 31, TOWNSHIP 7 NORTH, RANGE 2 WEST, SALT LAKE BASE & MERIDIAN.	
SURVEY DATE: 01-9-90	
JOB No.	P.S.90-01