


**LEGEND**

- ◆ Found Monument

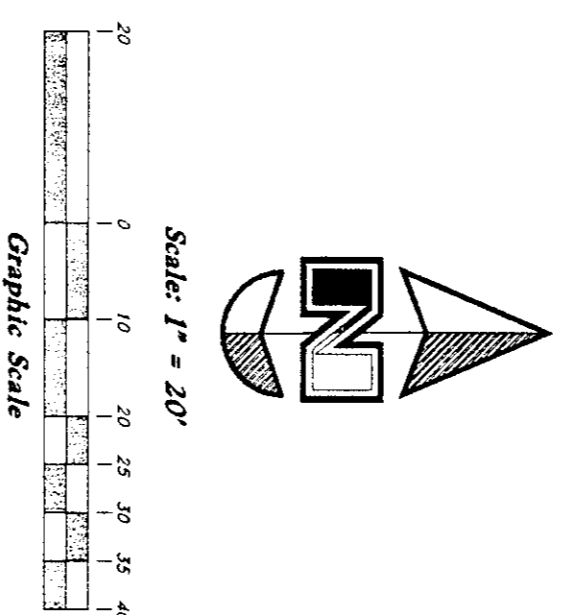

**BOUNDARY DESCRIPTION**

All of Lot 39, Greystone Estates Subdivision - Phase 5, North Ogden City, Weber County, Utah according to the official plat thereof.

**SURVEYOR'S CERTIFICATE**

I, Gary L. Newman, do hereby certify that I am a Registered Professional Surveyor in the State of Utah, and I have made a survey of the above described property, I further certify that the above plat correctly shows the true dimensions of the property surveyed.


Date: 12-10-2003

*Gary L. Newman*  
GARY L. NEWMAN

**NARRATIVE**

003152



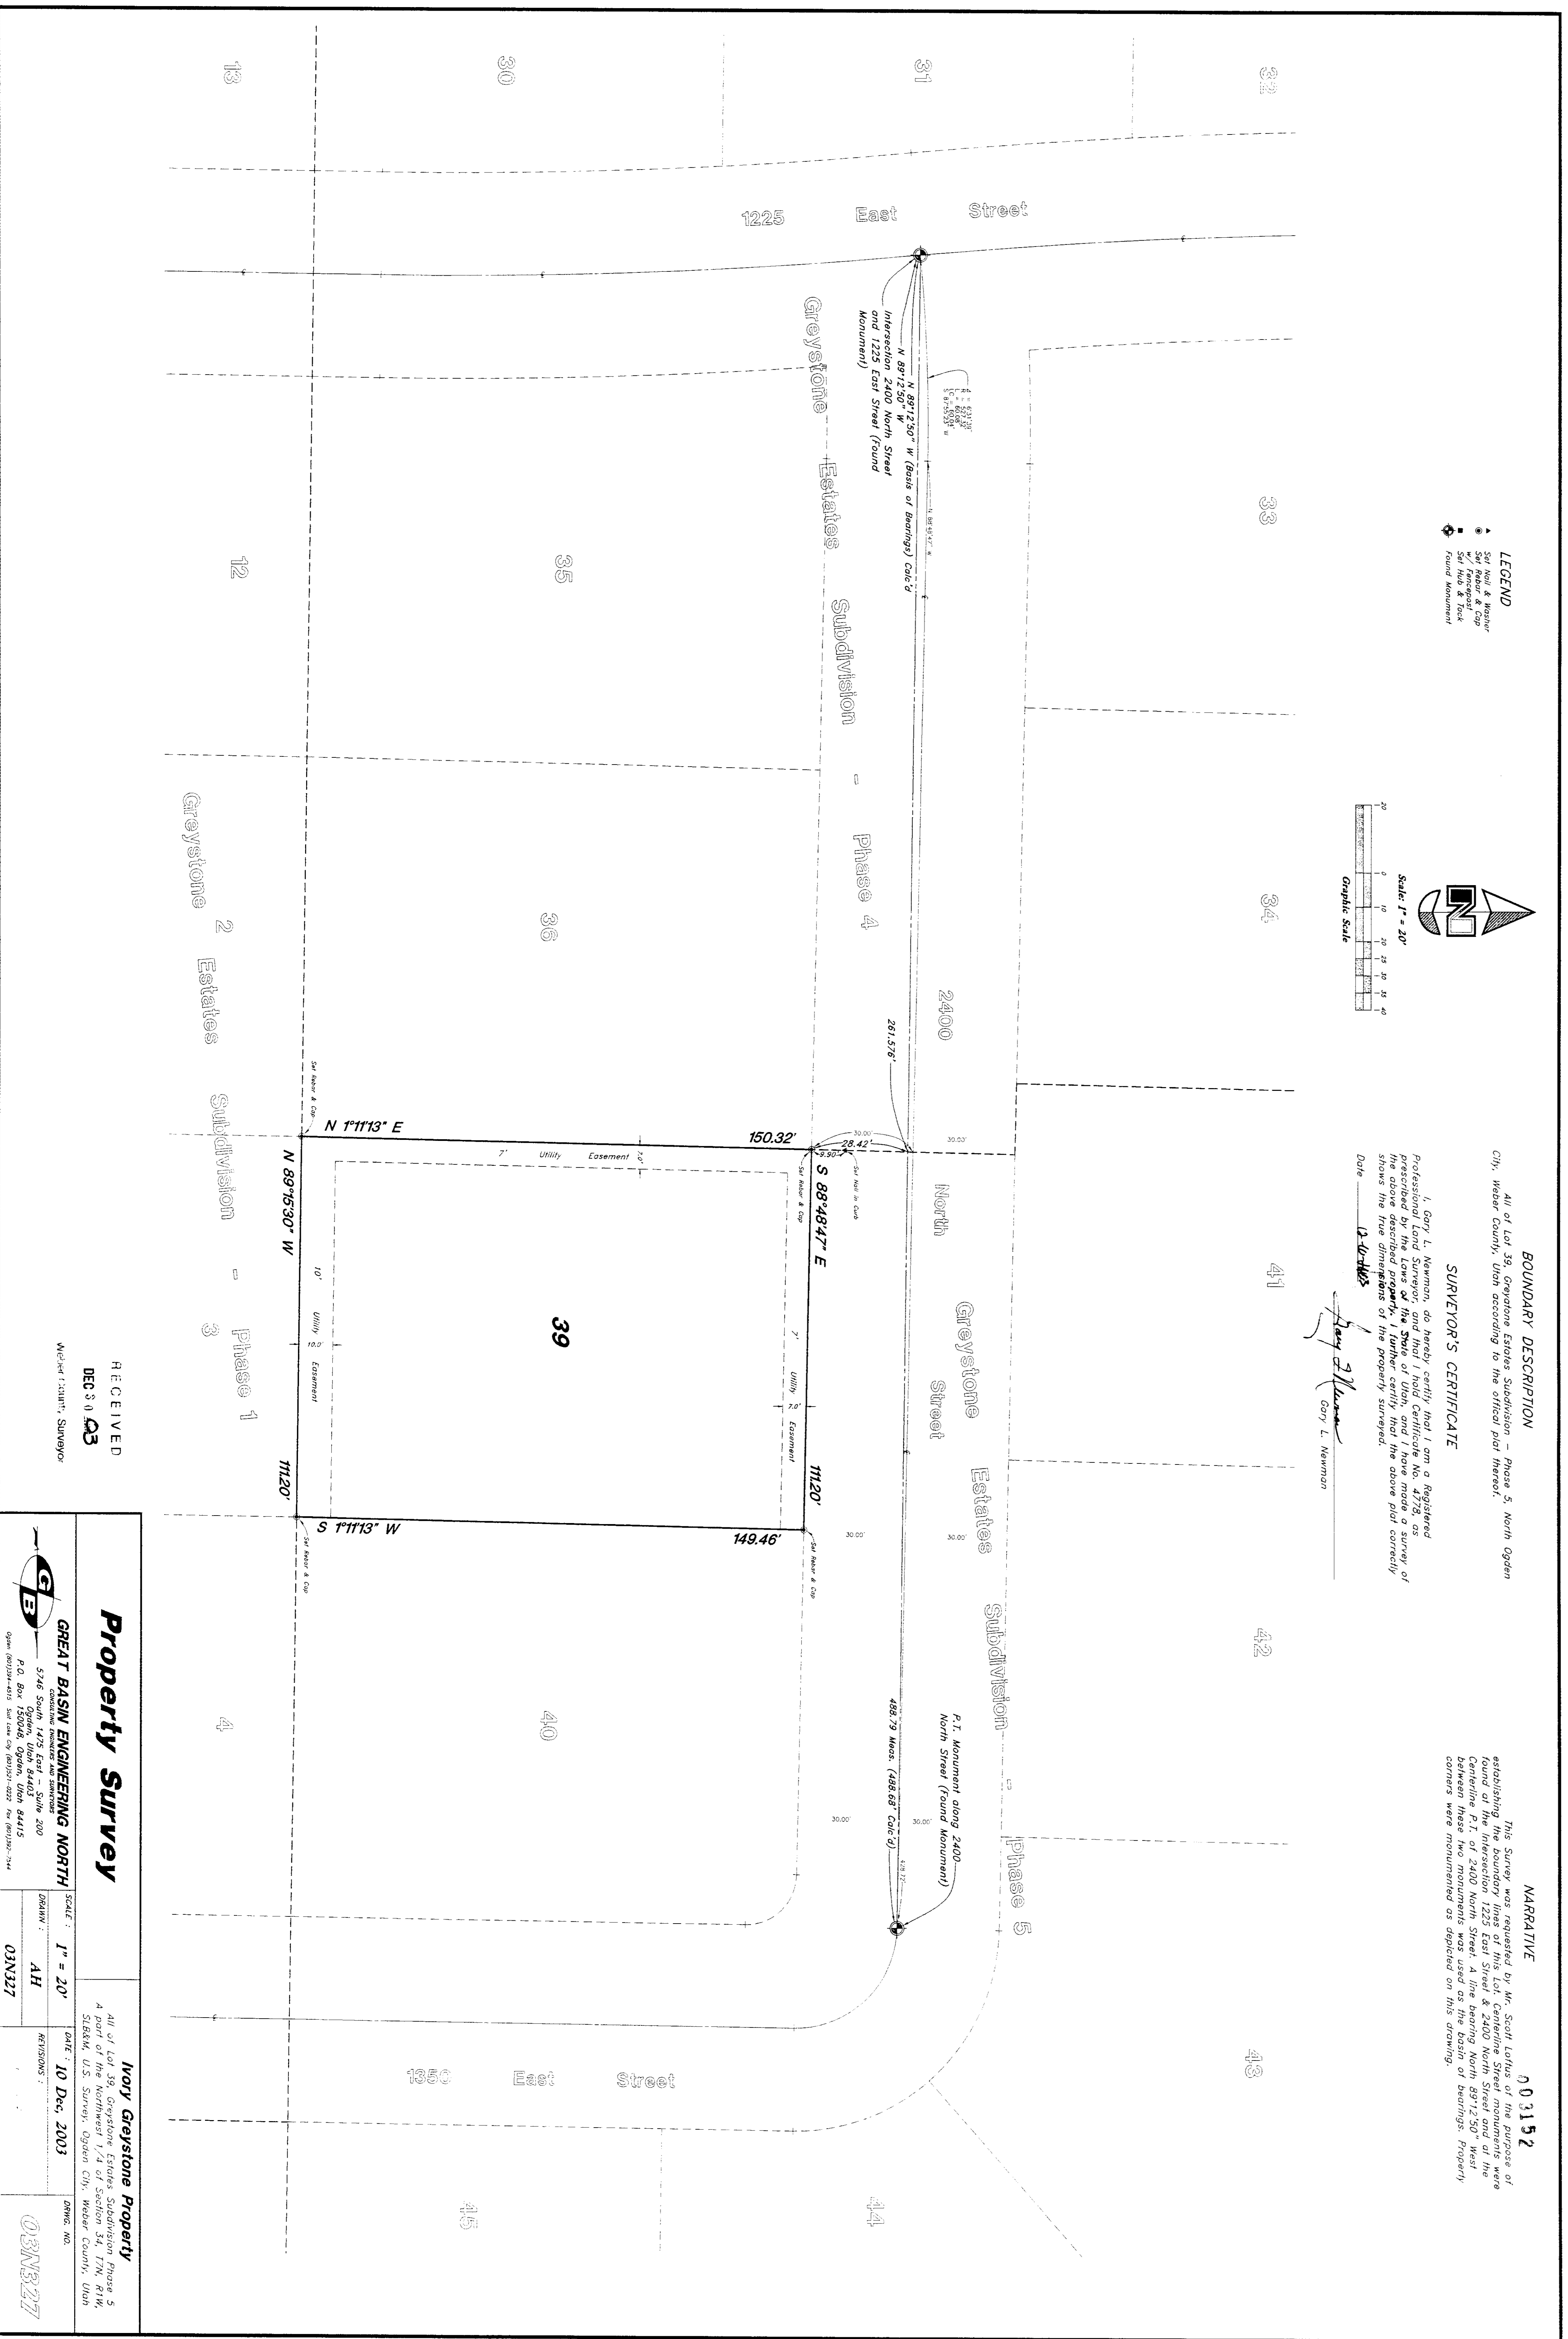

RECEIVED  
DEC 3 2003  
Weber County, Surveyor

**Property Survey**

**Great Basin Engineering North**  
5746 South 1475 East - Suite 200  

**Survey**  
Scale: 1" = 20'  
Date: 10 Dec, 2003

**Surveyor**  
AH  
03N327

**Client**  
Iroy Greystone Property  
All of Lot 39, Greystone Estates Subdivision Phase 5  
S168M, U.S. Survey, Ogden City, Weber County, Utah

003192