


# CERTIFICATION OF SURVEY

J 3163

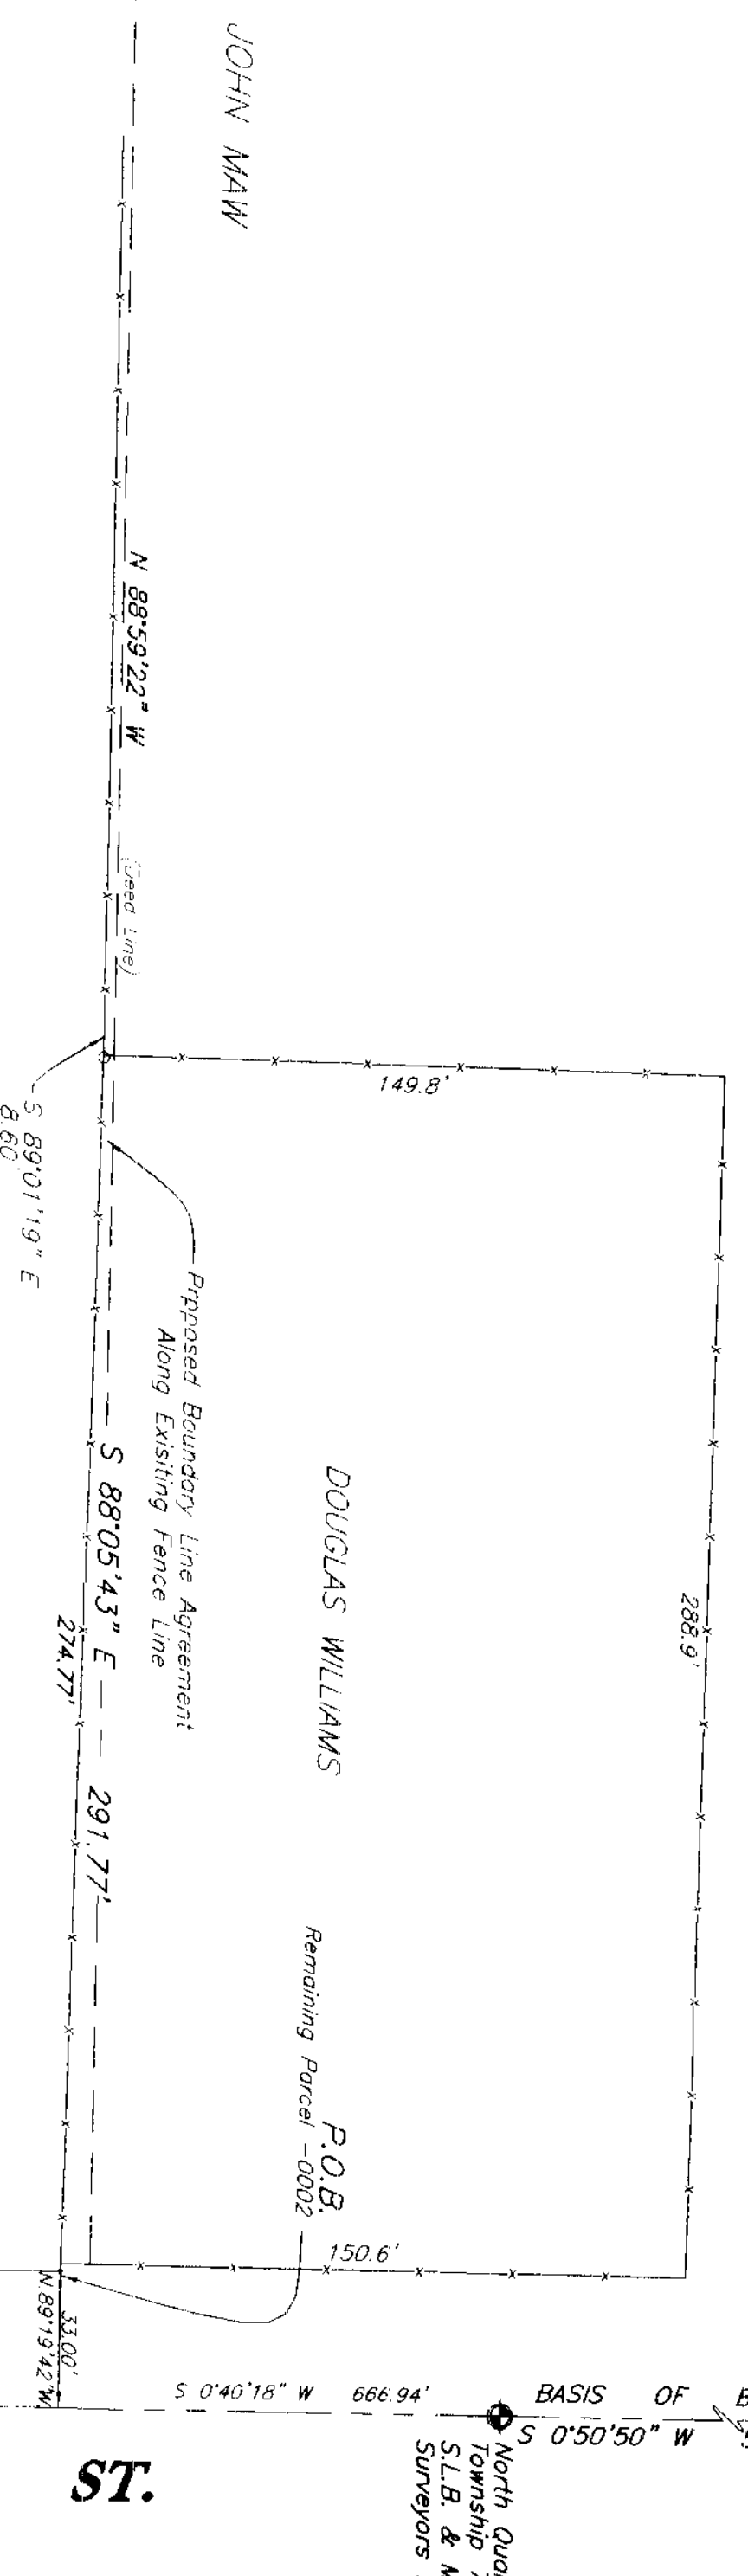

Scale 1" = 40'



KENNETH L. JACKSON & W/ LINDA W. - 0002  
REMAINING PARCEL - NOT APPROVED FOR DEVELOPMENT


**BOUNDARY DESCRIPTION**

A PART OF THE NORTHWEST QUARTER OF SECTION 28, TOWNSHIP 7 NORTH, RANGE 2 WEST, SUT LAKE BASIN AND WESTSIDE QUARTERS OF SECTION 28, TOWNSHIP 7 NORTH, RANGE 2 WEST, BEGINNING AT A POINT WHICH BEARS S 0° 40' 18" W, 892.00 FEET ALONG SECTION TO THE CENTERLINE OF 4200 WEST STREET, S 34° 38' 18" W, 237.96 FEET AND N 85° 21' 42" W, 159.00 FEET TO THE INTERSECTION OF SAID SECTION TO THE NORTH QUARTER CORNER OF SAID SECTION (AS UNADJUSTED) AND RUNNING THENCE S 34° 38' 18" W, 159.00 FEET ALONG THE CENTERLINE OF SAID SECTION, THENCE N 01° 25' 02" E, 153.04 FEET, THENCE N 85° 21' 42" W, 97.78 FEET, THENCE S 88° 34' 58" E, 86.80 FEET TO A POINT OF CURVE, THENCE 73.88 FEET ALONG THE CURVE, THENCE S 88° 34' 58" E, 159.00 FEET TO THE POINT OF BEGINNING (L.C. BEARS S 71° 58' 20" E, 72.83 FEET), THENCE S 89° 21' 42" E, 221.20 FEET TO THE POINT OF BEGINNING OR LESS.

## SURVEYORS CERTIFICATE



CYNTHIA L. SEBAST, P.L.S. 7851(170143)  
P/O CYNTHIA L.S. ROBERTS

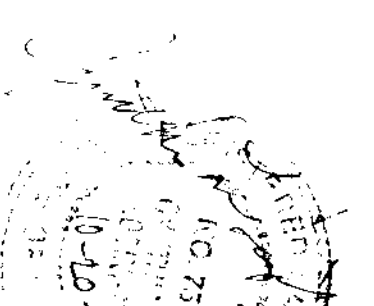


## NARRATIVE

THE PURPOSE OF THIS SURVEY WAS TO PROVIDE KEN JACKSON WITH A 1-LOT SUBDIVISION FOR HIS EXISTING HOME ON 4200 WEST ST. PART OF THIS PARCEL OF LAND IS WITHIN THE REMAINDER OF -0002 LOCATED NEAR THE NORTHWEST CORNER OF LOT 1 AND ADJACENT TO THAT PARCEL WITH -0002 REMAINDER'S PARCEL. THIS SURVEY WAS MADE AS BEING THE NORTH QUARTER CORNER OF 2 WEST SUT LAKE BASIN & WESTSIDE QUARTERS OF SECTION 28, TOWNSHIP 7 NORTH, RANGE 2 WEST. THIS SURVEY IS BASED ON THE WEBER COUNTY SURVEYORS SECTION DATA SHEETS.

Job 1. of

J 3163

PLEASANT PLAINS RANCH INC. - 0003  
REMAINING PARCEL - NOT APPROVED FOR DEVELOPMENT

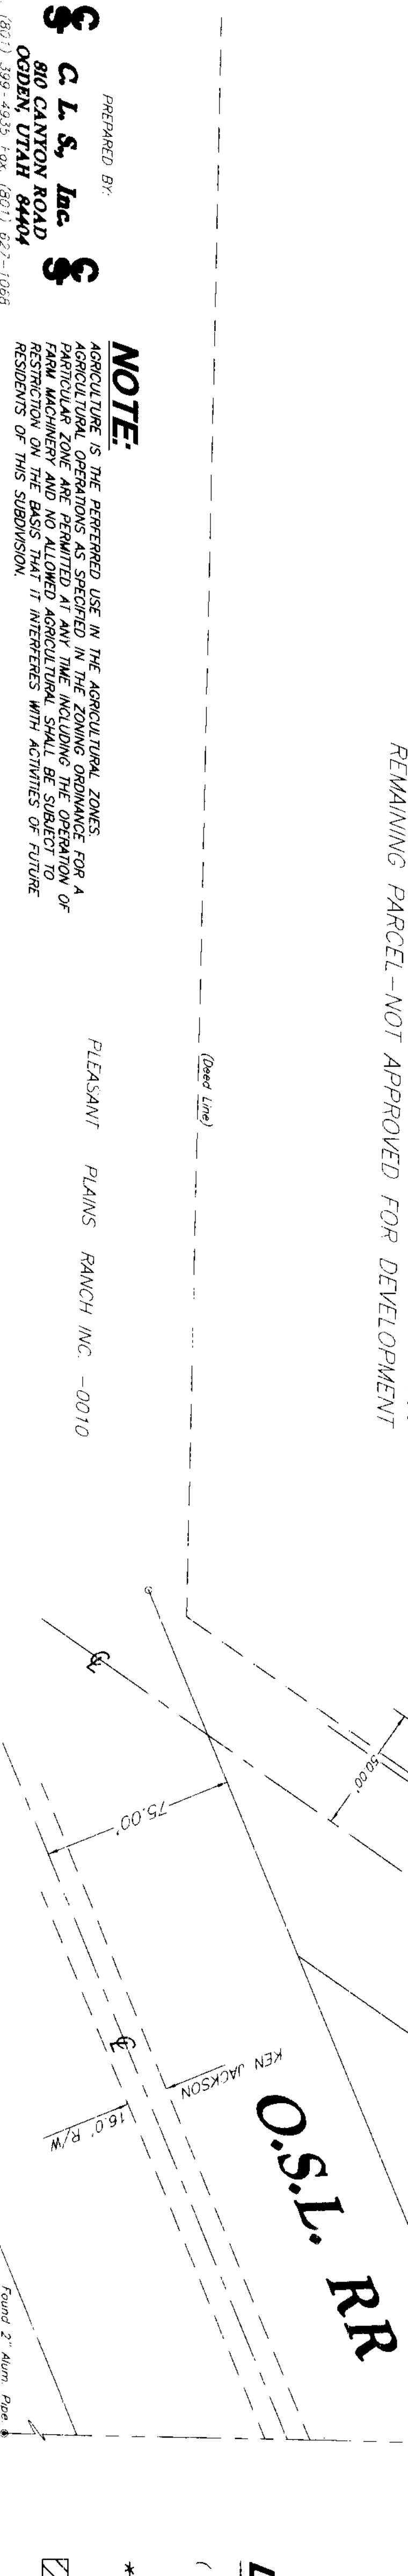

**REMAINING PARCEL - NOT APPROVED FOR DEVELOPMENT**  
WEBER COUNTY RECORDS TAX ID No. 19-028-0002 (SALE PLANE GND BEARINGS)  
A PART OF THE NORTHWEST QUARTER OF SECTION 28, TOWNSHIP 7 NORTH, RANGE 2 WEST, BEGINNING AT A POINT WHICH BEARS S 0° 40' 18" W, 892.00 FEET ALONG SECTION TO THE CENTERLINE OF 4200 WEST STREET, S 34° 38' 18" W, 237.96 FEET AND N 85° 21' 42" W, 159.00 FEET TO THE INTERSECTION OF SAID SECTION TO THE NORTH QUARTER CORNER OF SAID SECTION (AS UNADJUSTED) AND RUNNING THENCE S 34° 38' 18" W, 159.00 FEET ALONG THE CENTERLINE OF SAID SECTION, THENCE N 01° 25' 02" E, 153.04 FEET, THENCE N 85° 21' 42" W, 97.78 FEET, THENCE S 88° 34' 58" E, 86.80 FEET TO A POINT OF CURVE, THENCE 73.88 FEET ALONG THE CURVE, THENCE S 88° 34' 58" E, 159.00 FEET TO THE POINT OF BEGINNING (L.C. BEARS S 71° 58' 20" E, 72.83 FEET), THENCE S 89° 21' 42" E, 221.20 FEET TO THE POINT OF BEGINNING OR LESS.



**NOTE:**  


PREPARED BY:  
**C. L. S. Inc.**  
810 CAYTON ROAD  
(801) 399-4535

PLEASANT PLAINS RANCH INC. - 0010

## LEGEND:

- ( ) DISTANCE AND OR BEARING PER DEED OR P.L.T.
- NO PARALLELS IS MEASURED DISTANCE OR ADJUSTED P.L.T.
- OR DEED BEARING TO STATE PLANE GND BEARING.
- EXISTING FENCES
- SET 5/8" REBAR/C & L.S. CAP
- STREET DEDICATION = 2,550 SQ. FT.

CLIENT: KEN JACKSON  
SURVEY LOCATION:  
N.W. 1/4 SEC. 28, RANGE 2 WEST  
TOWNSHIP 7 NORTH, RANGE 2 WEST  
SALE PLANE GND BEARINGS

JOB No. P502-13C