

Scale: 1"=80'


NARRATIVE

The purpose of this survey is to locate the Lot corners and show how the lot lines fit the existing improvements.

LEGAL DESCRIPTION

All of Lots 65-66, Evergreen Park Subdivision, according to the official plat thereof on file and of record with the Weber County Recorder's Office, Ogden, Utah.

AUGUST 15, 2003

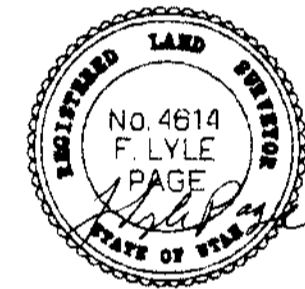

LEGEND

Property corner-set 5/8" rebar 7 places

RECEIVED

FEB 09 2004

Weber County Surveyor

003183

003183

SURVEY FOR		SECTION	TOWNSHIP	RANGE	DATE	SCALE
Bruce Goodwin 802 E. North St. Ogden, Utah 84404		NE 1/4 31	7 ND.	3 E.	8-13-03	1"=80'
		SL. B. & M.				
LOT	BLOCK	PLAT	SURVEY			
65/66			EVERGREEN PARK SUBDIVISION			
			9740 SO. SITZMARK DR.		SANDY, UTAH 84092	

