


SCALE: 1" = 100'
 O = 5/28/03, S/L, LANDMARK SURVEY
 V/28/03, C/L, STIMMED 052323

DATE: 09/18/03
 SIGNED: [Signature]

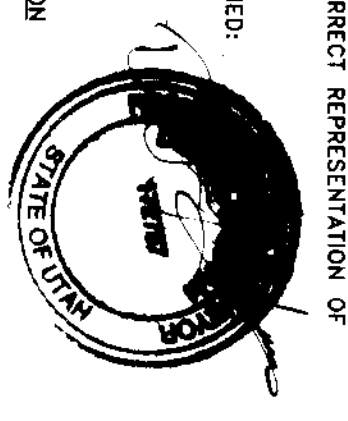

BOUNDARY DESCRIPTION
 A PART OF THE OF THE NORTHWEST QUARTER OF SECTION 14, TOWNSHIP 5 NORTH, RANGE 3 WEST, SALT LAKE BASIN AND MERIDIAN, U.S. SURVEY BEGINS AT A POINT NORTH 89°13'4" WEST 28.95' ALONG THE SECTION LINE FROM THE NORTH QUARTER CORNER OF SAID SECTION 14 TO THE POINT OF BEGINNING. 

ABSTRACT
 THE PURPOSE OF THIS SURVEY WAS TO DETERMINE THE GENERAL BOUNDARY OF THE EXISTING OCCUPATION AND CREATE INSTRUMENTS TO ASSESS TO THE FENCES IN THESE PARCELS. THE SURVEY WAS CONDUCTED BY LANDMARK SURVEYING INC. 

003199

LANDMARK SURVEYING INC.	
A COMPLETE LAND SURVEYING SERVICE	
444 S. 3000 WEST, SUITE 100, SALT LAKE CITY, UT 84119	
PHONE: 801-731-4075	
CLIENT: VERNON MCDERMOTT	
LOCATION: PART OF THE N.W. 1/4 OF SEC. 14, T5N, R3W, S11R&M	
SURVEYED: JULY 2003	
REVISIONS:	DRAWN BY: BGD/EA
	CHECKED BY: JGC
	DATE: 07-06-03
	FILE: 2470933

003199