


SCALE: 1" = 30'
 ○ = 5/8"Ø x 24" LENGTH REBAR WITH CAP STAMPED 167594

SURVEYOR'S CERTIFICATE

I, DALLAS K. BULLIARS, A PROFESSIONAL LICENSED LAND SURVEYOR AS PRESCRIBED BY THE LAWS OF THE STATE OF UTAH AND HOLDING LICENSE NUMBER 167594, DO HEREBY CERTIFY THAT I MADE A SURVEY OF THE BELOW DESCRIBED PROPERTY AND THAT THE SAME IS A TRUE AND CORRECT REPRESENTATION OF THE SAME.

DATE: 3-25-03 SIGNED: [Signature]

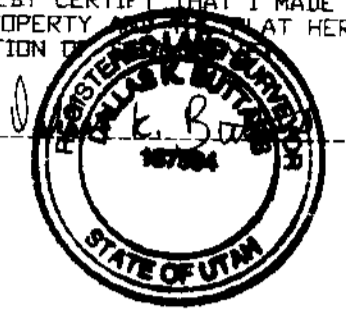

RECORD BOUNDARY DESCRIPTION

A PART OF THE NORTHWEST QUARTER OF SECTION 14, TOWNSHIP 6 NORTH, RANGE 2 EAST, SALT LAKE BASE AND MERIDIAN, BEGINNING AT A POINT THAT IS SOUTH 655.00 FEET, NORTH 87°22' WEST 177.00 FEET, SOUTH 76°25' WEST 75.00 FEET AND SOUTH 51°52' WEST 25.00 FEET FROM THE NORTHEAST CORNER OF SAID QUARTER SECTION, RUNNING THENCE SOUTH 51°52' WEST 50.0 FEET, THENCE SOUTH 32°05' EAST 122.0 FEET, THENCE NORTH 57°21' EAST 38.0 FEET, THENCE NORTH 27°23' WEST 121.0 FEET, MORE OR LESS, TO THE PLACE OF BEGINNING, CONTAINS 0.12 ACRES, MORE OR LESS.

FILE: 04

NARRATIVE

THE PURPOSE OF THIS SURVEY WAS TO DETERMINE THE PROPERTY LINES OF THIS LOT IN A SMALL SUMMER CABIN COMMUNITY. THE ORIGINAL SURVEY DID NOT SHOW A BASIS OF BEARING. EXISTING FENCE LINES AND CABIN TIES WERE MADE FOR THE RETRACEMENT OF THIS PROPERTY SURVEY.

003210

LANDMARK SURVEYING, INC.
 A COMPLETE LAND SURVEYING SERVICE
 4646 S. 3500 W. #3, WEST HAVEN, UTAH 84401
 PHONE 801-731-4075

CLIENT: RANDY WILSON
 LOCATION: SW 1/4 SEC. 14, T6N, R2E, SLB&M, WEBER COUNTY, UTAH
 SURVEYED: 3-20-03

REVISIONS:	DRAWN BY: D.B.
3-25-03	CHECKED BY: D.B.
	DATE: 3-20-03
	FILE: 2459

003210