
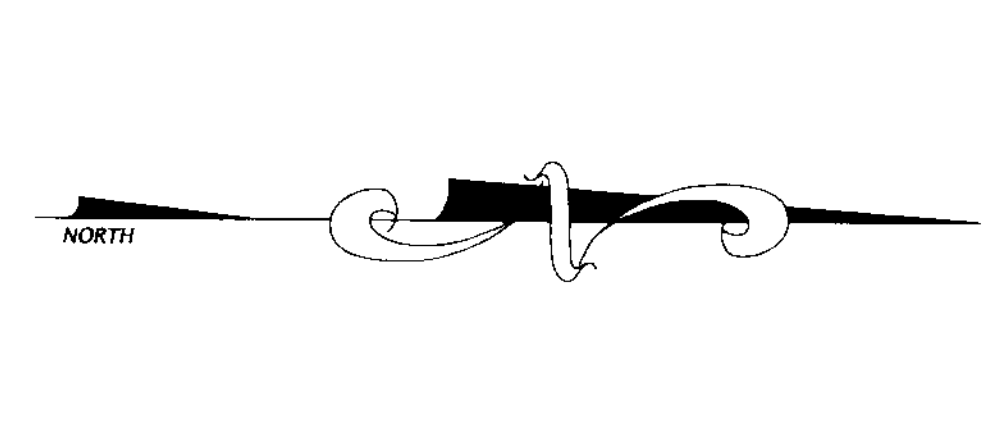


NORDIC KNOLL SUBDIVISION

A PART OF THE S. E. 1/4 OF SECTION 29, T. 7 N., R. 1 E., S.L.B. & M.

WEBER COUNTY, UTAH

RECORD OF SURVEY

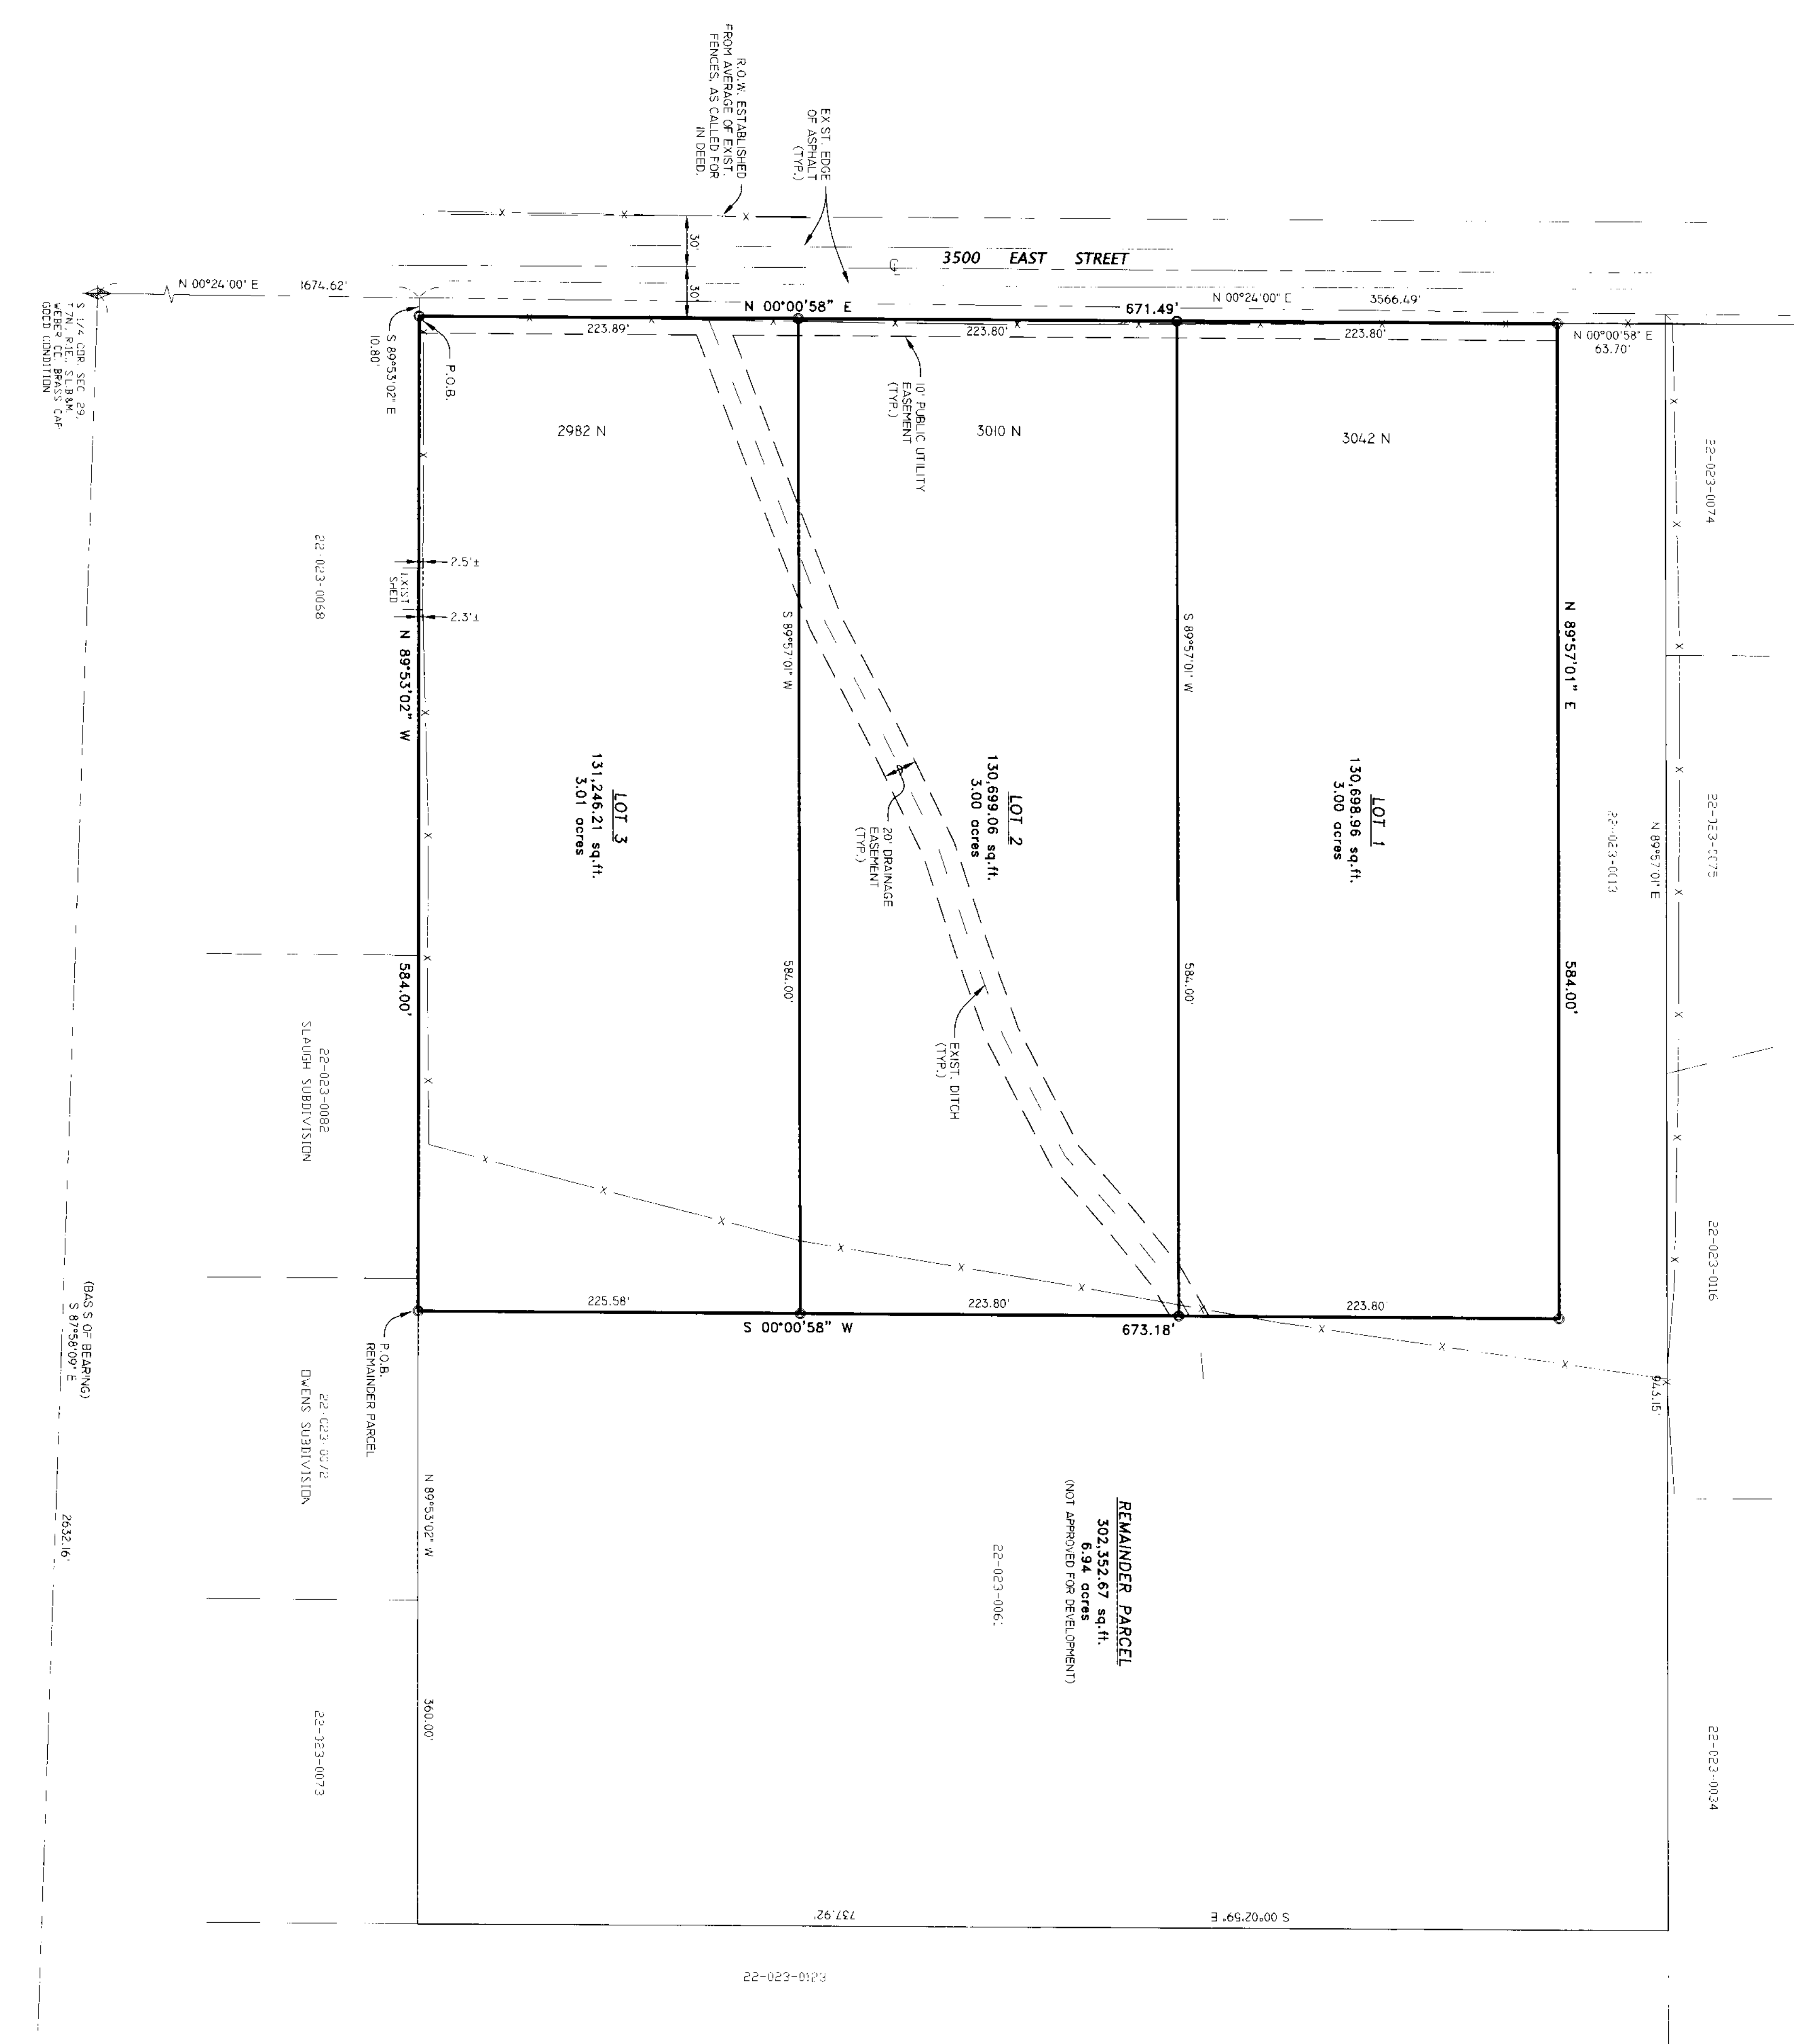


SCALE: 1" = 60'

REMAINDER PARCEL

NARRATIVE

SURVEYOR'S CERTIFICATE
 I, **DAVID R. JEFFREY**, A PROFESSIONAL LICENSED LAND SURVEYOR IN THE STATE OF UTAH, DO HEREBY CERTIFY THAT A SURVEY WAS MADE AND THE RESULTS THEREOF ARE SET FORTH IN THE ACCOMPANYING RECORD OF SURVEY. I HAVE PERSONALLY CONDUCTED THE SURVEY AND THE ACCOMPANYING RECORD OF SURVEY IS A TRUE AND CORRECT REPRESENTATION OF SAID SURVEY.
 DATE: 7/15/22 SURVEYED: JUL 2022

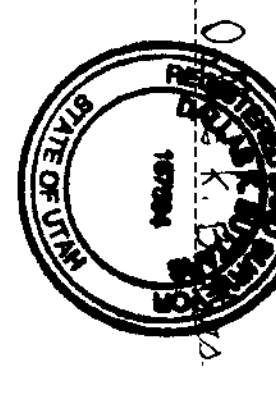

BOUNDARY DESCRIPTION

A PART OF THE SOUTHEAST QUARTER OF SECTION 29, TOWNSHIP 7 NORTH, RANGE 1 EAST, SALT LAKE BASE & MERIDIAN, U.S. SURVEY, DESCRIBED BEGINNING AT A BEARING NORTH 00°24'00" EAST 671.49 FEET ALONG THE QUARTER SECTION CORNER POINTS OF EAST 671.

RECORD DESCRIPTION - REMAINDER PARCEL

A PART OF THE SOUTHEAST QUARTER OF SECTION 29, TOWNSHIP 7 NORTH, RANGE 1 EAST, SALT LAKE BASE & MERIDIAN, U.S. SURVEY, DESCRIBED BEGINNING AT A POINT NORTH 00°24'00" EAST 671.49 FEET ALONG THE SECTION LINE AND SOUTH 89°51'00" EAST 584.

04

LANDMARK SURVEYING, INC. A COMPLETE SURVEYING SERVICE 444 S. 3000 W. A-3, WEST HANSEN, UTAH 84003 PHONE: 801-731-4425 FAX: 801-731-4488		WEBER COUNTY RECORDER ENTRY # _____ FEE _____ FILED FOR RECORD & RECORDED THIS _____ DAY OF _____ 20____ AT _____ IN BOOK _____ OF _____ PAGE _____ BY _____ WEBER COUNTY RECORDER _____ COUNTY	
CLIENT: CAROL PILCHER LOCATION: PART OF THE S.E. 1/4 OF SEC. 29 SURVEYED: JUL 2022	DRAWN BY: DJR CHECKED BY: DJR DATE: 07-15-22	REVISIONS: 1-07-22: I.A. 2-07-22: I.A.	FILE: 23B817M.DWG