


# CERTIFICATION OF SURVEY for PAUL STUART

WEST QUARTER CORNER OF SECTION 32, TOWNSHIP 7 NORTH, RANGE 1 WEST, S184M, NEW MONUMENT POSITION NOT IN PLACE. OLD MONUMENT POSITION BEARS N89°31'50"E 1601'

NE CORNER SW QUARTER OF SECTION 32, TOWNSHIP 7 NORTH, RANGE 1 WEST, S184M, WEBER COUNTY SURVEYORS BRASS CAP MONUMENT.

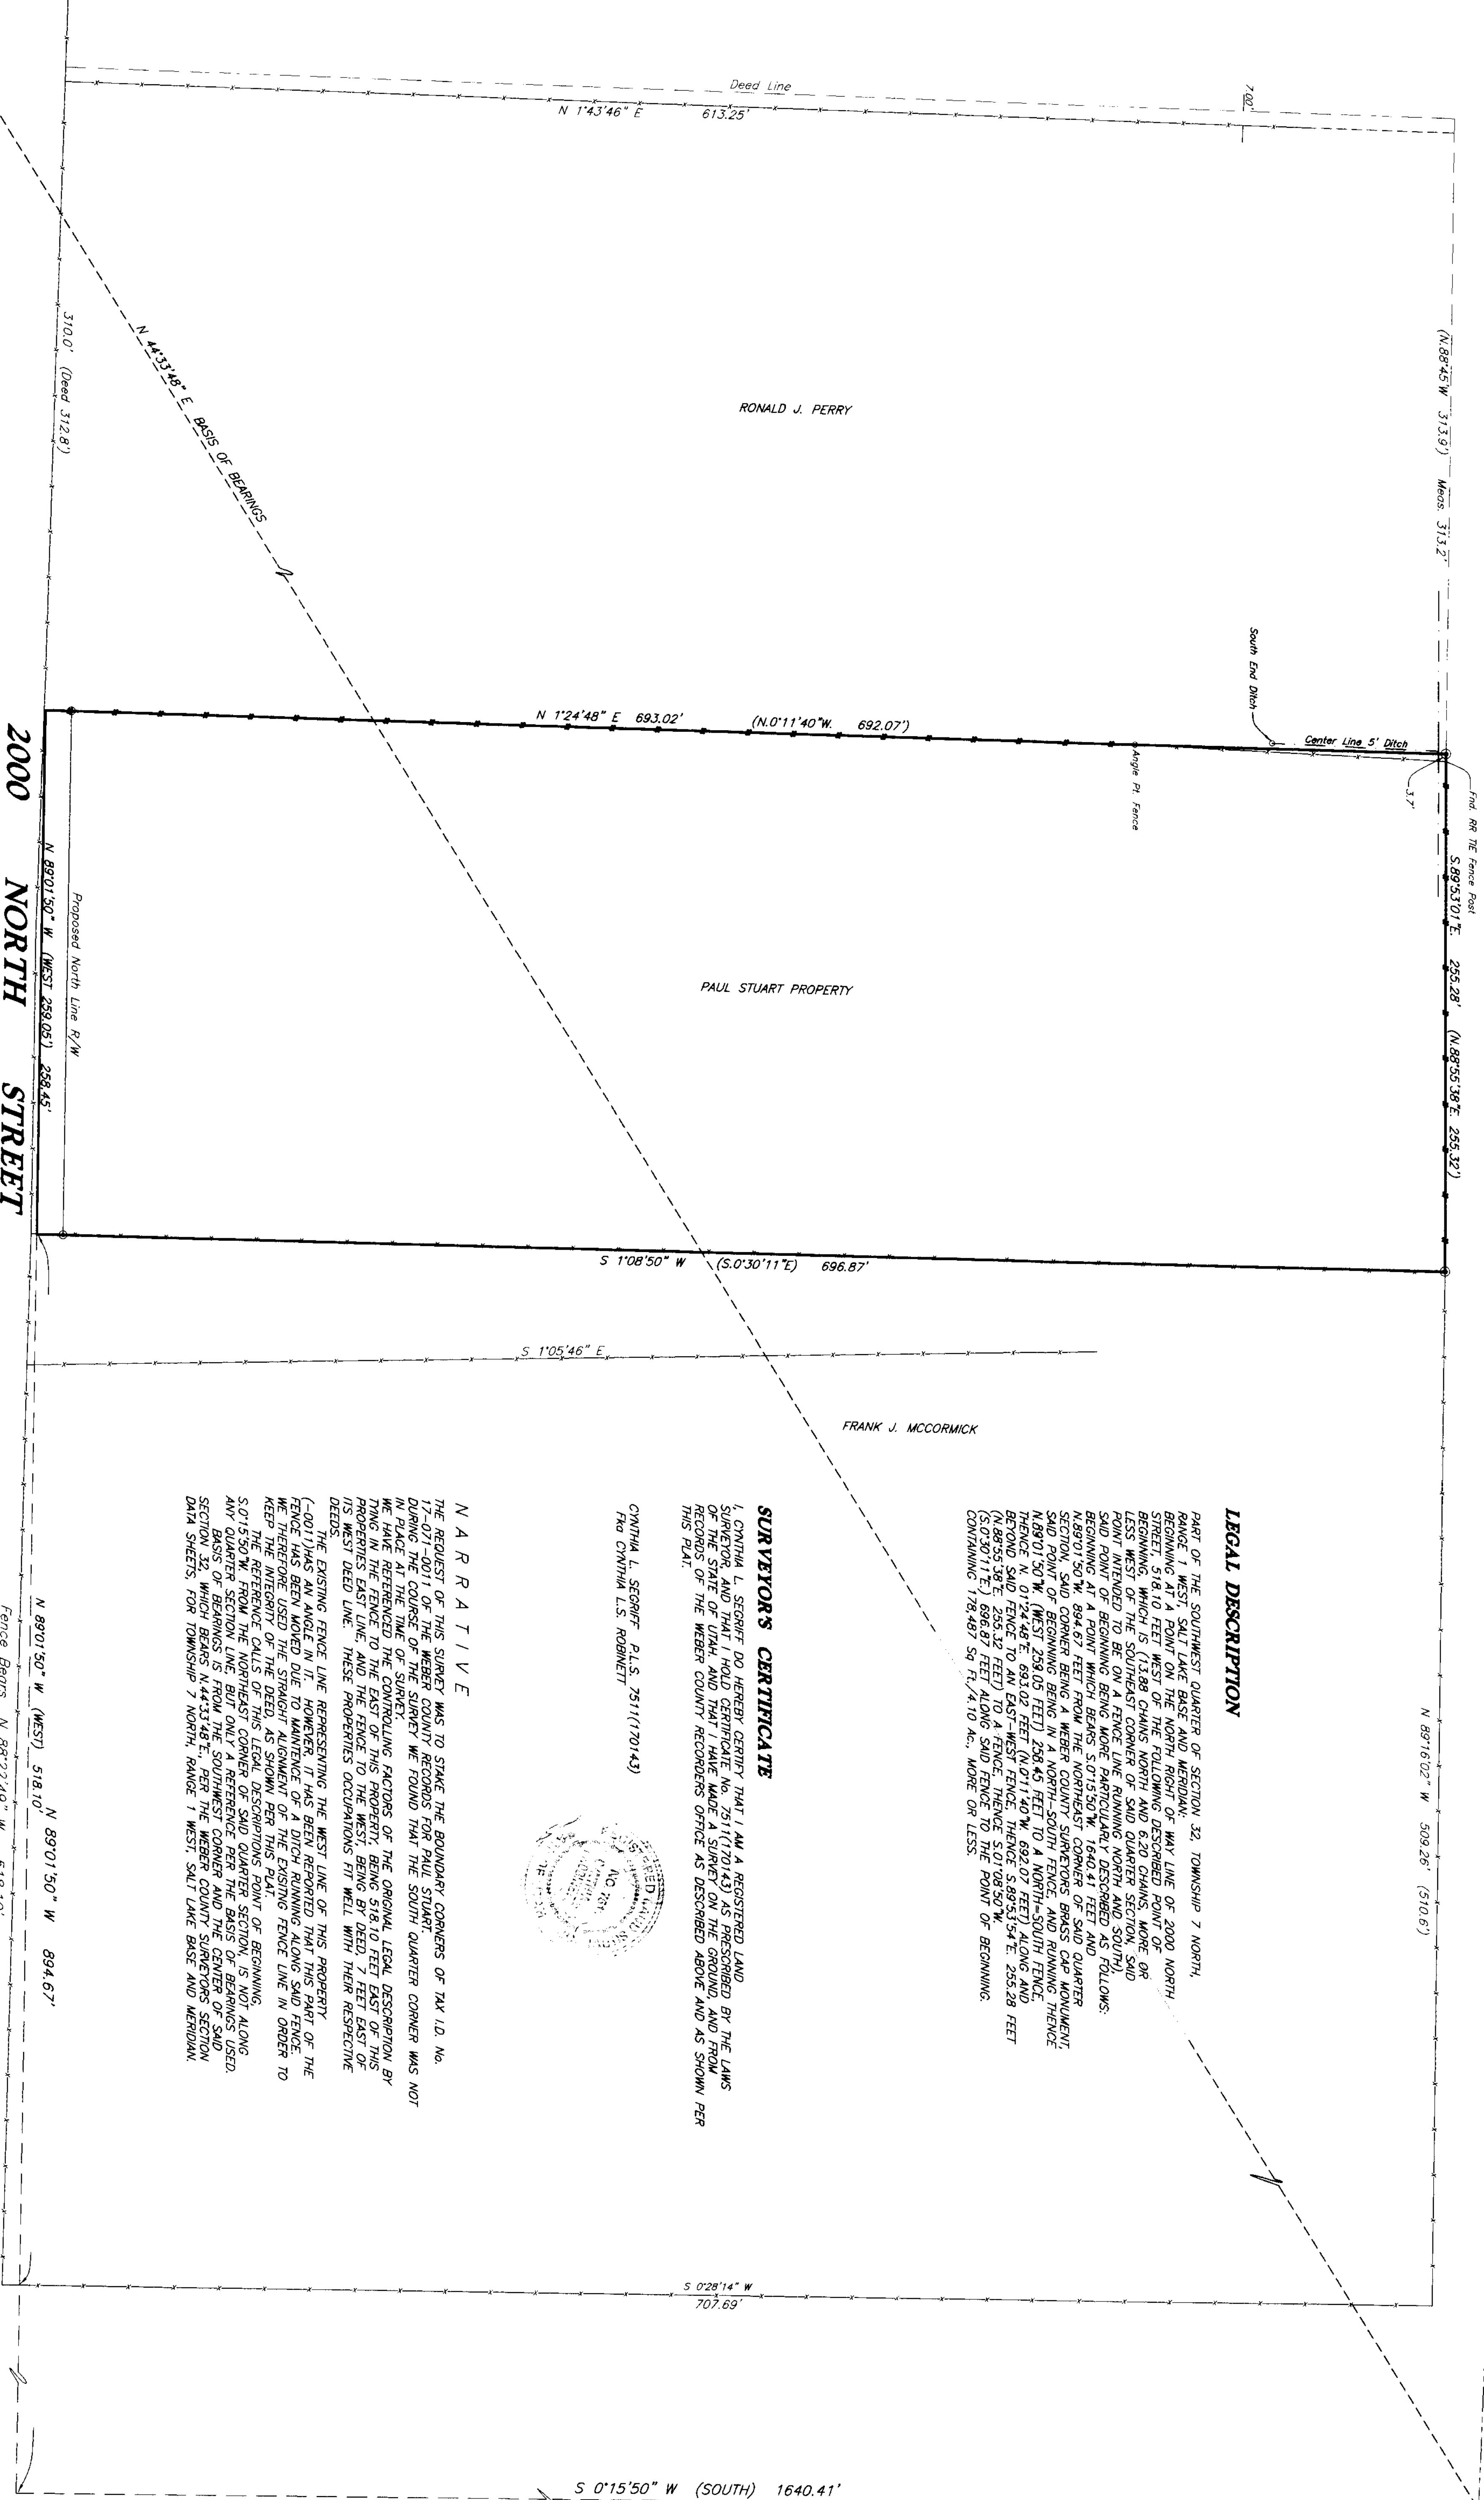

## LEGAL DESCRIPTION



## SURVEYORS' CERTIFICATE

I, CYNTHIA L. SEGNER DO HEREBY CERTIFY THAT I AM A REGISTERED LAND SURVEYOR AND THAT I HOLD CERTIFICATE NO. 7511(170143) AS PRESCRIBED BY THE LAWS OF THE STATE OF UTAH. I HAVE PERSONALLY EXAMINED THE RECORDS OF THE WEBER COUNTY RECORDERS OFFICE AS DESCRIBED ABOVE AND AS SHOWN PER THIS PLAT.

CYNTHIA L. SEGNER - PL.S. 7511(170143)  
NO. 7511(170143)  
NO. 7511(170143)



## NARRATIVE

THE EXISTING FENCE LINE REPRESENTING THE WEST LINE OF THIS PROPERTY (N 89°01'50" W) WAS AN ANGLE IN IT. HOWEVER, IT HAS BEEN REPORTED THAT THIS PART OF THE FENCE HAS BEEN MOVED DUE TO MAINTENANCE OF A DITCH RUNNING ALONG SAID FENCE TO KEEP THE INTEGRITY OF THE DEED, AS SHOWN PER THIS PLAT. 

## LEGEND:

- ( ) DISTANCE AND OR BEARING PER DEED OR PLAT.
- NO PARENTHESES IS MEASURED DISTANCE OR ROTATED PLAT
- \*-\* EXISTING FENCES.
- SET 5/8" REBAR/C. & L.S. CAP.

SOUTH QUARTER CORNER OF SECTION 32, TOWNSHIP 7 NORTH, RANGE 1 WEST, S184M, WEBER CO. SURVEYORS BRASS CAP MONUMENT.

PREPARED BY:  
C. L. S., Inc.  
810 CANYON ROAD  
COURTNEY, UTAH 84004  
(801) 399-4335 FAX (801) 627-1068

003227

003227  
FEB 17 2004  
Vernon Adams, Surveyor

C. L. S., Inc.  
810 CANYON ROAD  
COURTNEY, UTAH 84004  
(801) 399-4335

CLIENT: PAUL STUART

SURVEY LOCATION:  
SW 1/4 SEC. 32,  
TOWNSHIP 7 NORTH, RANGE 1 WEST,  
SALT LAKE BASE & MERIDIAN

SURVEY DATE: 11/14/03

JOB NO. PS03-35