

LAND DESIGN
DESIGN • DEVELOPMENT • SURVEYING • MAPPING


WEST TOWN PLAZA
2964 WEST 4700 SOUTH
WEST VALLEY CITY, UTAH 84118
OFFICE (801) 840-0600
FAX (801) 840-0627
LAND DESIGN LLC

DATE	BY	COMMENTS
7-02		PRELIMINARY
10-03		FIELD - COURT REVIEW
8-04		REVISED FOR RECORDING

PROJECT SITE LOCATION
HUNTSVILLE
SECTION 2
T.5N. R.1E.
S.L.B. & M.

SURVEYED BY:
S.R./J.C.D.J.
DRAWN BY:
S.R./J.C.D.J.
DATE:
7-25-04

JOB NO. L-02-105
DWS HELCOPHUNTS
CHUCK
003328

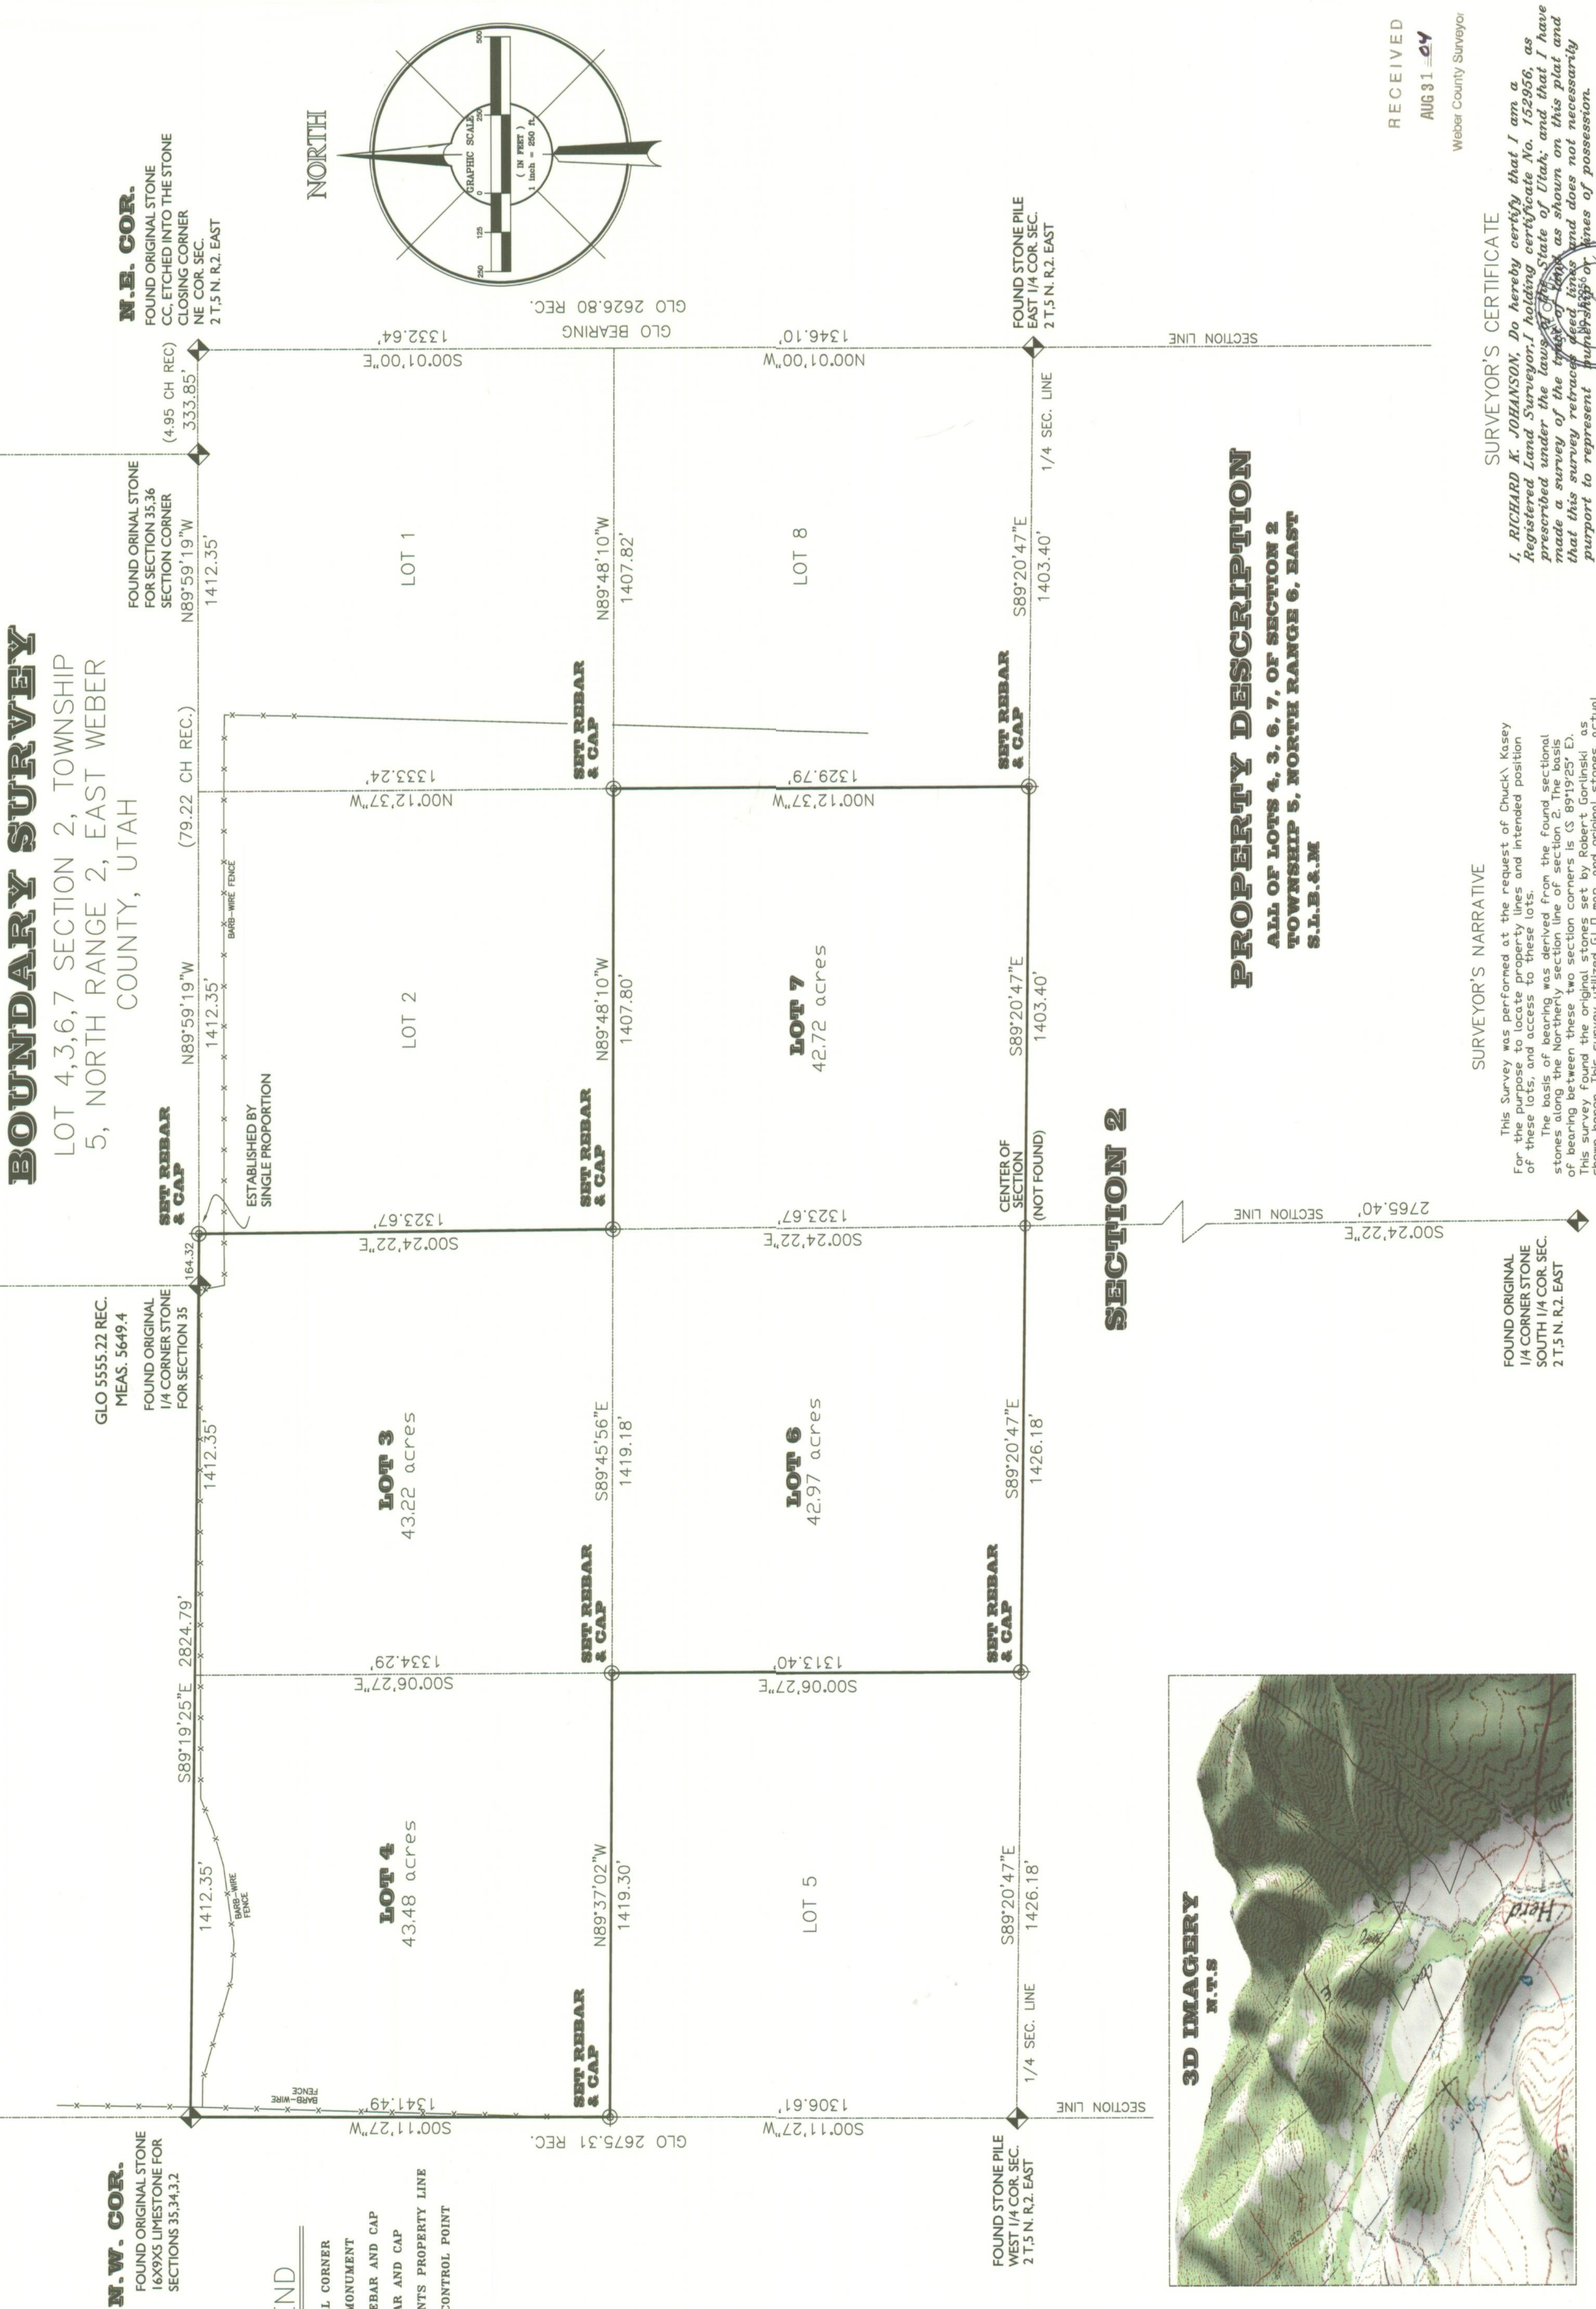

RECEIVED
AUG 31 2004
Weber County Surveyor

SURVEYOR'S CERTIFICATE

I, **RICHARD K. JOHANSON**, Do hereby certify that I am a Registered Land Surveyor, License Certificate No. 152956, as prescribed under the laws of the State of Utah, and that I have made a survey of the above property as shown on this plat and that this survey retraced the original monument lines of this plat and does not necessarily purport to represent the actual lines of possession.

Signature: *[Signature]*
Date: *Aug 2, 2004*