DRAWING NUMBER

000335

HECHOER BY NUMBER 0754F

DRAWING NUMBER

000335

PLAN HOLD CORPORATION . IRVINE, CALIFORNIA

000335

DRAWING NUMBER


DLD CORPORATION • IRVINE, CALIFORNIA
REURDER BY NUMBER 075AF

DRAWING NUMBER

000335

PEOROER BY NUMBER 0754F


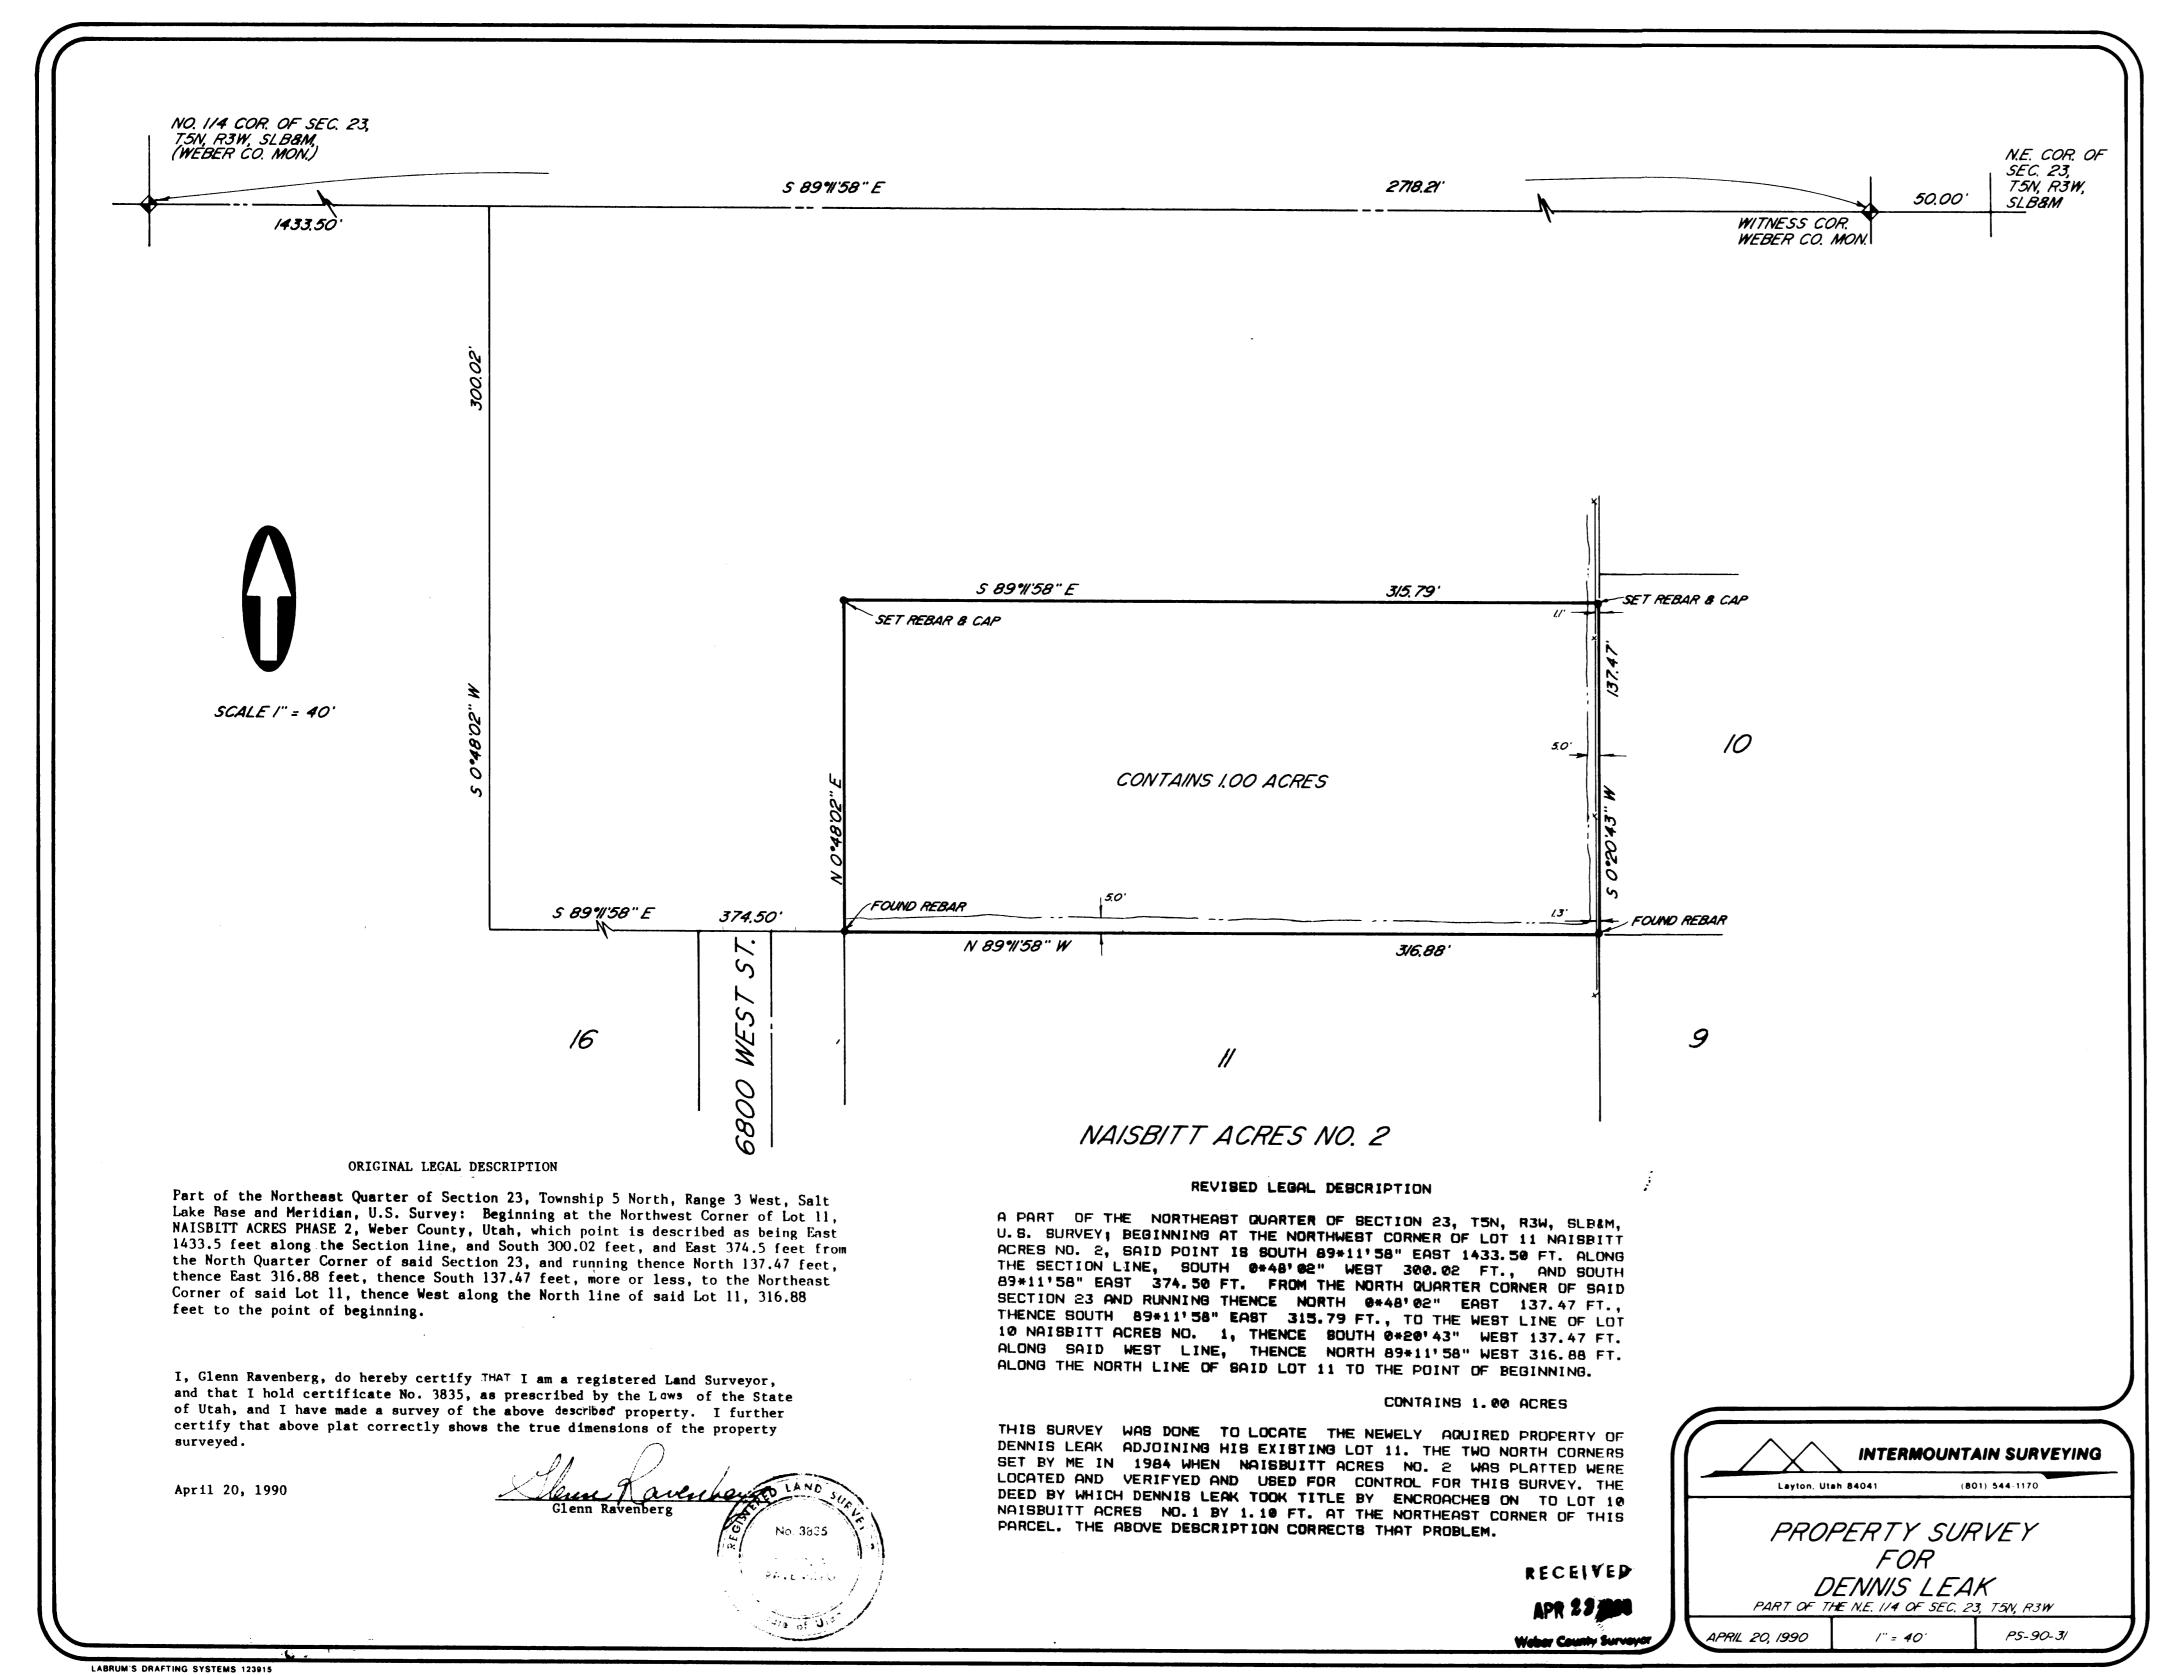

00022