


SURVEYOR'S CERTIFICATE

I, DALLAS K. BUTTARS, A PROFESSIONAL LICENSED LAND SURVEYOR AS PRESCRIBED BY THE LAWS OF THE STATE OF UTAH AND HOLDING LICENSE NUMBER 167594 DO HEREBY CERTIFY THAT I MADE A SURVEY OF THE BELOW DESCRIBED PROPERTY AND THE PLAT HEREON IS A TRUE AND CORRECT REPRESENTATION OF SAID SURVEY.

DATE: 6-21-04 SIGNED: [Signature]

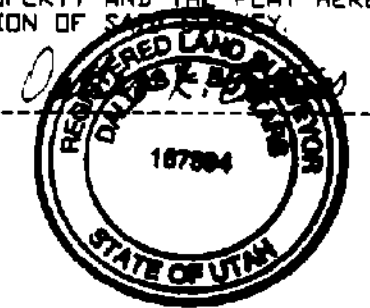

RECORD BOUNDARY DESCRIPTION

PART OF THE NORTHWEST QUARTER OF SECTION 17, TOWNSHIP 7 NORTH, RANGE 1 WEST, SALT LAKE BASE AND MERIDIAN BEGINNING AT THE SOUTHWEST CORNER OF SAID QUARTER SECTION THENCE EAST 40 CHAINS, THENCE NORTH 22 RODS, THENCE NORTHWESTERLY TO A POINT 10 CHAINS NORTH OF BEGINNING, THENCE SOUTH ALONG THE SECTION LINE 10 CHAINS TO THE PLACE OF BEGINNING. EXCEPT 3.71 ACRES CONVEYED TO U.P. & L. CO. BY DEED IN BOOK 705-579

NARRATIVE


THE PURPOSE OF THIS SURVEY WAS TO ESTABLISH THE NORTH LINE OF THIS PARCEL FOR IMPROVEMENT PURPOSES THE POWER LINES WERE LOCATED AND THE BEARING BASE IS UTAH STATE PLANE GRID BEARING AS SHOWN.

RECEIVED

NOV 09 2004

Weber County Surveyor:

003370

 LANDMARK SURVEYING, INC. A COMPLETE LAND SURVEYING SERVICE 4646 S. 3500 W. #3, WEST HAVEN, UTAH 84401 PHONE 801-731-4075	
CLIENT: DAVE THOMPSON	
LOCATION: NW 1/4 SEC. 17, T.7 N., R.1 W. S.L.B. & M.	
SURVEYED: JUNE 2004	
REVISIONS:	DRAWN BY: D.B.
	CHECKED BY: D.B.
	DATE: JUNE 21, 2004
	FILE: 2612

0033701

003370