


As Surveyed Description

A PART OF THE NORTHEAST AND SOUTHEAST QUARTERS OF SECTION 6, TOWNSHIP 6 NORTH, RANGE 1 WEST OF THE SALT LAKE BASE AND MERIDIAN, BEGINNING AT A BRASS CAP MONUMENT BEING A POINT LOCATED 845.96 FEET (849.0 FEET RECORD) NORTH 89°46'34" EAST ALONG THE NORTH LINE OF SAID NORTHEAST QUARTER AND SOUTH 00°00'00" EAST 463.48 FEET (458.90 FEET RECORD) FROM THE NORTHWEST CORNER OF SAID NORTHEAST QUARTER; RUNNING THENCE SOUTH 89°36'56" EAST 87.17 FEET TO A LINE 200 FEET PERPENDICULAR AND SOUTHWESTERLY FROM THE WESTERLY RIGHT-OF-WAY OF STATE HIGHWAY 89-91; THENCE PARALLEL TO SAID HIGHWAY ON SAID LINE SOUTH 26°26'57" EAST 1495.15 (1504.31 FEET RECORD) TO A POINT ON THE CENTERLINE OF THE HARRISVILLE CANAL; THENCE NORTH 60°12'20" WEST 112.69 FEET TO A POINT ON THE SOUTH BANK OF SAID CANAL AND AN EXISTING FENCE LINE; THENCE SOUTH 00°59'15" WEST 715.62 FEET (725 FEET MORE OR LESS RECORD) ALONG SAID FENCE LINE; THENCE SOUTH 87°49'15" WEST 348.91 FEET ALONG AN EXISTING FENCE LINE; THENCE SOUTH 41°23'32" WEST 264.00 FEET; THENCE SOUTH 25°55'32" WEST 123.42 FEET; THENCE SOUTH 70°40'32" WEST 132.00 FEET; THENCE SOUTH 15°40'32" WEST 268.26 FEET TO THE NORTH RIGHT-OF-WAY LINE OF HARRISVILLE ROAD; THENCE NORTH 65°10'18" WEST 420.50 FEET (411.10 FEET RECORD) ALONG SAID RIGHT-OF-WAY LINE TO THE EASTERLY RIGHT-OF-WAY LINE OF THE O.S.L.R.R. BEING A LINE 50.00 FEET PERPENDICULAR AND NORTHEASTERLY FROM THE CENTERLINE OF THE MAIN LINE TRACK; THENCE ALONG SAID EASTERLY RIGHT-OF-WAY LINE NORTH 25°54'30" WEST 764.08 FEET TO THE EAST RIGHT-OF-WAY LINE OF 750 WEST STREET; THENCE ALONG SAID EAST RIGHT-OF-WAY LINE NORTH 00°52'18" EAST 1347.90 FEET (1342.48 FEET RECORD) TO AN EXISTING FENCE LINE; THENCE ALONG SAID FENCE LINE THE FOLLOWING TWO COURSES; (1) NORTH 89°53'59" EAST 824.11 FEET (814.30 FEET RECORD) TO A BRASS CAP MONUMENT; (2) NORTH 00°17'38" EAST 410.01 FEET (410.32 FEET RECORD) TO THE POINT OF BEGINNING. CONTAINING 61.37 ACRES.

SURVEY CERTIFICATE

I, K. Greg Hansen, do hereby certify that I am a Registered Land Surveyor, and that I hold Certificate No. 167819 as prescribed by the Laws of the State of Utah, and that I have made and/or Supervised the survey of the property shown and described hereon and that this plot is a true and correct representation of said survey to the best of my knowledge and belief.

K. Greg Hansen, R.L.S. No. 167819

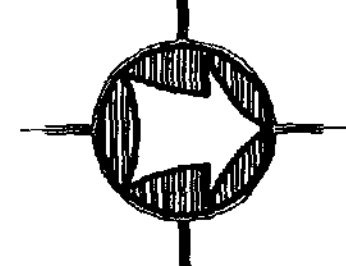

Scale: 1" = 100'

- LEGEND:**
- PROPERTY LINE
 - CENTERLINE
 - CURB & GUTTER
 - EDGE OF PAVEMENT
 - - - DITCH
 - - - FENCE LINE
 - BRASS CAP MONUMENT
 - SET 5/8" REBAR W/ CAP
 - SET 11/04

Drawn By: kgh Date: 11/15/04
 Designed By: _____
 Checked By: _____
 Approved By: _____
 Scale: 1" = 100'
 Drawing File: 04-3-203ps.dwg
 JOB NUMBER: 04-3-203

HANSEN & ASSOCIATES, INC.
 Consulting Engineers and Land Surveyors
 538 North Main Brigham City, Utah 84302
 Brigham City Ogden Logan
 (435)723-5491 (801)399-4905 (435)752-8272

PROPERTY SURVEY FOR
Interpace Industries Inc.
 736 West Harrisville Road
 Harrisville, Weber County, Utah
 A PART OF THE NE & SE QUARTERS OF SECTION 6,
 TOWNSHIP 6 NORTH, RANGE 1 WEST, S.L.B. & M.

Dwg. No. 1 of 2

Narrative
 The purpose of this survey was to establish and set the property corners of the parcel as shown and described hereon. The survey was ordered by Sam Love for Interpace Brick. The control used to establish the property corners was the existing Weber County Survey Monumentation surrounding Section 6, T6M, R1W, SLB&M. The basis of bearing is the north line of the northeast quarter of said Section which bears North 89°46'43" East. The properties located at the southeast corner of this property have several overlaps and gaps that exist between that of occupation and deed. It is suggested that boundary line agreements be made on said east line to clear up these discrepancies.

No.	Date	By	Revision