003470

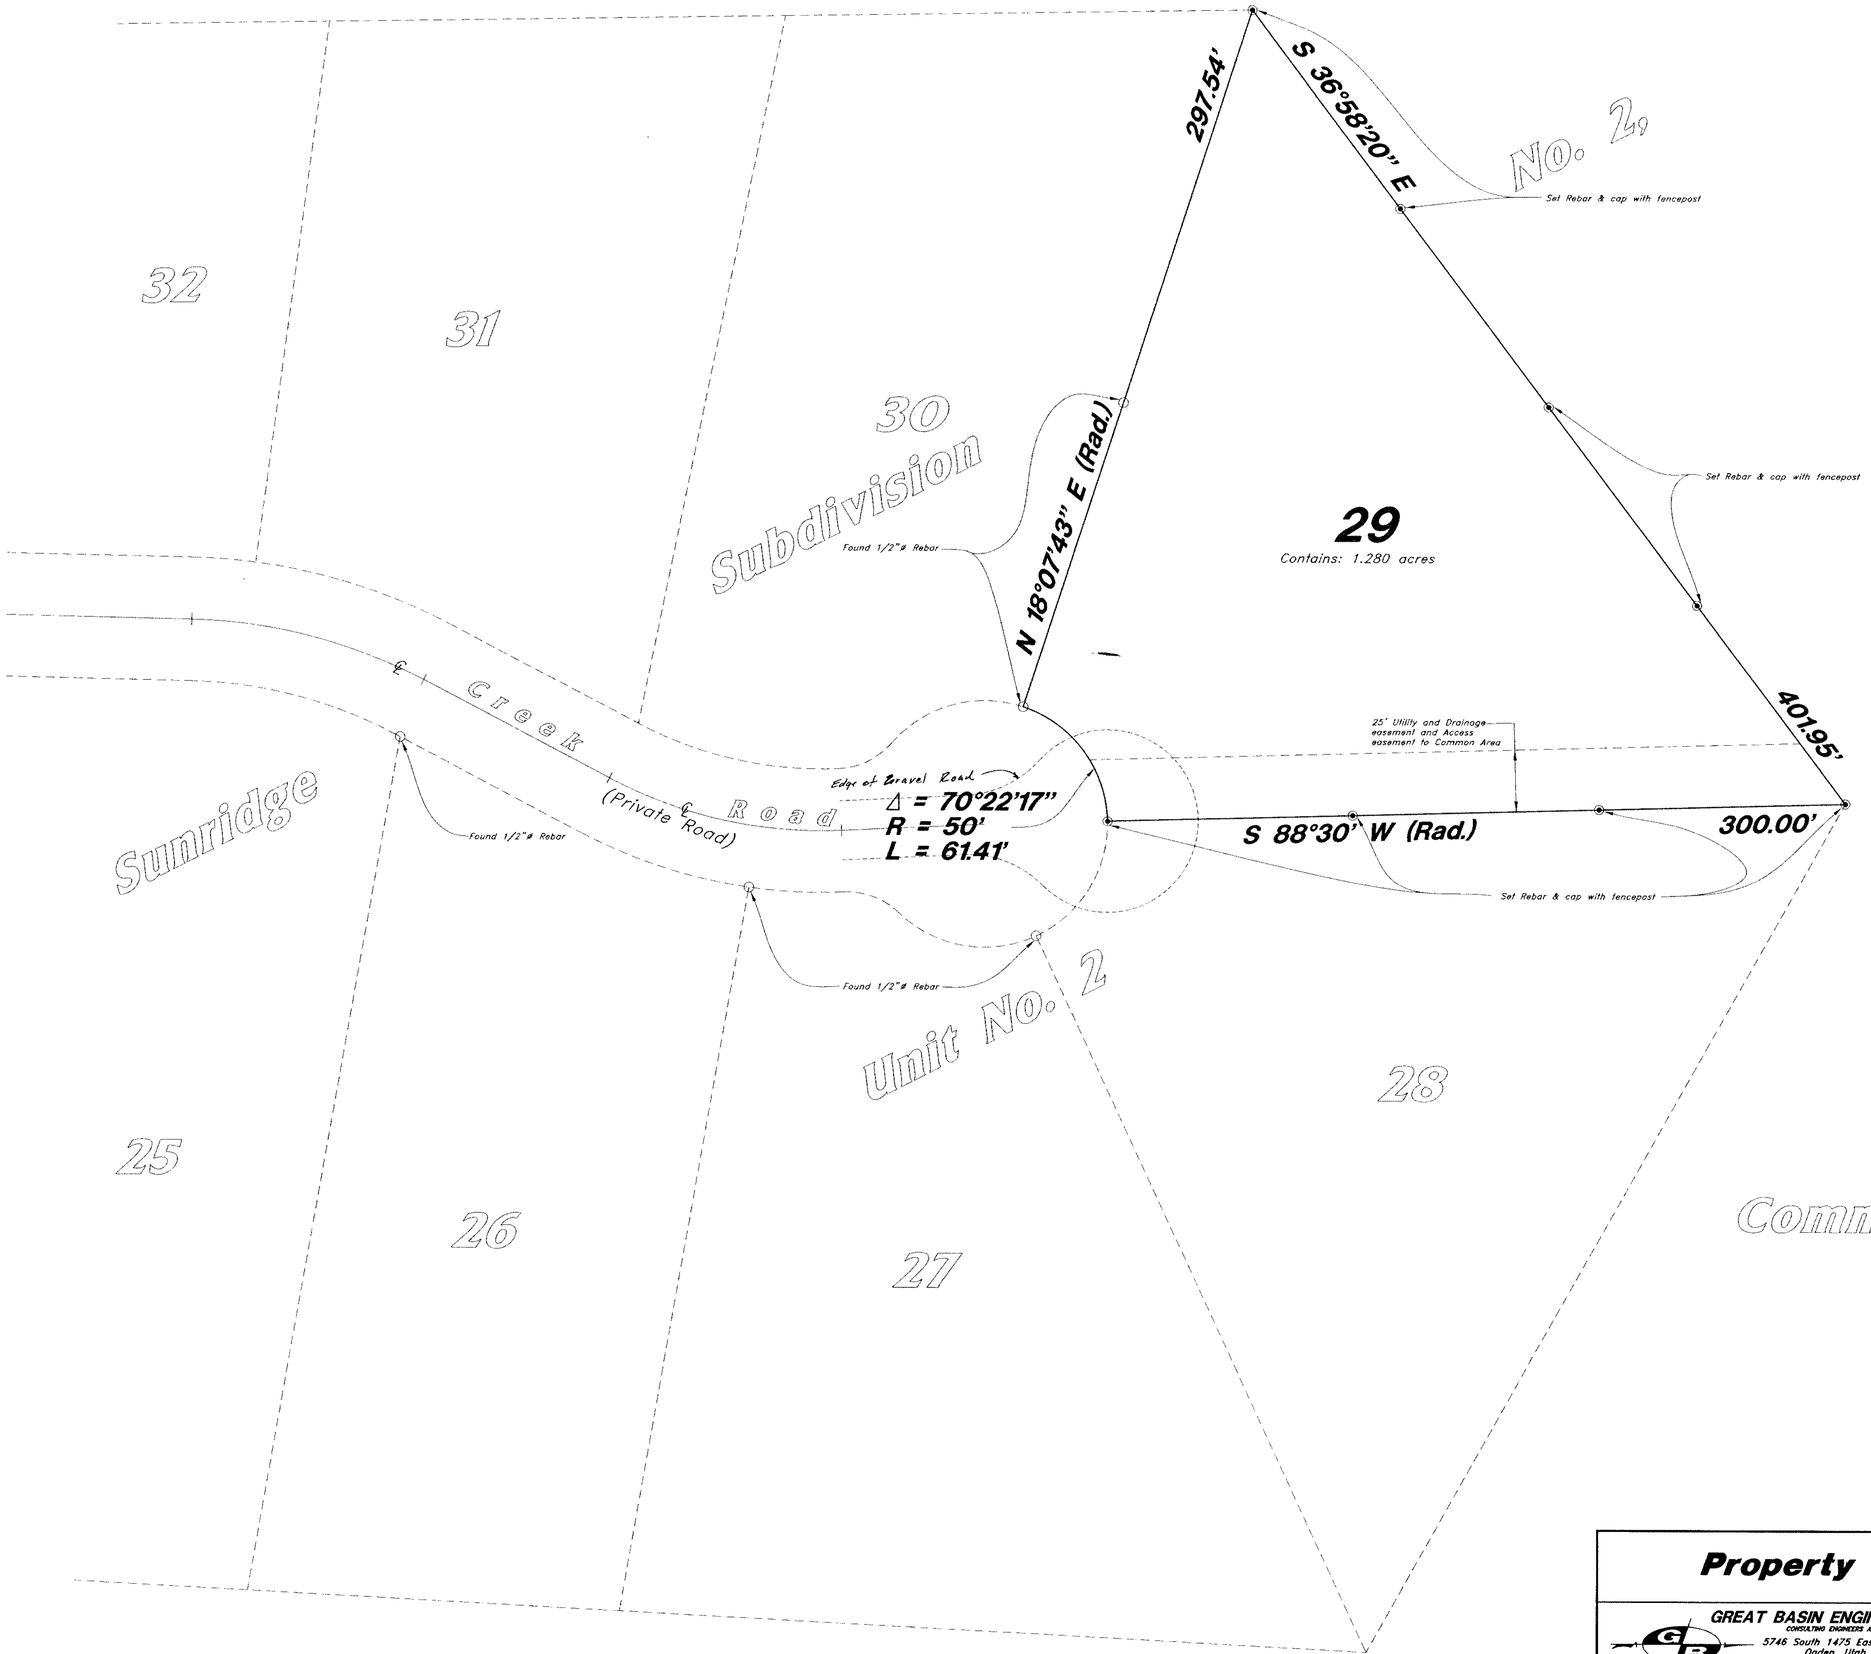

Scale: 1" = 30'

30 0 15 30 40 50 60

Graphic Scale

- Set 5/8"ø Rebar (24" long) & Cap w/ Fencepost
- Found 1/2"ø Rebar
- (Rad.) Radial Line

NARRATIVE

This property survey was requested by Mr. Mark Rose in order to establish his property.

Rebars were found at the front of lots corners of 25/26, 26/27 and 27/28.

Property corners were set as shown on this plat.

CERTIFICATION

I, Mark E. Babbitt, do hereby certify that I am a Registered Land Surveyor, and that I hold Certificate No. 166484, as prescribed by the Laws of the State of Utah and I have made a survey of the above described property. I further certify that this plat correctly shows the true dimensions of the property surveyed.

7-1-05 — Date

REGISTERED LAND SURVEYOR MARK E. BABBITT No. 166484 STATE OF UTAH

Mark E. Babbitt

BOUNDARY DESCRIPTION

All of Lot 29, Sunridge Subdivision No. 2, Unit No. 2, a cluster summer home subdivision in Weber County, according to the official plat thereof.

RECEIVED
JUL 19 05
Weber County Surveyor

003478

Property Survey

Mark Rose

All of Lot 29, Sunridge Subdivision No. 2, Unit No. 2
A part of the Northeast 1/4 of Section 12, T7N, R2E, SLB&M
Weber County, Utah

GREAT BASIN ENGINEERING NORTH
CONSULTING ENGINEERS AND SURVEYORS
5746 South 1475 East – Suite 200
Ogden, Utah 84403
P.O. Box 150048, Ogden, Utah 84415
Ogden (801)394-4515 Salt Lake City (801)521-0222 Fax (801)392-7544

SCALE : 1" = 30'	DATE : 27 Oct, 2004	DRWG. NO.	
DRAWN : ESL	REVISIONS : 1 Jul, 2005		
04N432A			