




**Surveyor's Certificate**

I, CHAD R. MOSER, REGISTERED PROFESSIONAL LAND SURVEYOR IN THE STATE OF UTAH, LICENSE NO. 350503, DO HEREBY CERTIFY THAT THIS PLAT IS A TRUE AND CORRECT REPRESENTATION OF A SURVEY PERFORMED BY ME OR UNDER MY DIRECTION USING DATA COMPILED FROM RECORDS ON FILE IN THE WEBER COUNTY RECORDERS OFFICE, AND FIELD DATA COLLECTED FOR THIS SURVEY.

SIGNED THIS 1<sup>st</sup> DAY OF Aug, 2005.

CHAD R. MOSER

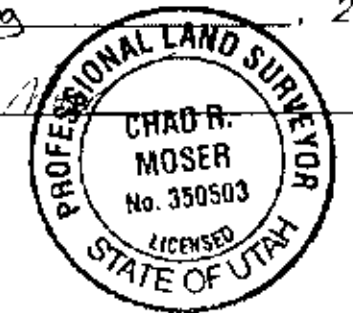

**Narrative**

THE PURPOSE FOR THIS SURVEY WAS TO DETERMINE THE BOUNDARY FOR LOT 3 OF WOLF RIDGE SUBDIVISION PHASE 1, REQUESTED BY KIRK MOORE

**Legal Description**

PART OF THE NORTHWEST QUARTER OF SECTION 22, T.7N., R.1E., S.1.B.&M., U.S. SURVEY, WEBER COUNTY, UTAH.

ALL OF LOT 3, WOLF RIDGE SUBDIVISION PHASE 1

**Basis of Bearings**

THE BASIS OF BEARINGS FOR THIS PLAT IS THE LINE BETWEEN THE NORTHEAST CORNER OF LOT 4 AND THE SOUTHEAST CORNER OF LOT 6 SHOWN HEREON AS S16°00'00\"/>

**Legend**

- = SECTION CORNER
- = SET REBAR AND CAP STAMPED "T.M.V. & ASSOCIATES"
- = FOUND REBAR STAMPED "REEVE & REEVE"
- = BOUNDARY LINE
- = ROAD RIGHT OF WAY LINE
- = ROAD CENTER LINE

**Curve Table**

NUMBER	DELTA	CHORD DIK	TANGENT	RADIUS	ARC LENGTH	CHD LENGTH
C1	27°17'02"	N44°24'54"W	43.69	180.00	85.71	84.91

RECEIVED  
AUG 01 2005  
Weber County Surveyor

**REVISIONS**

1. WEAR TA B 1 GS	4.
2.	5.
3.	6.

PROJECT NO.: 5126-01 SURVEYOR: C. MOSER  
DATE: 7-29-05 DRAWN: N. ANDERSON  
SCALE: 1"=30' CHECKED:

**REEVE & ASSOCIATES, INC.**  
Civil Engineering • Structural Engineering  
Surveying • Land Planning • Landscape Architecture  
EXECUTIVE BLDG., 4155 S. HARRISON BLVD., #110  
DODD, UTAH 84403  
(801) 621-3100 FAX (801) 621-2666

**RECORD OF SURVEY**

**Lot 3 of Wolf Ridge Subdivision Phase 1**  
PART OF THE NORTHWEST QUARTER OF SECTION 22, T.7N., R.1E., S.1.B.&M., U.S. SURVEY, WEBER COUNTY, UTAH  
JULY, 2005

SHEET	1
1	1
SHEETS	