

- Legend**
- = EXISTING BUILDING
  - x - x - = EXISTING FENCE
  - ◆ = SECTION CORNER
  - = FOUND & FLAGGED REBAR

**Basis of Bearings**

BASIS OF BEARINGS IS DETERMINED BETWEEN TWO FOUND CORNERS ON THE NORTH LINE OF THE BLANCHARD SUBDIVISION SHOWN HERON AS S89°02'06\"

**Boundary Description**


PART OF THE NORTHWEST QUARTER OF SECTION 2, TOWNSHIP 6 NORTH, RANGE 1 EAST, SALT LAKE BASE AND MERIDIAN:

ALL OF LOT 1 AND ALL OF LOT 2 OF THE BLANCHARD SUBDIVISION, EDEN DISTRICT, WEBER COUNTY, UTAH.

**Surveyor's Certificate**

I, DARYL N. PENROD, DO HEREBY CERTIFY THAT I AM A PROFESSIONAL LAND SURVEYOR AND THAT I HOLD CERTIFICAT NO. 5331527 AS PRESCRIBED UNDER THE LAWS OF THE STATE OF UTAH. I FURTHER CERTIFY THAT A SURVEY HAS BEEN MADE BY ME, OR UNDER MY DIRECTION OF THE LAND SHOWN AND DESCRIBED HEREON. I FURTHER CERTIFY THAT THIS PLAT IS A CORRECT REPRESENTATION OF THE LAND SURVEYED AND HAS BEEN PREPARED IN CONFORMITY WITH THE MINIMUM STANDARDS AND REQUIREMENTS OF THE LAW.

*Daryl N. Penrod*      *September 7th 2005*  
 DARYL N. PENROD      DATE

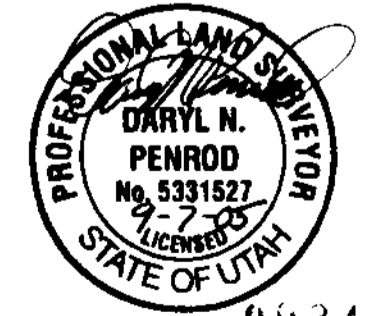

RECEIVED  
 SEP 08 2005  
 WEBER CO SURVEYOR

THESE PLANS AND SPECIFICATIONS ARE THE PROPERTY OF REEVE & ASSOC., INC., EXECUTIVE BLDG., 4155 S. HARRISON BLVD. #310 OGDEN UTAH, 84403 AND SHALL NOT BE COPIED OR REDUCED OR REPRODUCED WITHOUT THEIR WRITTEN PERMISSION.

**REVISIONS**

1. 09-06-05 (MAYAR) LM	4. _____
2. _____	5. _____
3. _____	6. _____

PROJECT NO.: 5106-01      SURVEYOR: D. PENROD  
 DATE: 08-21-2005      DRAWN: N. JOHNSON  
 SCALE: 1"=30'      CHECKED: \_\_\_\_\_

**REEVE & ASSOCIATES, INC.**  
 Civil Engineering \* Structural Engineering  
 Surveying \* Land Planning \* Landscape Architecture  
 EXECUTIVE BLDG., 4155 S. HARRISON BLVD., #310  
 OGDEN, UTAH 84403  
 (801) 621-3100 FAX (801) 621-2666

**BOUNDARY EXHIBIT**

**SURVEY for SANDRA BAGLEY**  
 PAR OF THE NORTHWEST QUARTER OF SECTION 2, T.6N., R.1E., S.L.B.&M., U.S. SURVEY  
 EDEN DISTRICT, WEBER COUNTY, UTAH  
 JUNE, 2005