


**Narrative**  
 The purpose of this survey was to establish and set the property corners of the parcel as shown and described hereon. The survey was ordered by Mark Greenhal of Five View (South Ogden Conservation District). The control used to establish the property corners was the existing Weber County Survey Monumentation surrounding Section 17, T3N, R1W, SLB&M. The basis of bearing is the East line of the Northeast quarter of said Section which bears North 00°53'08" East.

**RECEIVED**  
 NOV 21 2005  
 WEBER CO SURVEYOR

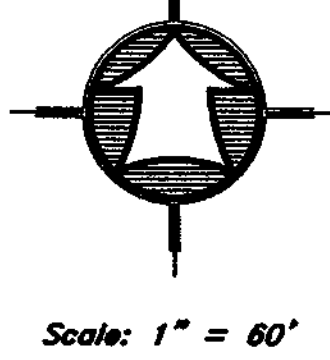

Scale: 1" = 60'

- LEGEND:**
- PROPERTY LINE
  - CENTERLINE
  - CURB & GUTTER
  - EDGE OF PAVEMENT
  - DITCH
  - FENCE LINE
  - STREET MONUMENT
  - SET 5/8" REBAR W/ CAP

**SURVEY CERTIFICATE**

I, K. Greg Hansen, do hereby certify that I am a Registered Land Surveyor, and that I hold Certificate No. 167819 as prescribed by the Laws of the State of Utah, and that I have made and/or Supervised the survey of the property shown and described hereon and that this plat is a true and correct representation of said survey to the best of my knowledge and belief.

K. Greg Hansen, RLS. No. 167819  
 K. GREG HANSEN  
 Nov. 8, 2005  
 date

**PROPERTY SURVEY FOR**  
**South Ogden Conservation Dist.**  
 5200 South Pointe Drive  
 Washington Terrace, Weber Co., Utah  
 A PART OF THE NORTHEAST QUARTER OF SECTION 17,  
 TOWNSHIP 5 NORTH, RANGE WEST, S.L.B. & M.

Drawn By: Keith	Date: 08/01/05
Designed By:	
Checked By:	
Approved By:	
Scale: 1" = 60'	
Drawing File: 05-3-213.dwg	
JOB NUMBER: 05-3-3-213	

**HANSEN & ASSOCIATES, INC.**  
 Consulting Engineers and Land Surveyors  
 538 North Main  
 Brigham City, Utah 84302  
 Brigham City Ogden Logan  
 (435)725-3491 (801)599-4905 (435)752-8272

No.	Date	By	Revision

**SHEET**  
**1**  
 OF  
**1**  
**SHEETS**