

Fnd. Weber County Survey
Brass Cap Monument 1961
No. 1/4 Cor. of Section 29,
T. 7 N., R. 1 E., SLB&M

Fnd. Weber County Survey
Brass Cap Monument 1961
NE Corner of Section 29,
T. 7 N., R. 1 E., SLB&M

Fnd. Weber County Survey
Brass Cap Monument 1976
No. 1/4 Cor. of Section 28,
T. 7 N., R. 1 E., SLB&M

(a)	(b)	(c)	(d)
$\Delta = 35^{\circ}22'18''$	$\Delta = 6^{\circ}32'58''$	$\Delta = 37^{\circ}32'03''$	$\Delta = 14^{\circ}52'00''$
$R = 327.03'$	$R = 2897.90'$	$R = 360.03'$	$R = 2864.90'$
$L = 201.89'$	$L = 331.26'$	$L = 235.85'$	$L = 743.36'$
$LC = 198.70'$	$LC = 331.08'$	$LC = 231.66'$	$LC = 741.28'$
$N 70^{\circ}48'03'' E$	$S 60^{\circ}54'54'' E$	$N 71^{\circ}53'57'' E$	$S 61^{\circ}43'25'' E$

RECEIVED
AUG 23 2006
REC'D SURV

Drawn By: kath Date: 03/22/06
Designed By:
Checked By:
Approved By:
Scale: 1" = 60'
Drawing File: 06-3-35.dwg
JOB NUMBER: 06-3-33

PROPERTY SURVEY FOR
Darold Harris
3319 North Highway 162
Liberty, Weber County, Utah
A PART OF THE NW 1/4 OF SEC. 28 & NE 1/4 SEC. 29,
TOWNSHIP 7 NORTH, RANGE 1 EAST S.L.B.& M.


SHEET
1
OF
1
SHEETS

No.	Date	By	Revision

HANSEN & ASSOCIATES, INC.
Consulting Engineers and Land Surveyors
550 North Main
67 East 100 North
Brigham City
(435) 723-3491
(435) 723-7663
Ogden
(801) 399-4905
(435) 752-8772

LEGEND:

 PROPERTY LINE
 CENTERLINE
 EDGE OF PAVEMENT
 DITCH
 FENCE LINE
 HWY R-O-W MONUMENT
 SET 5/8" REBAR W/ CAP
 SET 05/16/08

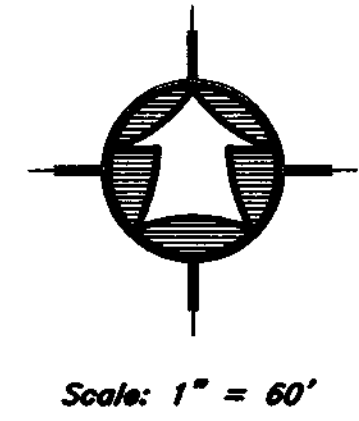

SURVEY CERTIFICATE

I, K. Greg Hansen, do hereby certify that I am a Registered Land Surveyor, and that I hold Certificate No. 167819 as prescribed by the Laws of the State of Utah, and that I have made and/or supervised the survey of the property shown and described hereon and that this plot is a true and correct representation of said survey to the best of my knowledge and belief.

K. Greg Hansen,
R.L.S. No. 167819
K. GREG HANSEN
167819
date 11/17/2006

003670

Narrative
The purpose of this survey was to establish and set the property corners of the parcel as shown and described hereon. The survey was ordered by Darold Harris. Both of his parcels, 22-022-0071 and 22-023-0007 describe property to the centerline of the highway and 3300 North. This survey corrects the descriptions to remove those parcels. The control used to establish the property corners was the existing Weber County Monumentation surrounding Section 28 & 29, T7N, R1E, SLB&M. The basis of bearing is the North line of the northeast quarter of said Section 29 which bears north 89°39'42" west.

Fnd. Weber County Survey
Brass Cap Monument
SE Corner of Section 29,
T. 7 N., R. 1 E., SLB&M