
## RECORD OF SURVEY

### THE SOUTH 95' OF LOTS 1-4, BL. 4, DENVER PLACE ADDITION, OGDEN CITY, WEBER COUNTY, UTAH

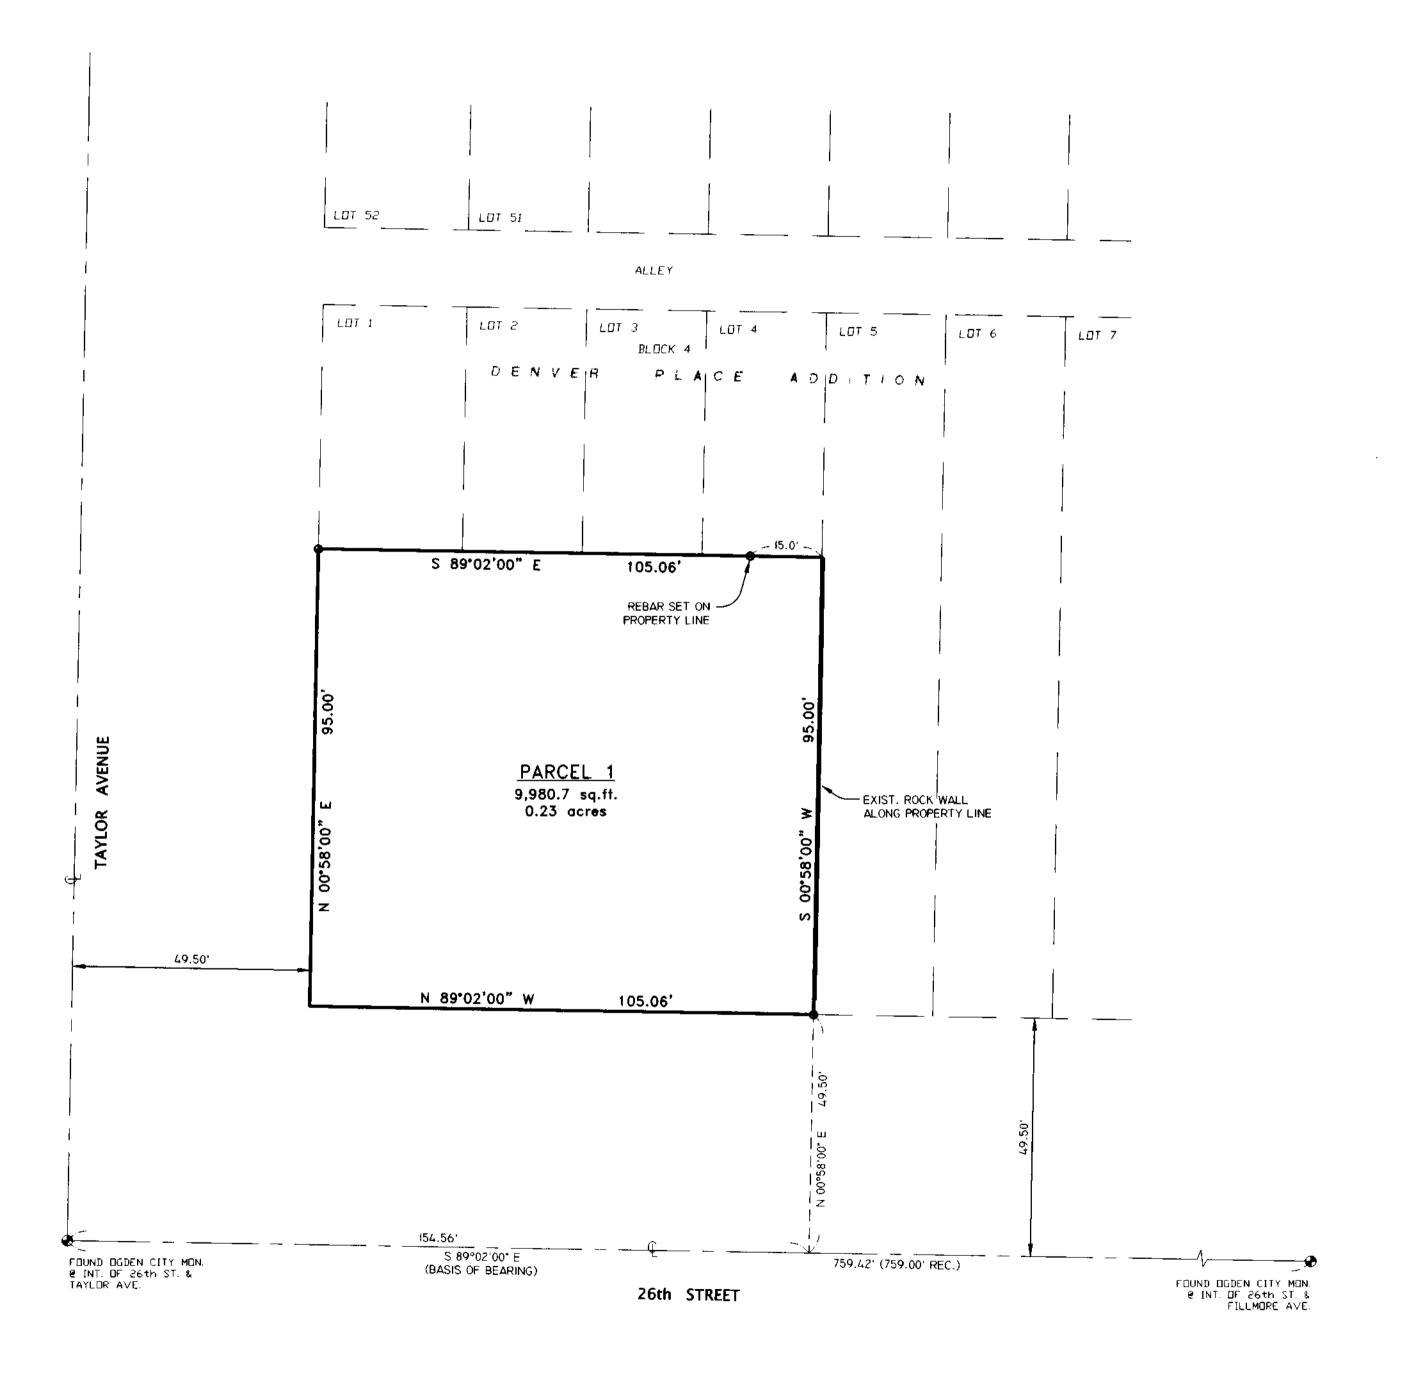

#### SURVEYOR'S CERTIFICATE

I, <u>DOUG L. GRAHAM</u>, A PROFESSIONAL LICENSED LAND SURVEYOR AS PRESCRIBED BY THE LAWS OF THE STATE OF UTAH AND HOLDING LICENSE NUMBER <u>172757</u>, DO HEREBY CERTIFY THAT A SURVEY OF THE BELOW DESCRIBED PROPERTY HAS BEEN MADE BY MYSELF OR UNDER MY DIRECTION AND THE PLAT HEREON IS A TRUE AND CORRECT REPRESENTATION OF SAID SURVEY.

DATE: 09/15/06 SI



#### PARCEL I BOUNDARY DESCRIPTION

THE SOUTH 95 FEET OF LOTS 1 TO 4, BLOCK 4, DENVER PLACE ADDITION, OGDEN CITY, WEBER COUNTY, UTAH.
CONTAINS 0.23 ACRES.

#### NARRATIVE

THE PURPOSE OF THIS SURVEY WAS TO DETERMINE THE BOUNDARY OF THIS PARCEL AS SHOWN. BASIS OF BEARING IS OGDEN CITY MONUMENTATION.

003685

RECEIVED

SEP 1 8 2006

WEBER CO SURVEYOR



# LANDMARK SURVEYING, INC. A COMPLETE LAND SURVEYING SERVICE 16 S. 3500 W. #A-3, WEST HAVEN, UTAH 844

4646 S. 3500 W. #A-3, WEST HAVEN, UTAH 84401 PHONE 801-731-4075 FAX 801-731-8506

CLIENT: RICHARD REED

LOCATION: THE SOUTH 95' OF LOTS 1-4, BLOCK 4, DENVER PLACE ADD., OGDEN CITY, UT.

SURVEYED: AUG 2004

REVISIONS:	DRAWN BY: L.A.
	CHECKED BY: D.L.G.
	DATE: 08-09-04
	FILE: 2628-ROS.DWG

SCALE: 1" = 20'

O = 5/8"Øx24" LENGTH REBAR WITH CAP STAMPED 172757