



CERTIFICATION OF SURVEY

003722

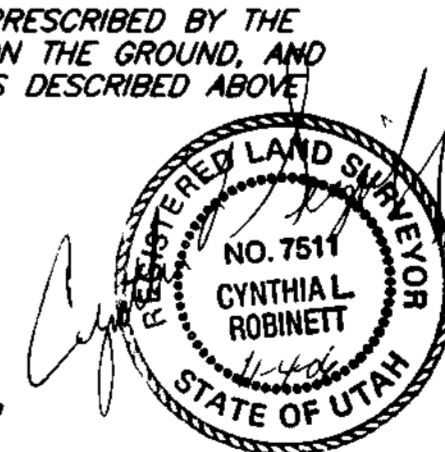

Scale: 1" = 30'

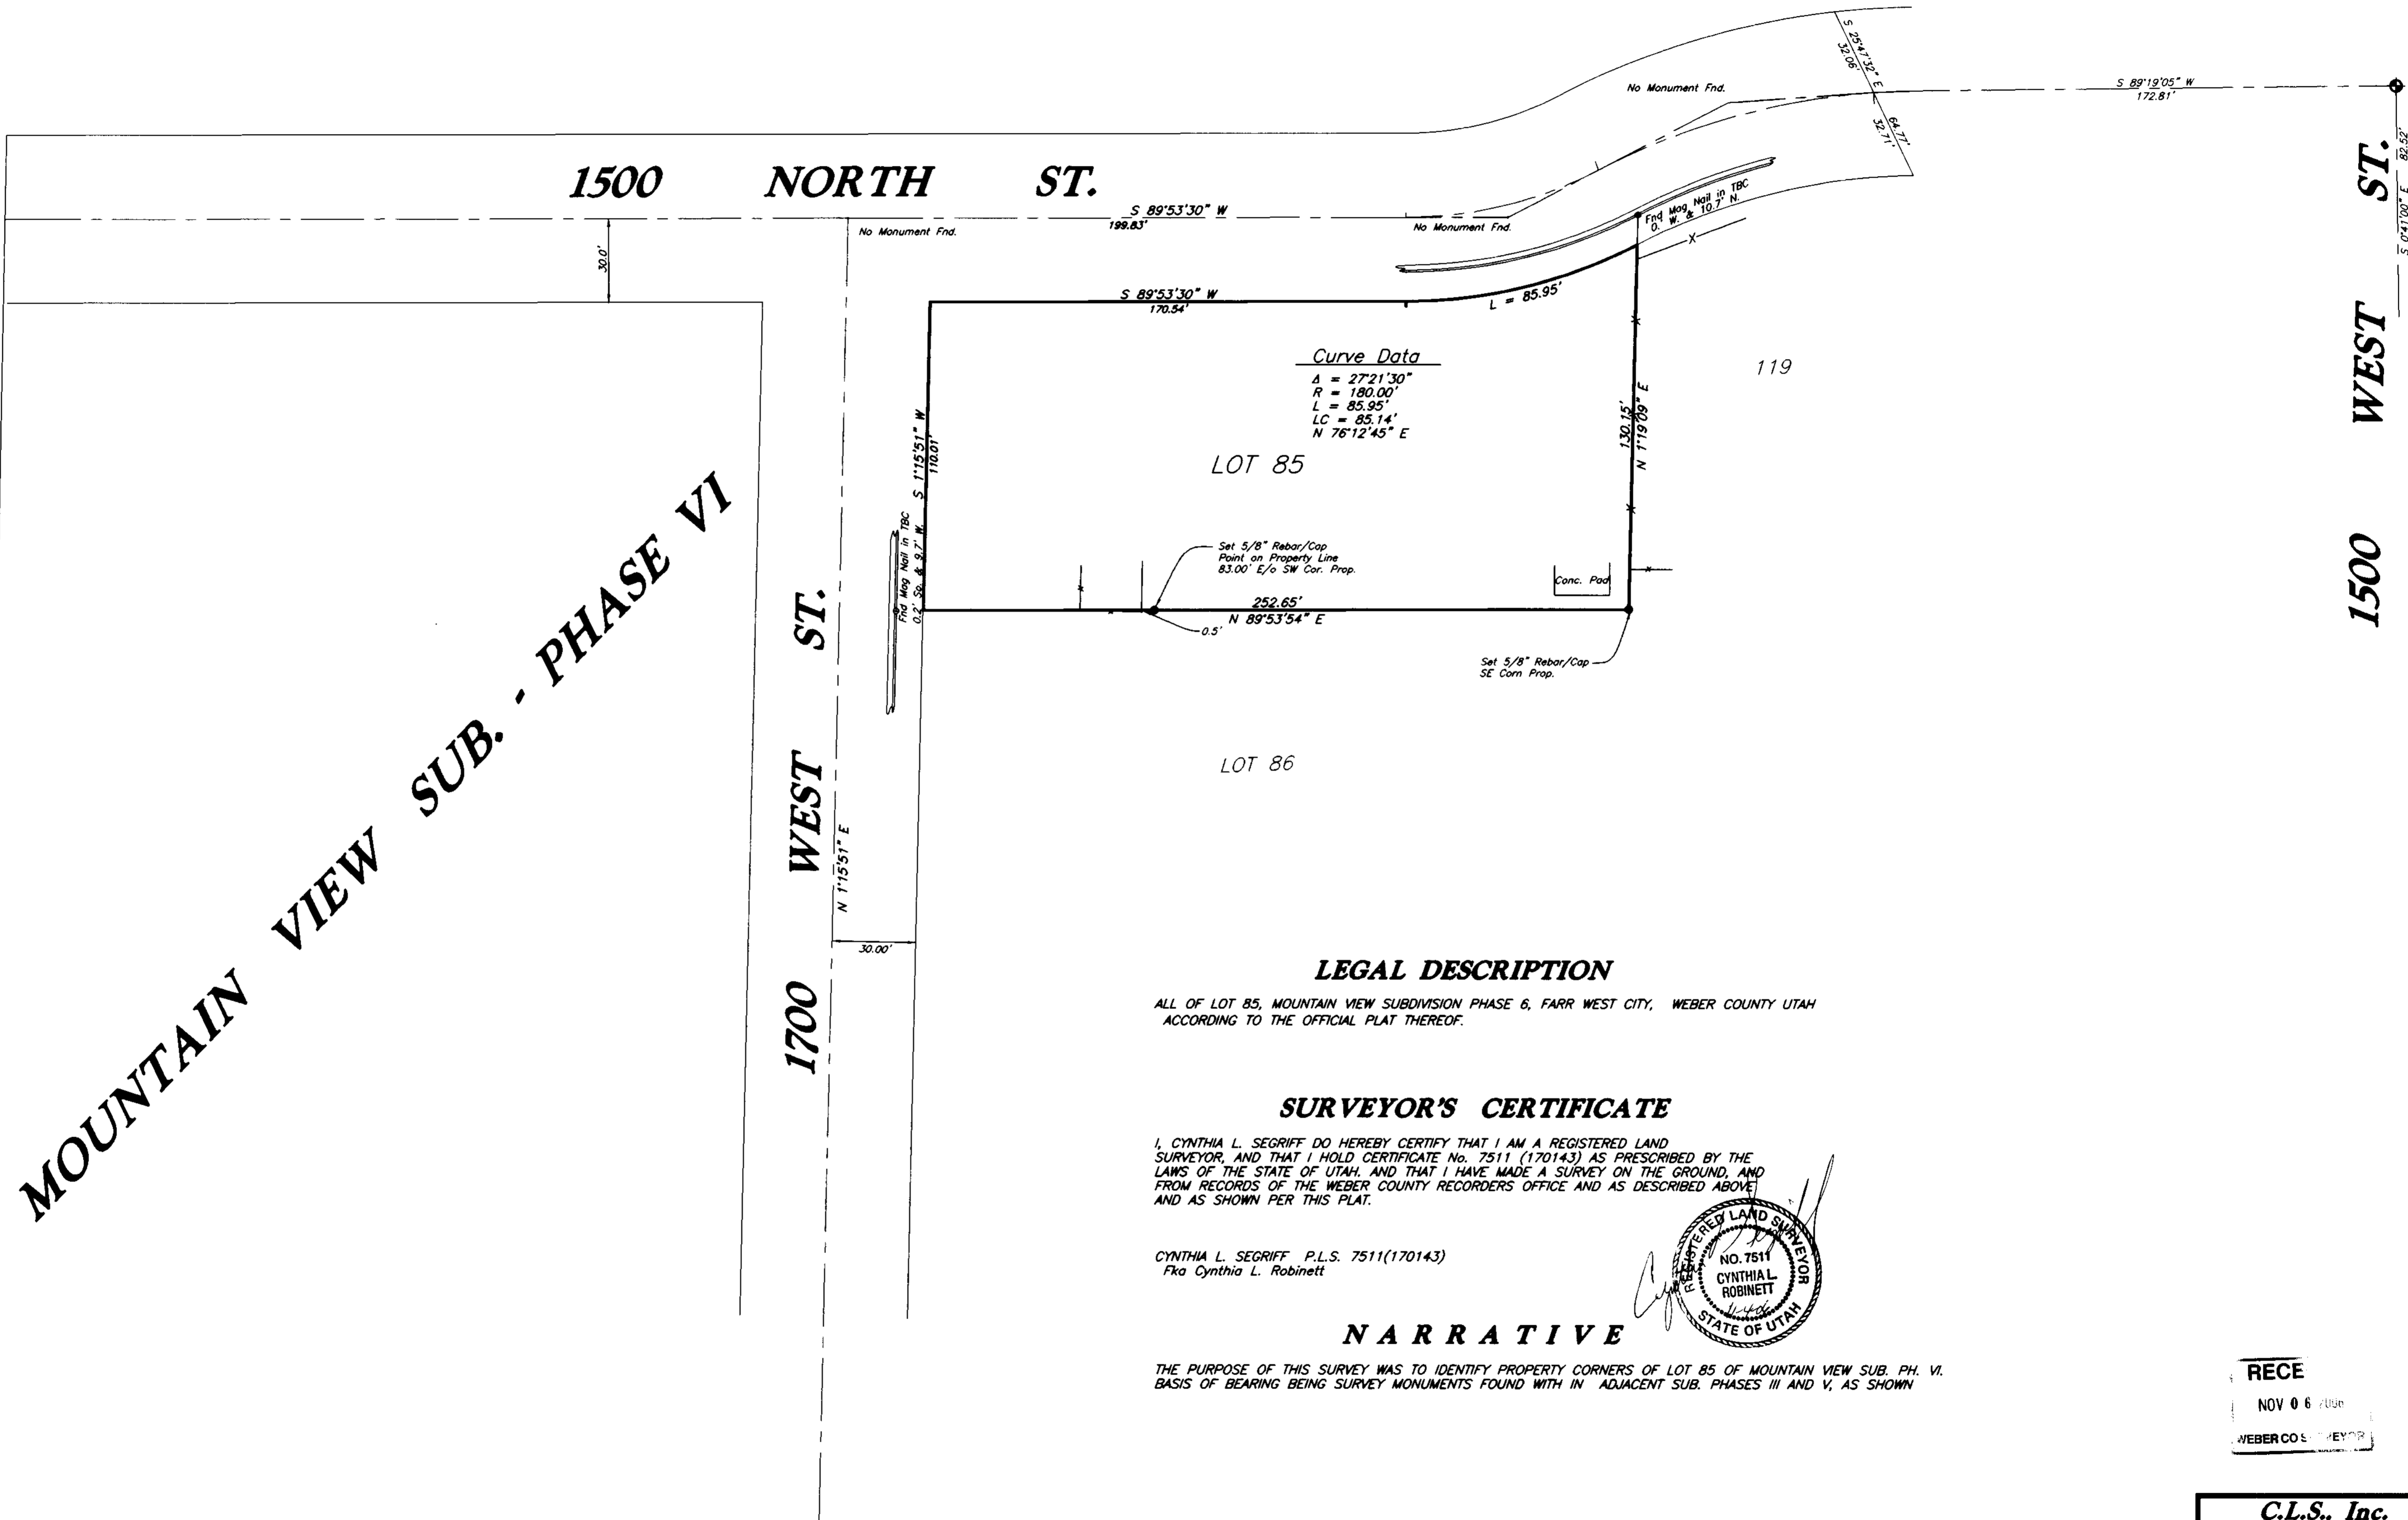

RECE
NOV 06 2006

PREPARED BY:
C.L.S. Inc.
810 CANYON ROAD
OGDEN, UTAH 84404
Ph. (801) 399-4935 Fax. (801) 627-1068

C.L.S., Inc.
810 CANYON ROAD
OGDEN, UTAH 84404
(801) 399-4935

CLIENT: ANN BROWN

SURVEY LOCATION:
SOUTH HALF SEC. 1,
TOWNSHIP 6 NORTH, RANGE 2 WEST,
SALT LAKE BASE & MERIDIAN

SURVEY DATE: 2/27/06