


NORTHWEST CORNER OF SECTION 32, T.7N., R.1W., S.L.B.&M., U.S. SURVEY. FOUND

**Surveyor's Certificate**

I, CHAD R. MOSER, DO HEREBY CERTIFY THAT I AM A REGISTERED PROFESSIONAL LAND SURVEYOR IN THE STATE OF UTAH IN ACCORDANCE WITH TITLE 58, CHAPTER 22, PROFESSIONAL ENGINEERS AND LAND SURVEYORS ACT; AND THAT I HAVE COMPLETED A SURVEY OF THE PROPERTY DESCRIBED ON THIS PLAT IN ACCORDANCE WITH SECTION 17-23-17 AND HAVE VERIFIED ALL MEASUREMENTS, AND HAVE PLACED MONUMENTS AS REPRESENTED ON THIS PLAT. I FURTHER CERTIFY THAT THIS PLAT IS A CORRECT REPRESENTATION OF THE LAND SURVEYED AND HAS BEEN PREPARED IN CONFORMITY WITH THE MINIMUM STANDARDS AND REQUIREMENTS OF THE LAW.

SIGNED THIS 30<sup>th</sup> DAY OF October, 2006.

350503  
UTAH LICENSE NUMBER

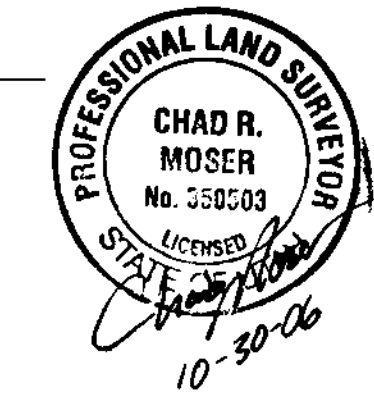

*Chad R. Moser*  
CHAD R. MOSER



S01°10'34\"/>

WEST QUARTER CORNER OF SECTION 32, T.7N., R.1W., S.L.B.&M., U.S. SURVEY. FOUND

EAST 1273.79'

**Basis of Bearings**

THE BASIS OF BEARINGS FOR THIS PLAT IS THE SECTION LINE BETWEEN THE NORTHWEST CORNER AND THE WEST QUARTER CORNER OF SECTION 32, T.7N., R.1W., S.L.B.&M., U.S. SURVEY

**Narrative**


THE PURPOSE OF THIS PLAT IS TO DETERMINE THE BOUNDARY OF LOTS 15 AND 16 OF WHITE BARN COUNTRY CLUB P.R.U.D. SUBDIVISION. ALL LOT CORNERS WERE SET WITH A 5/8\"/>

**Boundary Description**

PART OF THE WEST HALF OF SECTION 29, T.7N., R.1W., S.L.B.&M., U.S. SURVEY. DESCRIBED AS FOLLOWS:  
ALL OF LOT 15, WHITE BARN COUNTRY CLUB P.R.U.D. SUBDIVISION PHASE IV, PLEASANT VIEW CITY, WEBER COUNTY, UTAH  
ALL OF LOT 16, WHITE BARN COUNTRY CLUB P.R.U.D. SUBDIVISION PHASE IV, PLEASANT VIEW CITY, WEBER COUNTY, UTAH

**Legend**

- = SECTION CORNER
- = SET 5/8\"/>

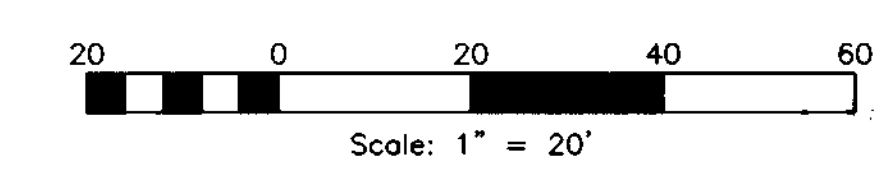

| REVISIONS | DESCRIPTION |
|-----------|-------------|
| DATE      |             |
|           |             |
|           |             |
|           |             |
|           |             |

**Lot 15 & 16 of White Barn Country Club P.R.U.D. Subdivision**  
PLEASANT VIEW CITY, WEBER COUNTY, UTAH  
**Record of Survey**

**Project Info.**

|             |                  |
|-------------|------------------|
| Surveyor:   | C. MOSER         |
| Designer:   | N. ANDERSON      |
| Begin Date: | 10-23-06         |
| Name:       | WHITE ROCK HOMES |
| Scale:      | 1"=20'           |
| Checked:    |                  |
| Number:     | 5047-03          |