

SCALE: 1" = 30'

○ = 5/8"Ø x 24" LENGTH REBAR WITH CAP STAMPED 172757

NORTH QUARTER CORNER
SECTION 15, T.5N., R.2W., S.L.B.&M.
FOUND WEBER CO. MONUMENT

N00°03'00"E (WEAVER SUBDIVISION PLAT BEARING)
2639.70

3100 WEST STREET

N00°03'00"E
177.00

CENTER OF
SECTION 15, T.5N., R.2W., S.L.B.&M.
FOUND WEBER CO. MONUMENT

5200 SOUTH ST.

SURVEYOR'S CERTIFICATE

I, **DOUG L. GRAHAM**, A PROFESSIONAL LICENCED LAND SURVEYOR AS PRESCRIBED BY THE LAWS OF THE STATE OF UTAH AND HOLDING LICENCE NUMBER **172757**, DO HEREBY CERTIFY THAT A SURVEY OF THE DESCRIBED PROPERTY WAS MADE BY MYSELF OR UNDER MY DIRECTION AND THE PLAT HEREON IS A TRUE AND CORRECT REPRESENTATION OF SAID SURVEY.

DATE: *11/13/06*




BOUNDARY DESCRIPTION

A PART OF THE NORTHWEST QUARTER OF SECTION 15, TOWNSHIP 5 NORTH RANGE 2 WEST, SALT LAKE BASE AND MERIDIAN, U.S. SURVEY BEING FURTHER DESCRIBED AS ALL OF LOT 1 AND 2 WEAVER SUBDIVISION IN ROY CITY, WEBER COUNTY, UTAH, ACCORDING TO THE OFFICIAL PLAT THEREOF.

NARRATIVE

THE PURPOSE OF THIS SURVEY WAS TO SET THE LOT CORNERS OF LOT 1 AND 2 OF WEAVER SUBDIVISION. THE LOTS WERE STAKED ACCORDING TO THE PLAT DIMENSIONS AND BEARINGS.

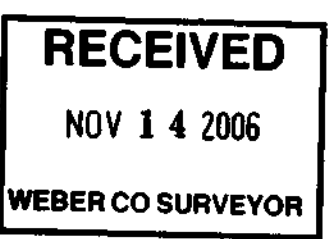

LANDMARK SURVEYING INC.
A COMPLETE LAND DEVELOPMENT SERVICE
4646 S. 3500 W. #A-3, WEST HAVEN, UTAH 84401
PHONE 801-731-4075

CLIENT: MIKE SHULTZ
LOCATION: PART OF THE NW 1/4 OF SEC.15,
T.5 N., R.2 W., S.L.B.&M.
SURVEYED: MARCH 28, 2005

REVISIONS:	DRAWN BY: D.G.
	CHECKED BY: D.G.
	DATE: APRIL 18, 2005
	FILE: 2699SCHULTZ

003741

003741