


Martha Markis
 A PART OF THE NORTHWEST QUARTER OF SECTION 14, TOWNSHIP 5 NORTH, RANGE 1 WEST OF THE SALT LAKE BASE AND MERIDIAN, LOT 24, CHARENTON COVE P.R.U.D. SUBDIVISION NO. A AMENDED, OGDEN, WEBER COUNTY, UTAH SURVEY.

Narrative

The purpose of this survey was to establish and set the property corners of the parcel as shown and described hereon. The survey was ordered by Martha Markis. The control used to establish the property corners was the existing Ogden City Survey Monumentation along the centerline of Charenton Cove Circle which is the base of bearing assumed to bear North 00°28'55" East.

RECEIVED
 DEC 08 2006
 WEBER CO SURVEYOR

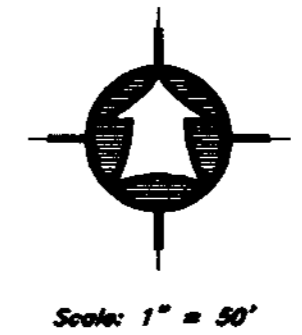

LEGEND:

	PROPERTY LINE
	CENTERLINE
	CURB & GUTTER
	EDGE OF PAVEMENT
	DITCH
	FENCE LINE
	STREET MONUMENT
	SET 5/8" REBAR W/ CAP
	SET 07/27/06

SURVEY CERTIFICATE

I, K. Greg Hansen, do hereby certify that I am a Registered Land Surveyor, and that I hold Certificate No. 167819 as prescribed by the Laws of the State of Utah, and that I have made and/or Supervised the survey of the property shown and described hereon and that this plat is a true and correct representation of said survey to the best of my knowledge and belief.

K. Greg Hansen, RLS No. 167819
 L. GREG HANSEN
 REGISTERED LAND SURVEYOR
 STATE OF UTAH
 Nov. 22, 2006 date

HANSEN & ASSOCIATES, INC. Consulting Engineers and Land Surveyors 538 North Main Brigham City, Utah 84302 67 East 100 North Logan, Utah 84321 Brigham City Ogden (435) 752-9197 (435) 723-3491 (435) 752-7663 (801) 399-4905 (435) 752-8272	
Drawn By: <u>Kath</u> Date: <u>07/31/06</u> Designed By: _____ Checked By: _____ Approved By: _____ Scale: 1" = 50' Drawing File: <u>06-2-136.dwg</u> JOB NUMBER: <u>06-3-126</u>	PROPERTY SURVEY FOR Martha Markis 5024 Charenton Cove Circle Ogden, Weber County, Utah A Part of the Northwest Quarter of Section 14, T 5 N., R 1 W., S.L.B.&M.
SHEET 1 OF 1 SHEETS	No. _____ Date _____ By _____ Revision _____