


DESCRIPTION

BEING A PART OF THE WEST HALF OF SECTION 30, TOWNSHIP 7 NORTH, RANGE 1 WEST, S.L.B.&M.: BEGINNING AT A POINT 805.2 FEET EAST OF THE NORTHWEST CORNER OF THE SOUTHWEST QUARTER OF SAID SECTION; RUNNING THENCE, S.01°33'00\"/>


CONTAINS 6.09 ACRES, MORE OR LESS.

NARRATIVE AND STATEMENT OF PURPOSE

AT THE REQUEST OF WASATCH CIVIL CONSULTING ENGINEERING, A SURVEY OF THE HEREON DESCRIBED PROPERTY WAS UNDERTAKEN. THE PURPOSE OF THIS SURVEY WAS TO DETERMINE THE BOUNDARY TO FACILITATE THE SUBDIVISION OF THE PROPERTY. SURVEYS OF THE WEBER COUNTY SCHOOL DISTRICT PROPERTY, PERFORMED BY HANSEN AND ASSOC., AND THE STEPHEN JENSEN SUBDIVISION NO. 2, PERFORMED BY MOUNTAIN WEST PROFESSIONAL LAND SURVEYORS, P.C., WERE HONORED. ALSO HONORED WERE SURVEYS OF THE MILLER AND BARKER FAMILY PROPERTIES PERFORMED BY MOUNTAIN WEST PROFESSIONAL LAND SURVEYORS, P.C. DEED DESCRIPTIONS OVERLAP AND LEAVE GAPS AND IN GENERAL DO NOT FIT OCCUPATIONS OR CALLS FOR ADJOINERS. EVERY EFFORT TO CLEANUP AND RECTIFY ANY INCONGRUITIES IN THESE DESCRIPTIONS WAS MADE. THE BASIS OF BEARING IS THE WEST LINE OF THE NORTHWEST QUARTER OF SECTION 30 AS MONUMENTED BY WEBER COUNTY.

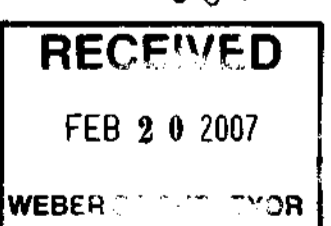

- LEGEND:
- DENOTES A SET #5 CAPPED REBAR, 24" LONG
  - DENOTES A FOUND CAPPED REBAR
  - x — x — EXISTING FENCE
  - - - - - DESCRIBED LINES
  - — — — — PROPERTY BOUNDARY

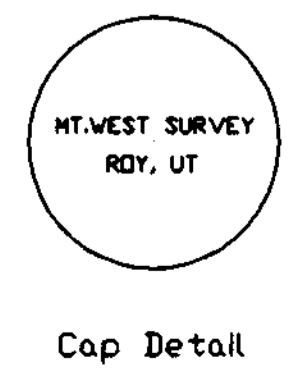

SURVEYOR'S CERTIFICATE  
 I, DICK N. MECHEM, DO HEREBY CERTIFY THAT I AM A PROFESSIONAL LAND SURVEYOR OF THE STATE OF UTAH, HOLDING LICENSE NUMBER 155649 AND THAT THIS MAP IS A TRUE AND COMPLETE REPRESENTATION OF A SURVEY MADE BY ME, OR UNDER MY SUPERVISION, AT THE REQUEST OF WASATCH CIVIL AND IN BEHALF OF MOUNTAIN WEST SURVEYING & MAPPING, INC. ALL MONUMENTS SHOWN HEREON ARE OF THE CHARACTER AND OCCUPY THE POSITIONS INDICATED, AND ARE SUFFICIENT TO ENABLE THE SURVEY TO BE RETRACED.

*Dick N. Mechem*  
 DICK N. MECHEM, P.E.S.  
 DATE: *Nov 23 2006*

**RECORD OF SURVEY**  
 for  
**WASATCH CIVIL**  
 Consulting Engineering

Located In The Northwest One-Quarter of Section 30,  
 Township 7 North, Range 1 West, S.L.B.&M.

Date Nov.2006 No. 12B-01-06 Draw: DJM Check: DRH/JJH

MtnWest Surveying & Mapping Inc. 1825 W. 4400 S. PO Box 897  
 Roy, Utah 84067  
 Phone: (801) 731-5330 Fax: (801) 731-5331