

NO.	DESCRIPTIONS	DATE
1	TITLE COMPANY COMMENTS	10/12/06
2	FENCE DIMENSIONS	10/25/06





TIME: A.L.T.A./A.C.S.M. LAND TITLE SURVEY
CLIENT: Cherry Creek Associates, L.L.C.
PROJECT LOCATION: N 1/2 Sec. 13, T5N, R2W, SL2RM (1551 W. Riverdale Rd., Riverdale, UT)

The Contractor shall supply and be responsible for all labor and materials required to complete the drawing. Any errors or omissions shall be reported to Surveyor or Owner. Reproduction or use for other purposes, other than that authorized by Surveyor, is prohibited.



SCALE 1"-50' DR BY ECN DATE 01/29/06 OK BY TMW FILE V:152868 (active 156334220) (drawing)

COPYRIGHT © 2005 - STANTEC
1 OF 2

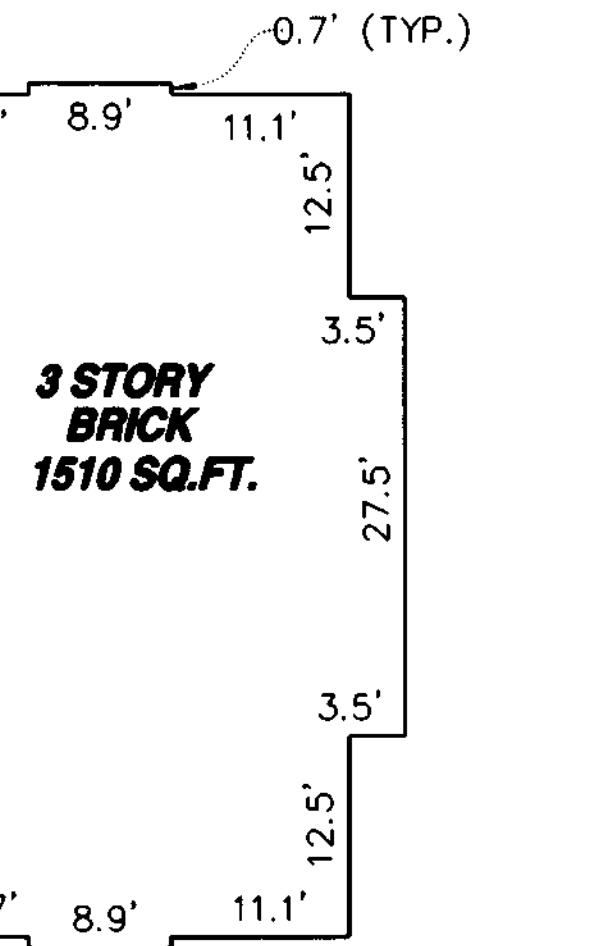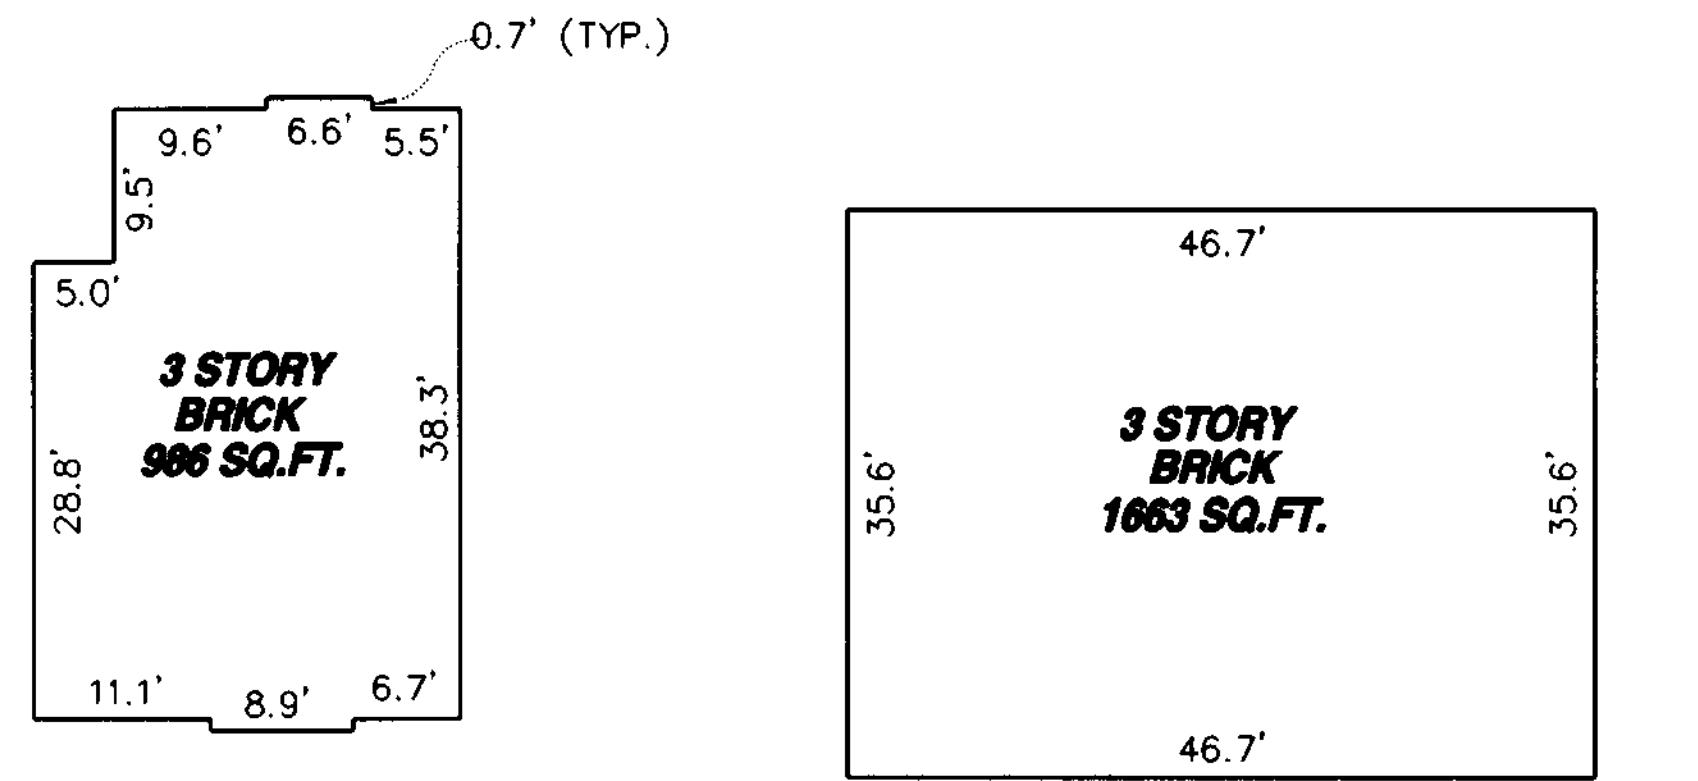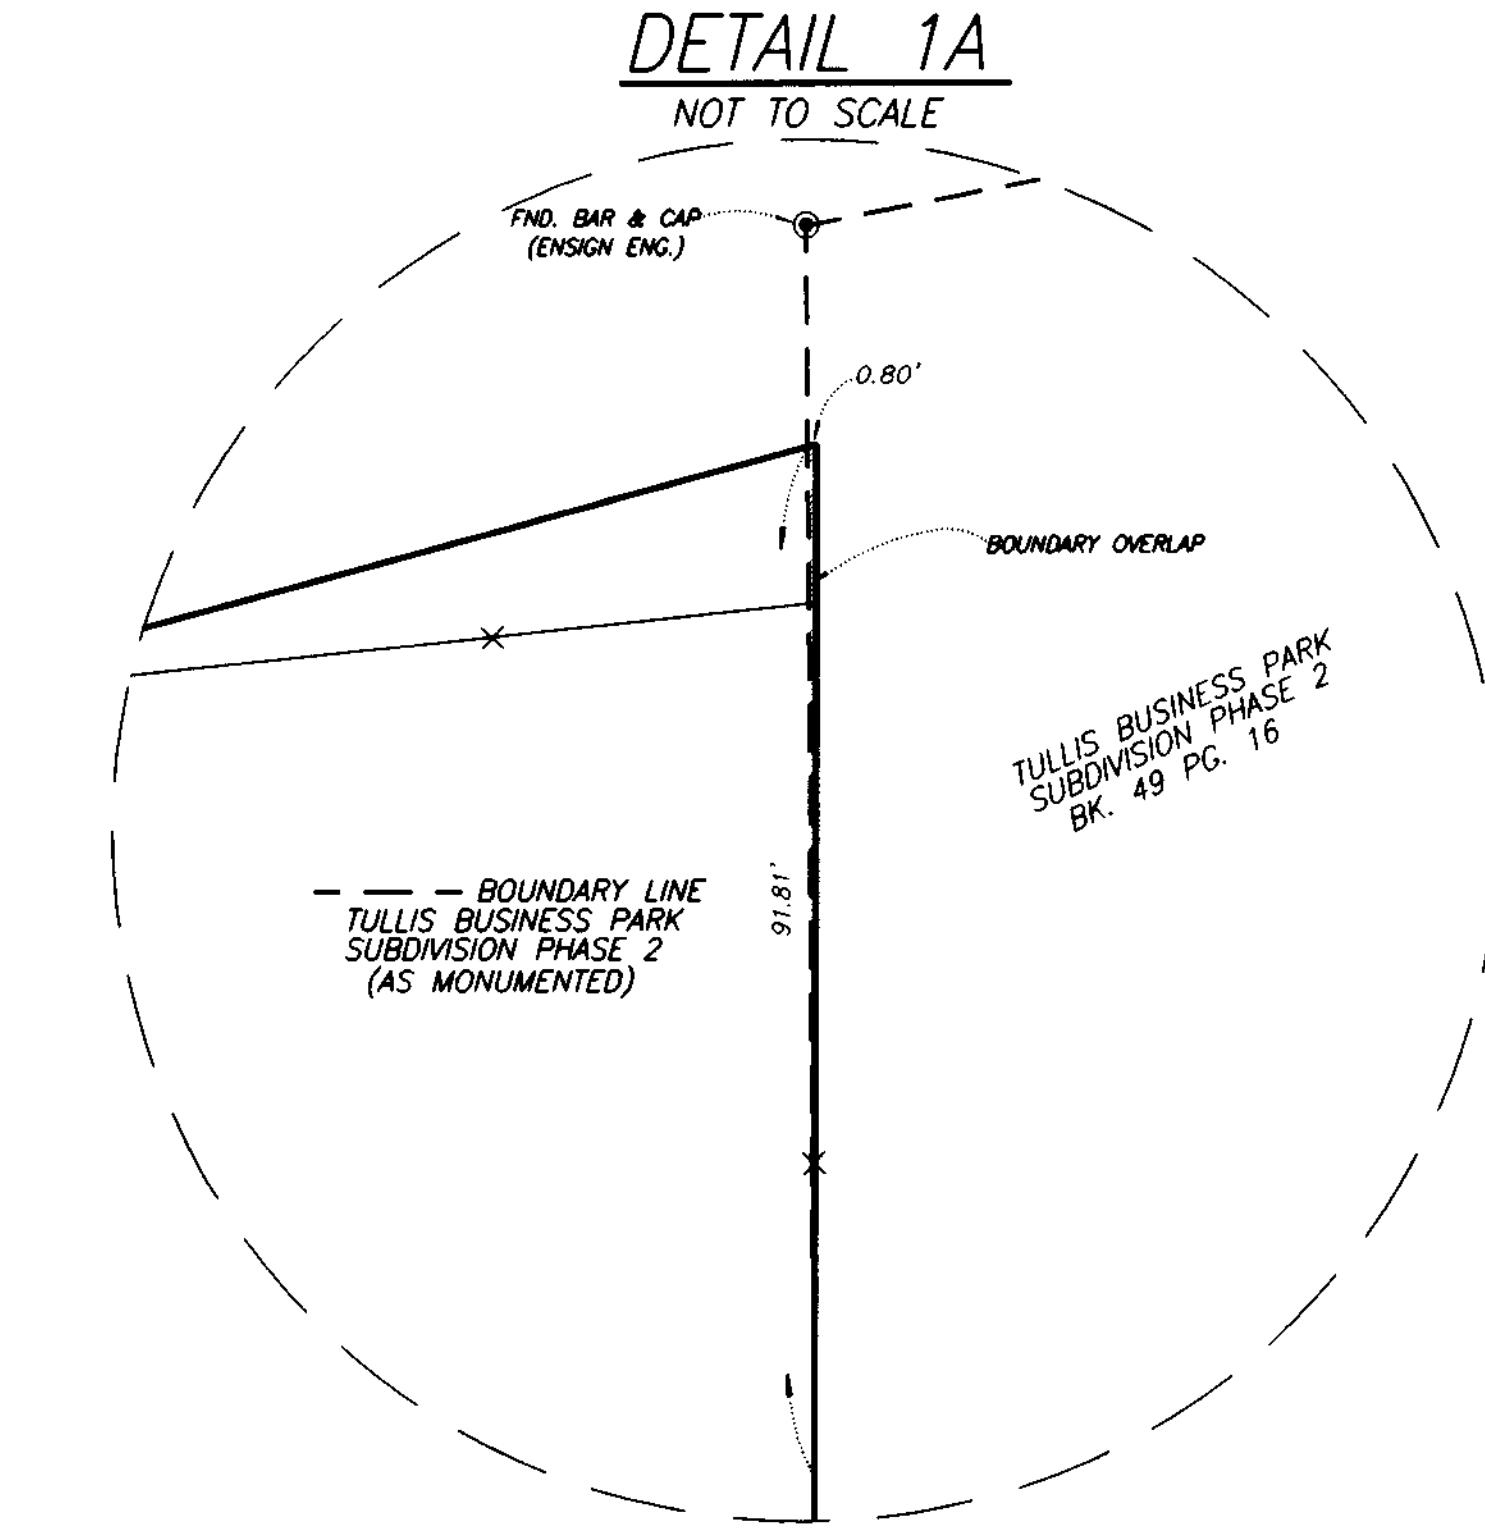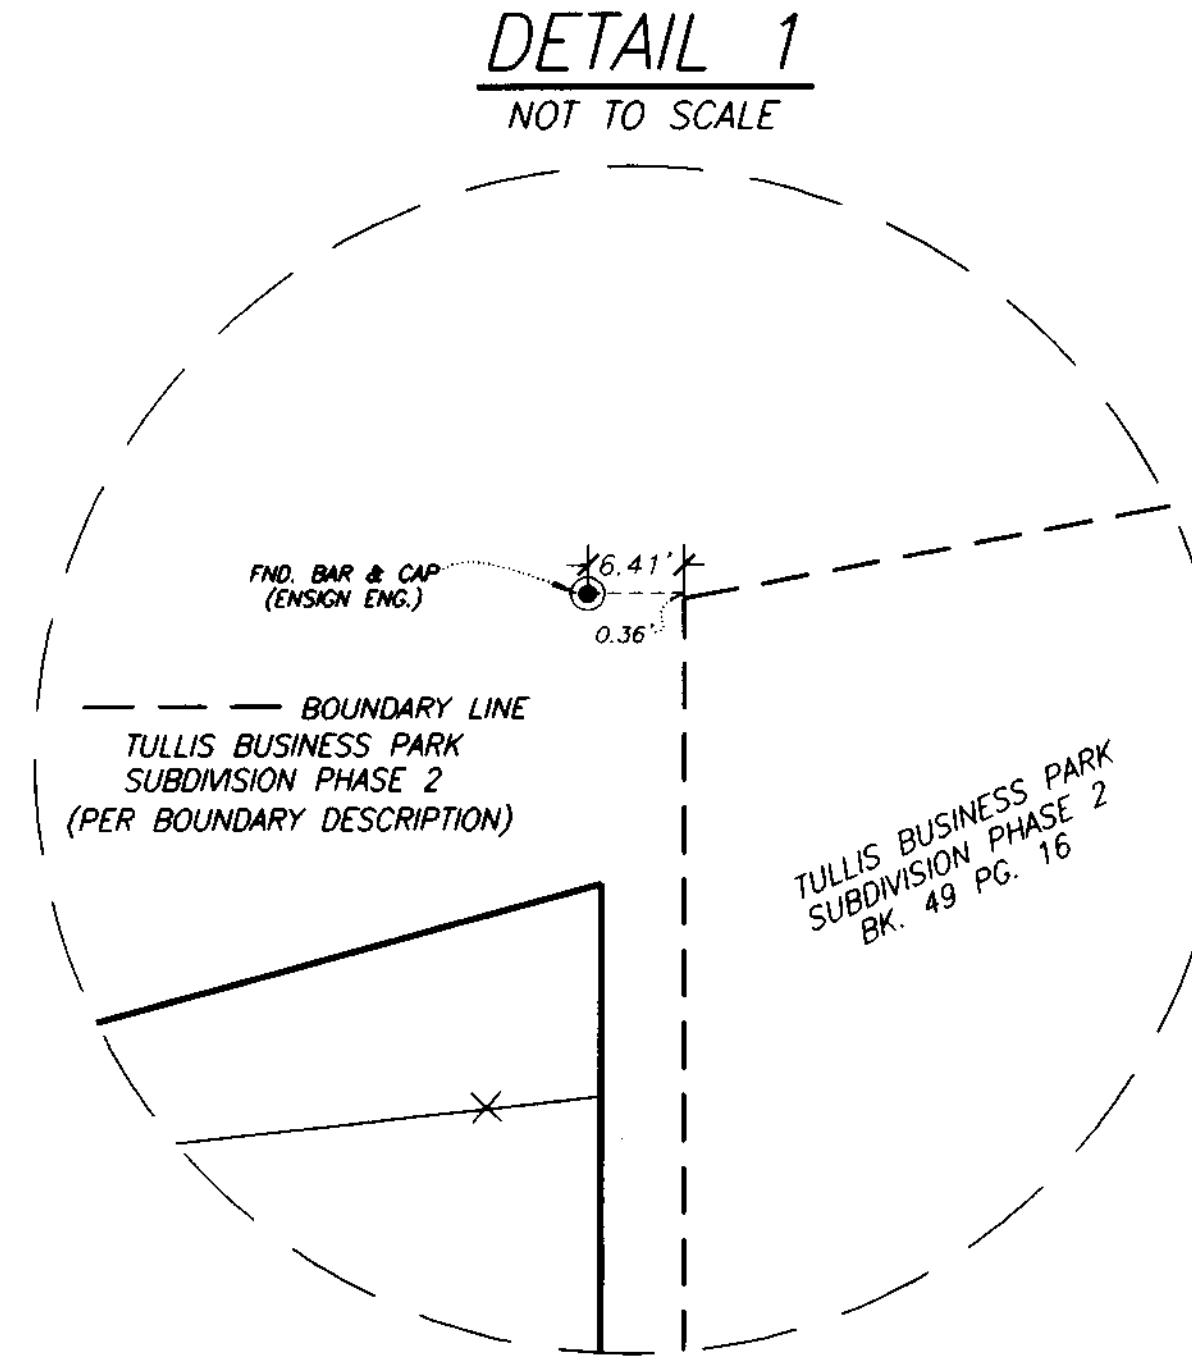

DETAIL 2

NOT TO S

FND. BAR & CAP (ENSIGN ENG.)

BOUNDARY LINE BUSINESS PARK PHASE 2 (DESCRIPTION)

FND. BAR & CAP (MOUNTAIN STATES)

TULLIS BUSINESS PARK SUBDIVISION PHASE 2 BK. 49 PG. 16

4.96'

0.28'

1.22'

28.10'

28.10'

45.14'

45.14'

BOUNDARY OVERLAP

DETAIL 2A

NOT T

FND. BAR & CAP
(ENSIGN ENG.)

FND. BAR & CAP
(MOUNTAIN STATES)

— BOUNDARY LINE
TULLIS BUSINESS PARK
SUBDIVISION PHASE 2
(AS MONUMENTED)

33.19'

28.10'

58.96'

BOUNDARY OVERLAP

TULLIS BUSINESS PARK
SUBDIVISION PHASE 2
BK. 49 PG. 16

DETAIL 3

NOT TO SCALE


*FND. BAR & CAP
(MOUNTAIN STATES)*

DETAIL 4

T TO SCAL

FND. BAR & CAP
(MOUNTAIN STATES)

92

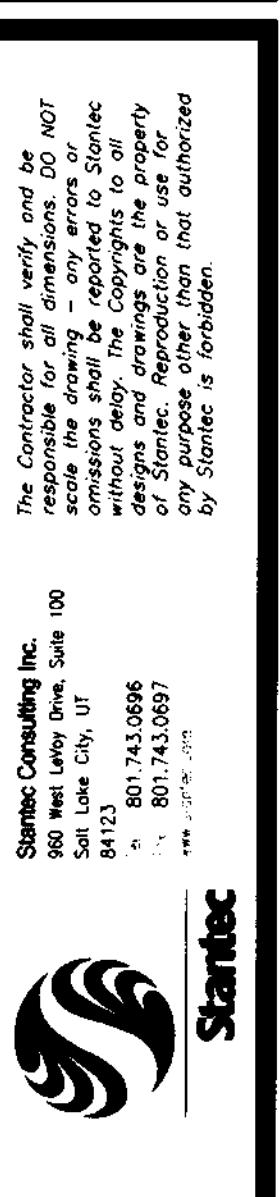

186834220
SCALE 1"=50' DR. BY ECN
DATE 09/29/06 CX BY TMW
FILE V:\52868\active\186834220\drawing\
cherrycreek.dwg