

SCALE: 1"=600'
 DATE: FEBRUARY, 2007
 DESIGN: X.X.X.
 DRAWN: DRW
 CHECKED:

REVISIONS	DESCRIPTION
DATE	

LIBERTY IRRIGATION COMPANY

IRRIGATION PIPELINE
 RECORD OF SURVEY
 LIBERTY, WEBER COUNTY, UTAH


003794

RECEIVED
 FEB 20 2007
 WEBER CO SURVEYOR

5875 South Adams Ave
 P.O. Box 8405
 Ogden, Utah 84405
 (801) 476-0202

Gardner Engineering


I, KEN E GARDNER, DO HEREBY CERTIFY THAT I AM A REGISTERED LAND SURVEYOR, AND THAT I HOLD CERTIFICATE NO.154270, AS PRESCRIBED UNDER THE LAWS OF THE STATE OF UTAH. I FURTHER CERTIFY THAT BY AUTHORITY OF THE OWNERS I HAVE MADE A SURVEY OF THE TRACT OF LAND SHOWN ON THIS PLAT AND DESCRIBED BELOW AND THAT THE REFERENCE MARKERS SHOWN ON THIS PLAT ARE LOCATED AS INDICATED AND ARE SUFFICIENT TO RETRACE OR RE-ESTABLISH THIS SURVEY. THAT THE INFORMATION SHOWN HEREIN IS SUFFICIENT TO ACCURATELY ESTABLISH THE LOCATIONS OF IRRIGATION LINES AS SURVEYED IN THE FIELD.

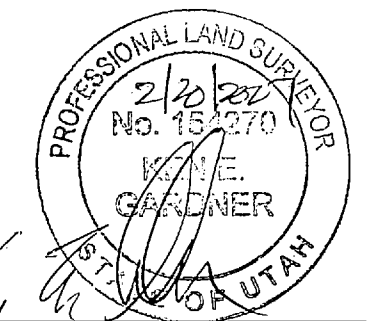


2/20/07
 DATE

[Signature]
 SIGNATURE


NARRATIVE:
 SURVEY COMPLETED TO DETERMINE THE LOCATION OF EXISTING LIBERTY IRRIGATION PIPELINE. PIPELINE LOCATION ESTIMATED BY LIBERTY IRRIGATION PRINCIPLES WHERE PIPE STRUCTURES WERE NOT VISIBLE ABOVE GROUND.

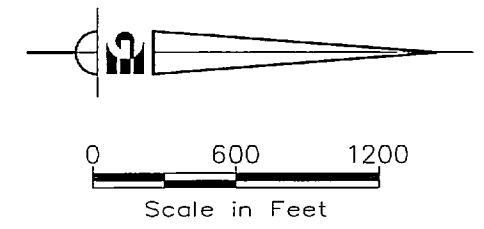

1
 3

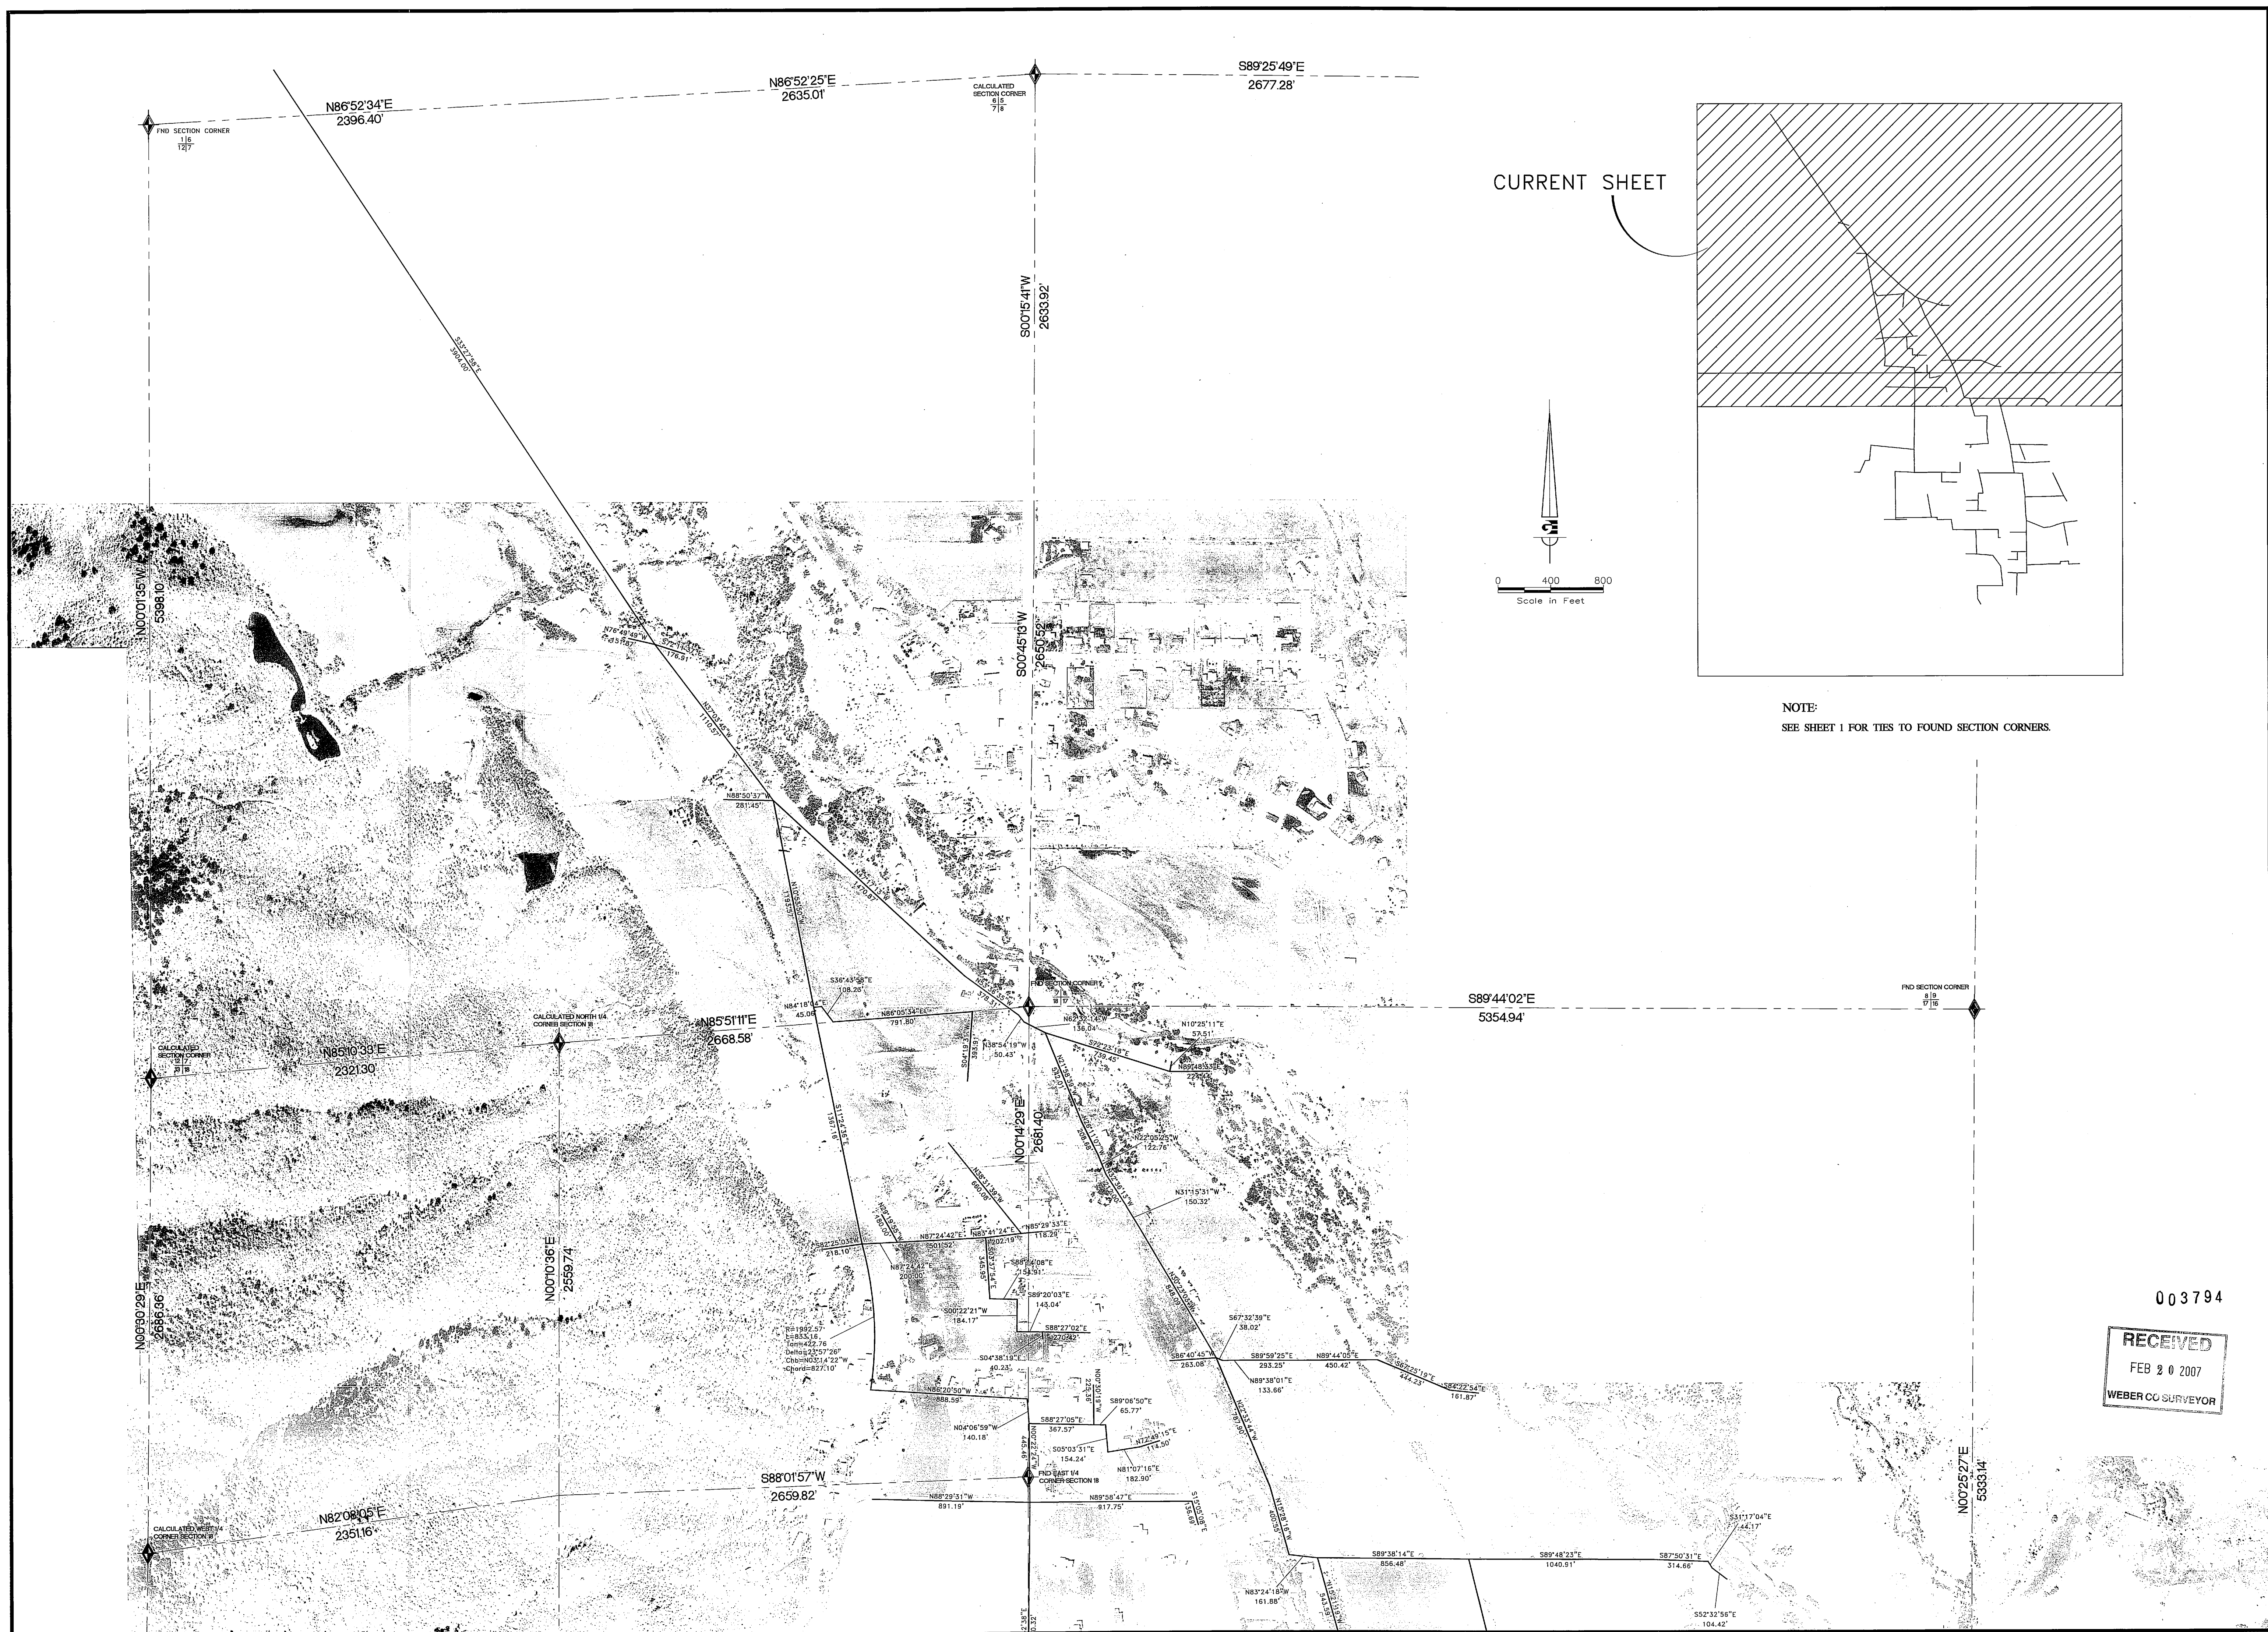

CURRENT SHEET

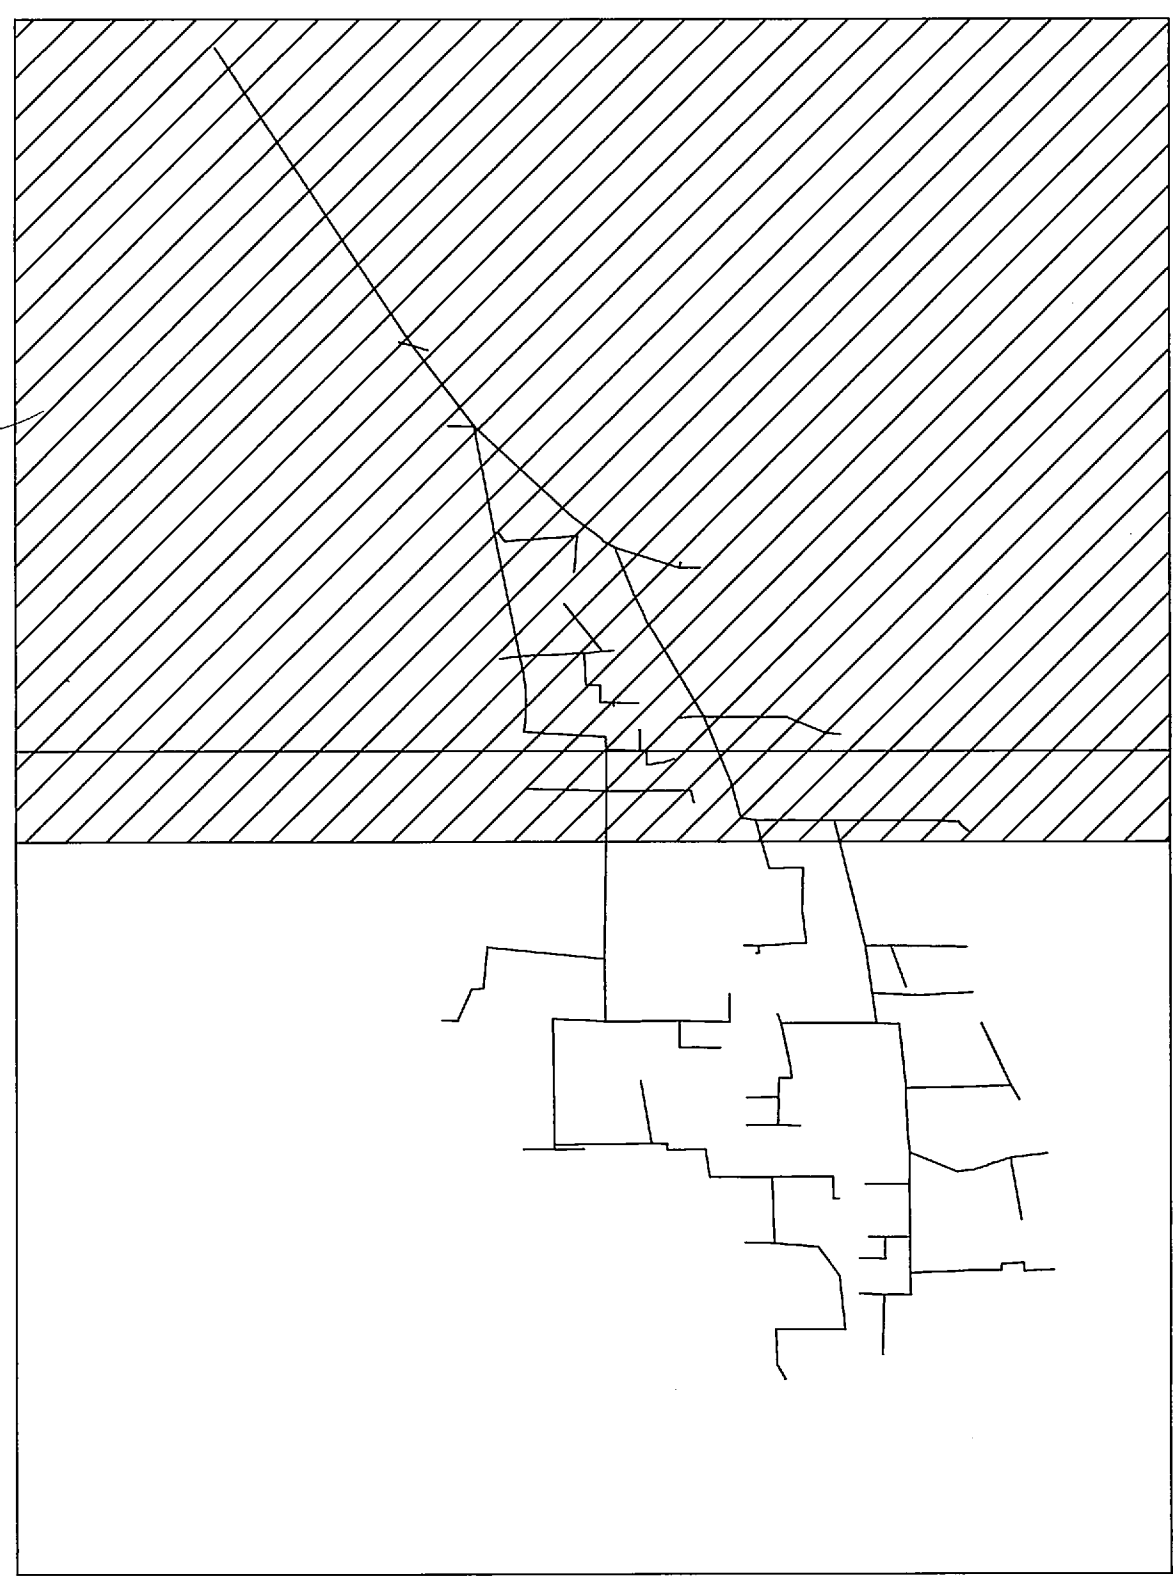

NOTE:
SEE SHEET 1 FOR TIES TO FOUND SECTION CORNERS.

003794
RECEIVED
FEB 20 2007
WEBER CO SURVEYOR

SCALE: 1"=400'
DATE: FEBRUARY 2007
DESIGN: X.X.X.
DRAWN: DRW
CHECKED:

REVISIONS	DESCRIPTION
DATE	



LIBERTY IRRIGATION COMPANY

IRRIGATION PIPELINE
RECORD OF SURVEY
LIBERTY, WEBER COUNTY, UTAH

003794

5875 South Adams Ave
(801) 478-0202

2
3

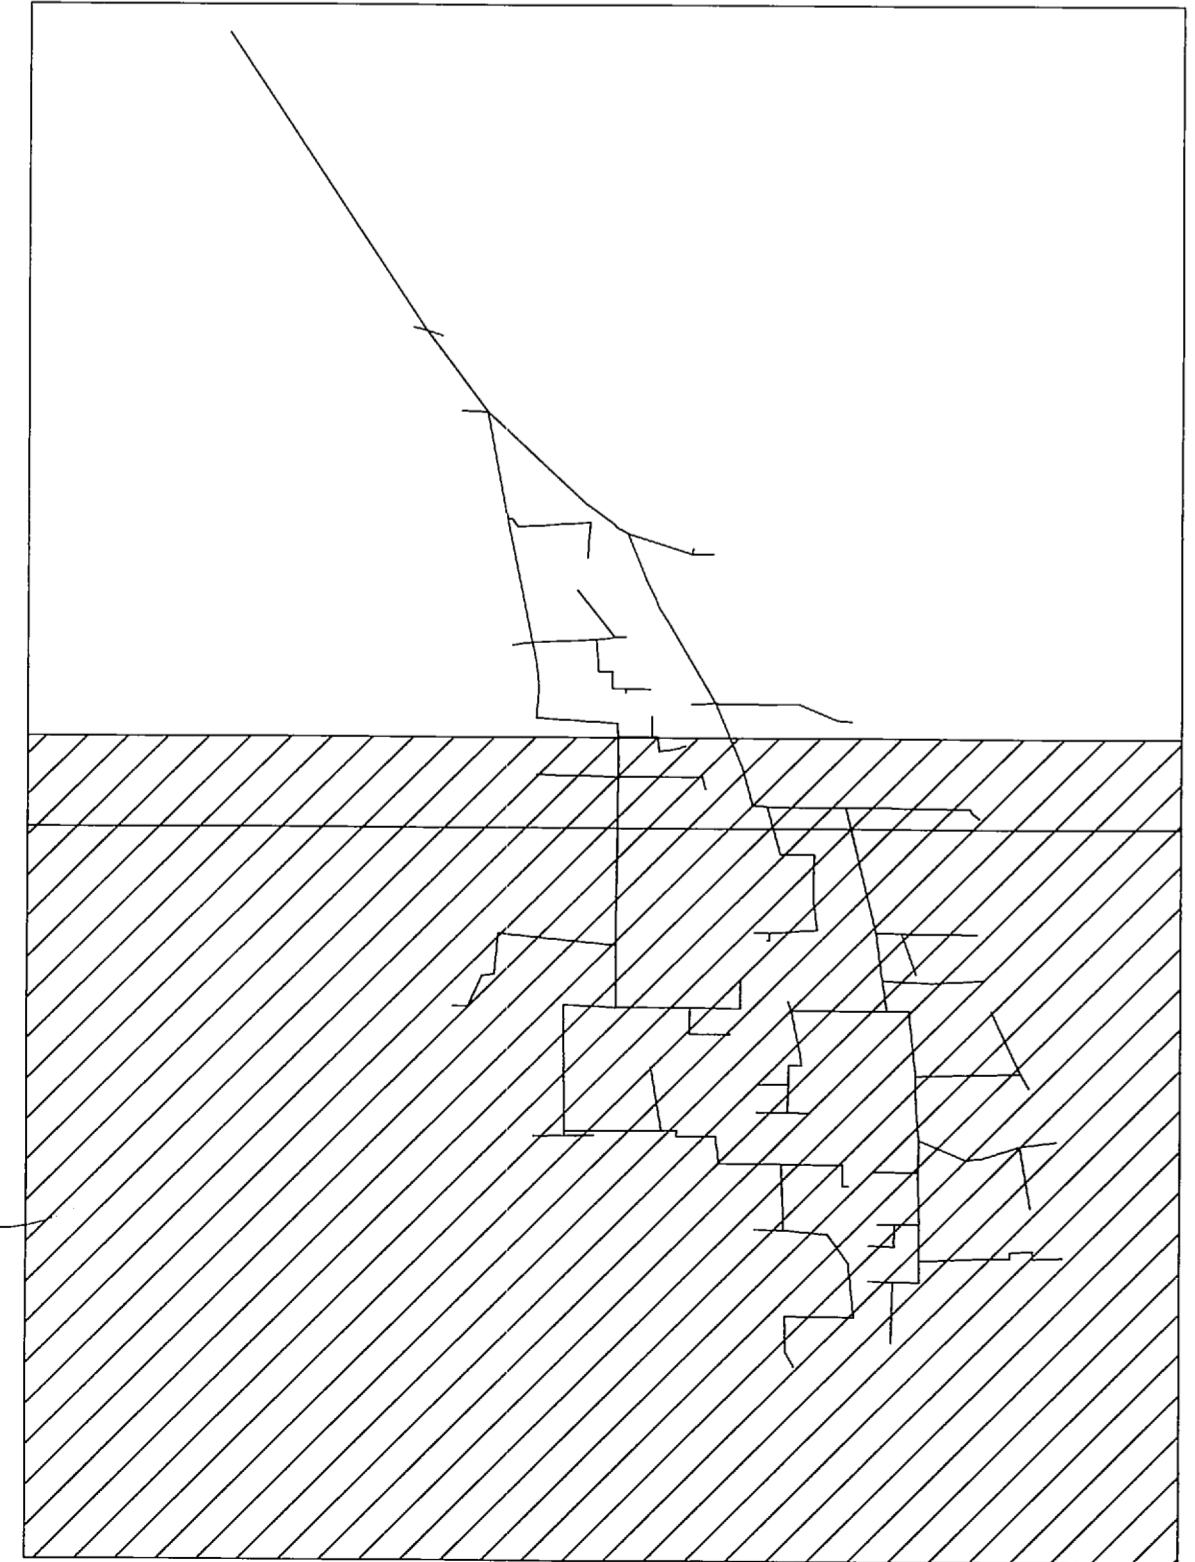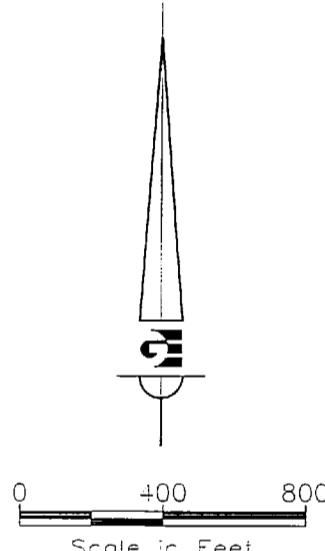

CURRENT SHEET

NOTE:
SEE SHEET 1 FOR TIES TO FOUND SECTION CORNERS.

SCALE: 1"=400'
DATE: FEBRUARY, 2007
DESIGN: X.X.X.
DRAWN: DRW
CHECKED:

REVISIONS	DESCRIPTION
DATE	

003794
RECEIVED
 FEB 20 2007
 WEBER COUNTY SURVEYOR

LIBERTY IRRIGATION COMPANY
 IRRIGATION PIPELINE
 RECORD OF SURVEY
 LIBERTY, WEBER COUNTY, UTAH

Gardner Engineering
 5875 South Adams Ave
 Ogden, Utah 84405
 (801) 476-0202

3
 3