


CERTIFICATE

I, VON R. HILL, A PROFESSIONAL LAND SURVEYOR ACCORDING TO THE LAWS OF THE STATE OF UTAH, DO CERTIFY THAT I HAVE SURVEYED THE PARCEL OF GROUND SHOWN HEREON AND THAT SAID PARCEL WAS STAKED ON THE GROUND AS SHOWN ON THE DRAWING.

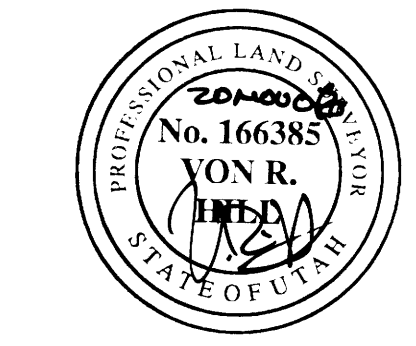

DESCRIPTION

ALL OF LOTS 89 AND 98 WOODLAND ESTATE SUBDIVISION UNIT 4, LOCATED IN THE NORTHEAST QUARTER OF SECTION 23 AND SOUTHEAST QUARTER OF SECTION 14, TOWNSHIP 5 NORTH, RANGE 1 WEST, SALT LAKE BASE AND MERIDIAN, WEBER COUNTY, UTAH.
LOT 89 CONTAINS 25,997 SQUARE FEET
LOT 98 CONTAINS 25,500 SQUARE FEET

NARRATIVE

THE PURPOSE OF THE SURVEY WAS TO LOCATE AND MARK THE SOUTHERLY PROPERTY LINE. THIS WAS DONE USING THE MONUMENTS SHOWN. BASIS OF BEARING IS AS SHOWN.

003798

RECEIVED

MAR 19 2007

WEBER COUNTY

HILL & ARGYLE, Inc.
 Engineering and Surveying
H & A
 181 North 200 West, Suite #4, Bountiful, Utah 84010
 (801) 298-2236 Phone, (801) 298-5983 Fax

SURVEY REQUESTED BY
RKT HOLDING COMPANY

LOTS 89 AND 98 WOODLAND ESTATES SUBDIVISION UNIT 4
 LOCATED IN THE NE 1/4 OF SECTION 23 AND THE SE 1/4 OF SECTION 14, T5N, R1W, SLB&M
 WEBER COUNTY, UTAH

DRAWN: SHM	DATE: 11/20/06
APPROVED: VRH	DATE: 11/20/06
REVISED:	DATE:
SHEET 1 OF 1	
DRAWING NAME: BOUNDARY	
PROJECT NO.: 06-235	