


003799

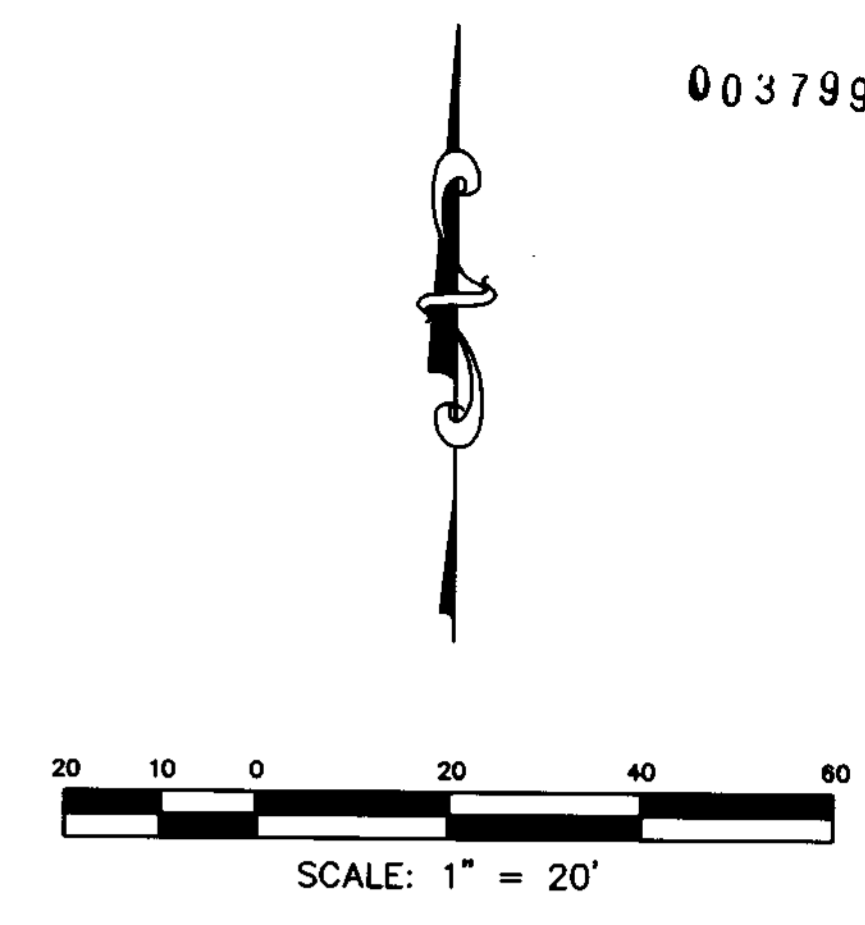

CERTIFICATE

I, VON R. HILL, A PROFESSIONAL LAND SURVEYOR ACCORDING TO THE LAWS OF THE STATE OF UTAH, DO CERTIFY THAT I HAVE SURVEYED THE PARCEL OF GROUND SHOWN HEREON AND THAT SAID PARCEL WAS STAKED ON THE GROUND AS SHOWN ON THE DRAWING.



BOUNDARY DESCRIPTION

LOT 10, THE RIDGES OF REGENCY HEIGHTS NO. 2 SUBDIVISION CONTAINING 39,709 SQ.FT.

NARRATIVE

THE PURPOSE OF THE SURVEY WAS TO MARK THE PROPERTY CORNERS. THIS WAS DONE USING THE MONUMENTS SHOWN. THE BASIS OF IS AS SHOWN.

003799

RECEIVED
MAR 19 2007
WEBER CO SURVEYOR

HILL & ARGYLE, Inc.
Engineering and Surveying
181 North 200 West, Suite #4, Bountiful, Utah 84010
(801) 298-2236 Phone, (801) 298-5883 Fax

BOUNDARY SURVEY REQUESTED BY:
KARL AND KATHY LINDLEY
2112 RIDGEDALE CIRCLE

LOT 10, THE RIDGE OF REGENCY HEIGHTS NO 2
A PART OF THE SOUTHWEST QUARTER OF SECTION 14, T5N, R1W, SLB & M
OGDEN CITY, WEBER COUNTY, UTAH

DRANN, S. ALLEN	DATE 2/16/07
APPROVED STA	DATE 2/20/07
REVISION	DATE
SHEET 1	OF 1
SHEET NAME SITE PLAN	
DRAWING NAME MAIN LOT 10	
PROJECT NO. 07-140	