


COMMENTS:  
 THIS SURVEY WAS PERFORMED AS A REQUIREMENT PRIOR TO  
 CONVEYANCING. FOUND AT THE INTERSECTION OF THE 2 ADJACENT  
 LINE ALONG 5600 SOUTH ST. WAS USED FOR BASIS  
 OF BEARING.

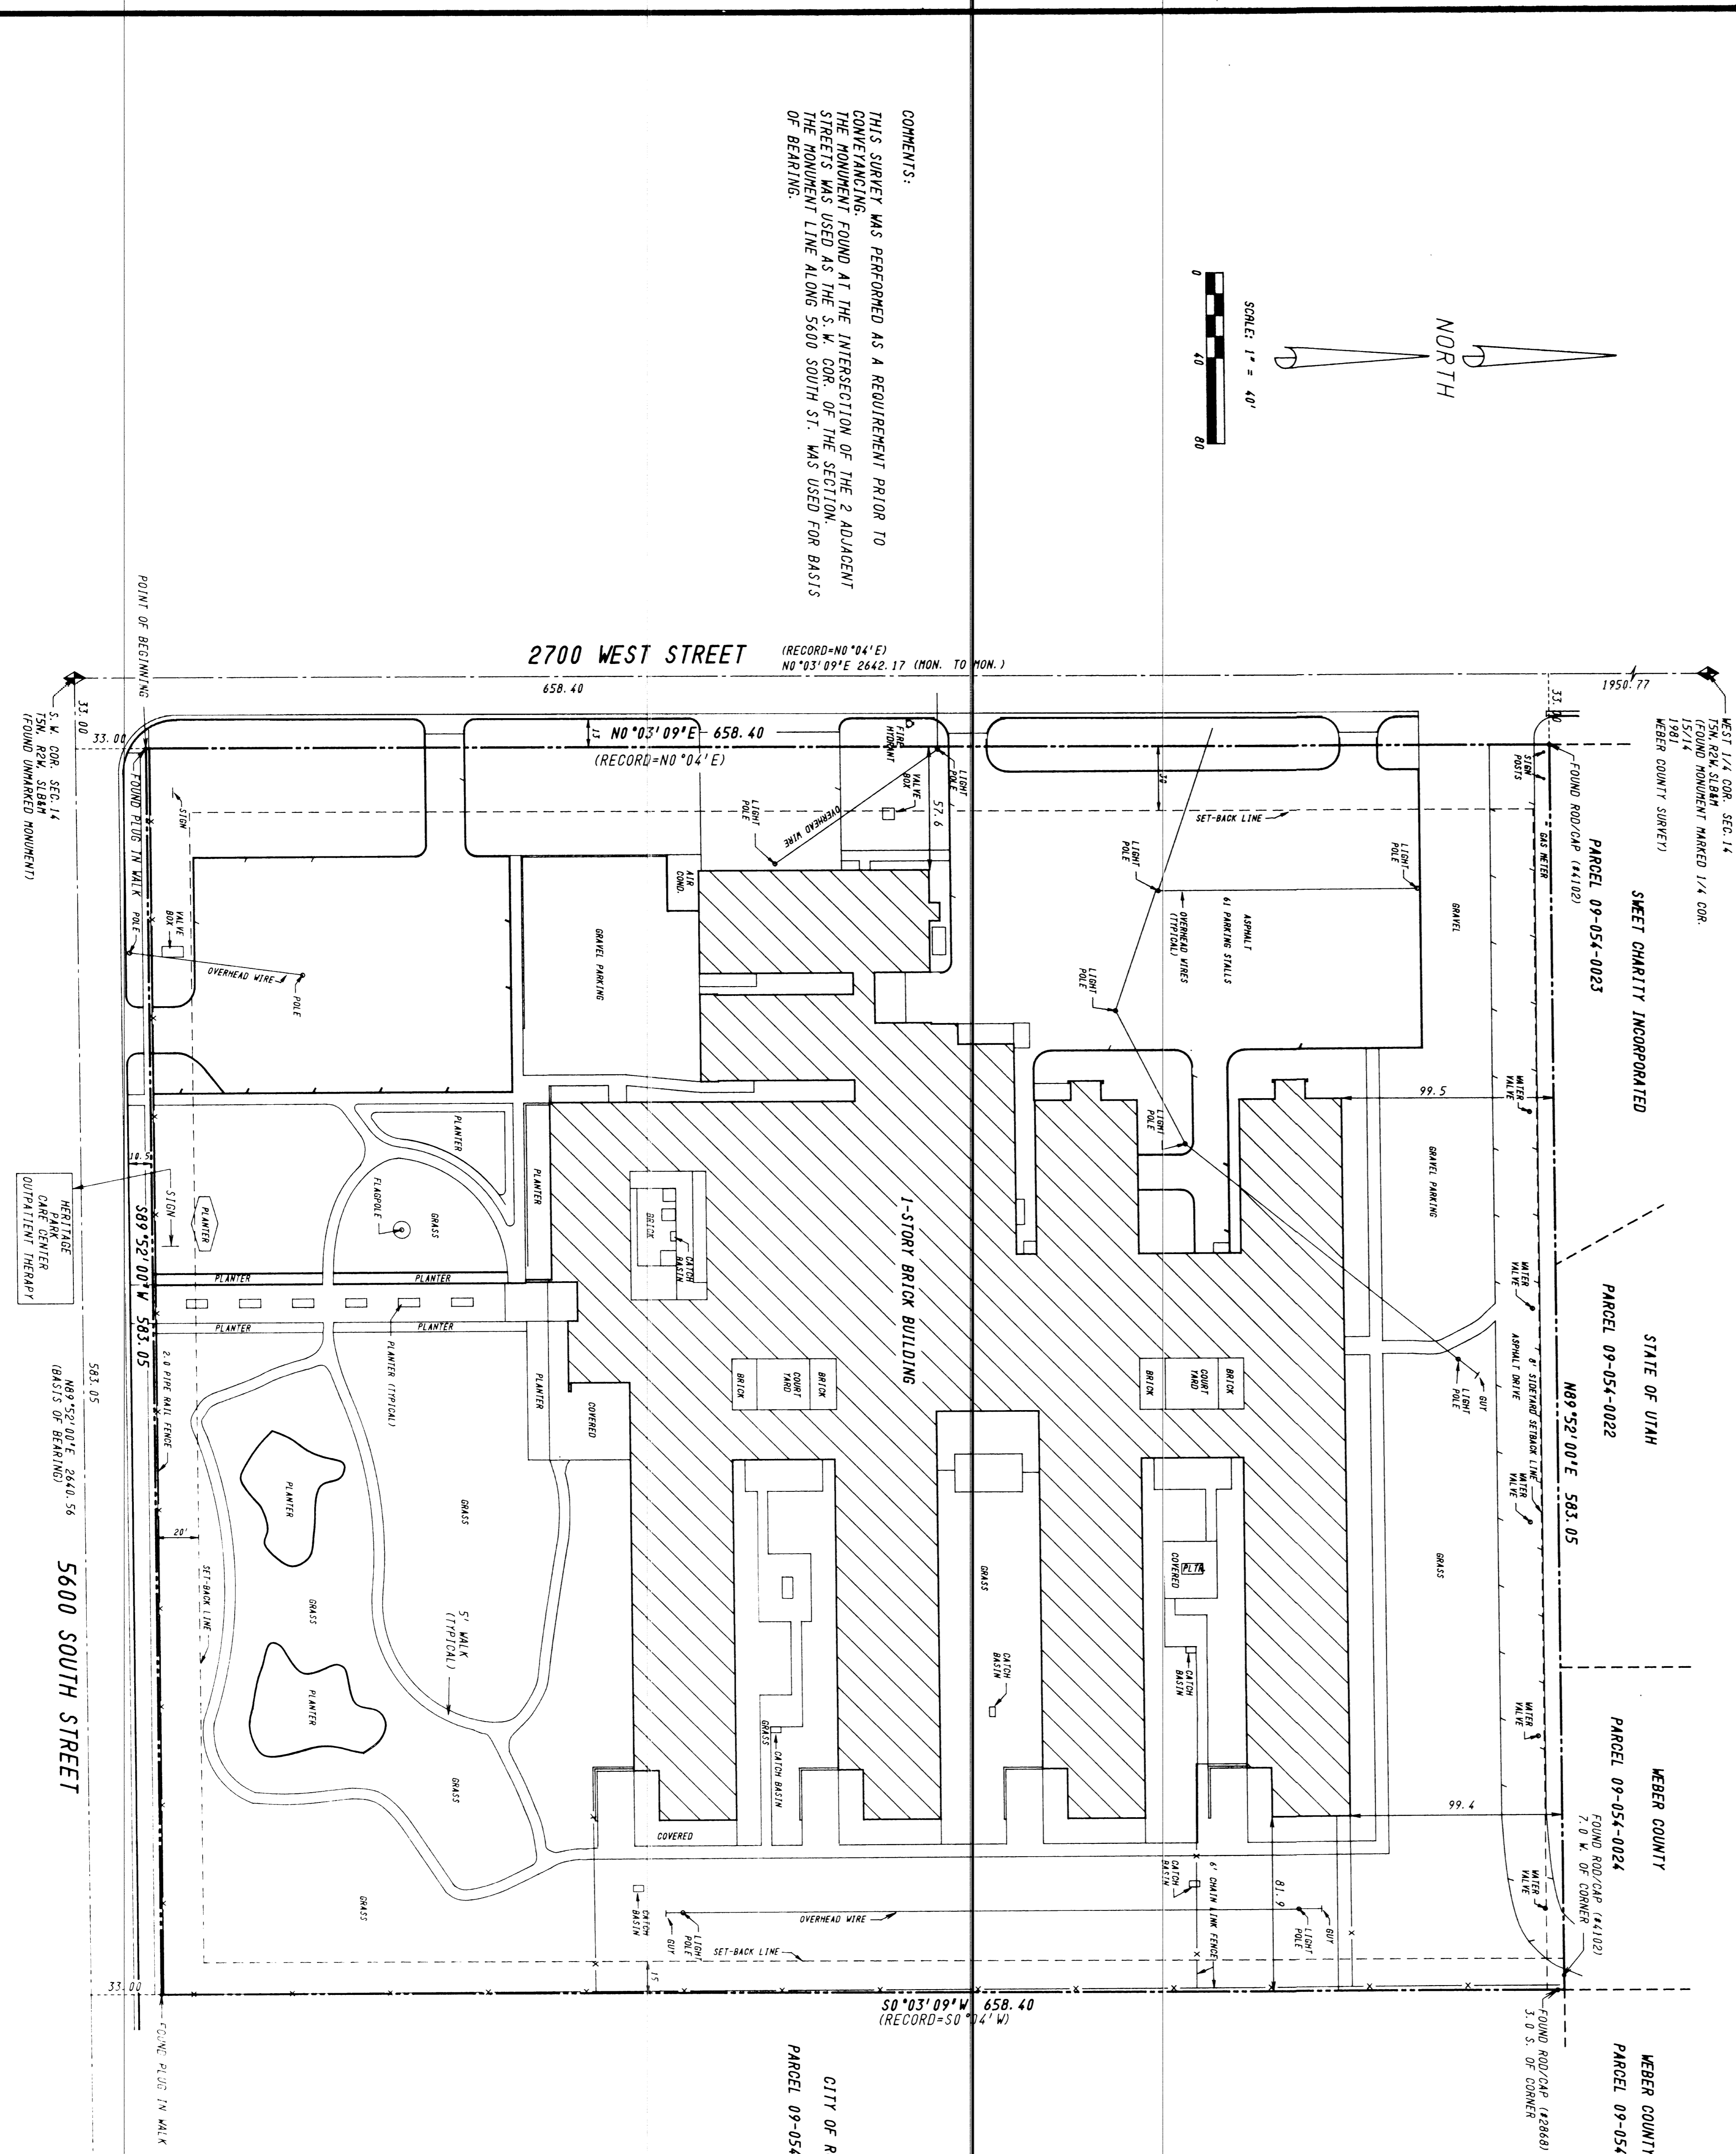

PARCEL 09-054-0023  
 STATE OF UTAH

PARCEL 09-054-0022

PARCEL 09-054-0024

PARCEL 09-054-0022

PARCEL 09-054-0024

**RECORD DESCRIPTION FROM TITLE COMMITTEE #18828**



**SURVEYOR'S CERTIFICATE:**

I, C. JAMES SCHUCHERT, A duly registered land surveyor in the State of Utah, do hereby certify that I was personally present at the recording of this plat and that the same was prepared in accordance with the requirements of a Class 1A Survey as defined therein.

DATE SIGNED: APRIL 24, 1990

C. JAMES SCHUCHERT, R.S.  
 LICENSE NO. 2868(01215)  
 SCHUCHERT 2/11/20

CITY OF ROY  
 PARCEL 09-054-0022

AREA = 0.813 ACRES

5600 SOUTH STREET  
 WEBER MEMORIAL CARE CENTER

**SCHUCHERT & ASSOCIATES**  
 PROFESSIONAL LAND SURVEYORS  
 5202 SOUTH WILSON AVENUE, SUITE 200, SALT LAKE CITY, UTAH 84119  
 801.589.9119

**ALTA/ACSM LAND TITLE SURVEY**  
 CITY OF ROY, COUNTY OF WEBER, STATE OF UTAH

WEBER ASSOCIATES LIMITED PARTNERSHIP

RECEIVED  
 AUG 12 1990  
 Weber County Surveys

L/S/L  
 2/24  
 2/24