

Surveyor's Certificate

To: Chicago Title Insurance Company and Homeland Vinyl Products, Inc. its affiliates, successors and /or assigns.

SCHEDULE B - Section 2 Special Exceptions (Chicago Title Insurance Company Commitment No. 42578)

003825


Boundary Description

LOTS 89 AND 90, OGDEN COMMERCIAL & INDUSTRIAL PARK-PLAT "F", OGDEN CITY, WEBER COUNTY, UTAH, ACCORDING TO THE OFFICIAL PLAT THEREOF, FILED IN BOOK "31" OF PLATS, AT PAGE 52 OF THE OFFICIAL RECORDS OF THE WEBER COUNTY RECORDER, MORE PARTICULARLY DESCRIBED AS FOLLOWS:


BEGINNING AT A POINT SOUTH 0°31'00" WEST 25.601 FEET ALONG THE SECTION LINE AND EAST 1148.805 FEET FROM THE WEST QUARTER CORNER OF SECTION 36, TOWNSHIP 6 NORTH, RANGE 2 WEST, SALT LAKE BASE AND MERIDIAN; AND RUNNING THENCE SOUTH 55°59'00" EAST 380.00 FEET TO THE WESTERLY RIGHT OF WAY LINE OF THE DENVER AND RIO GRANDE WESTERN RAILROAD; THENCE SOUTH 34°01'00" WEST 1302.14 FEET ALONG THE WESTERLY RIGHT OF WAY LINE OF SAID DENVER AND RIO GRANDE WESTERN RAILROAD; THENCE NORTH 89°32'00" WEST 305.84 FEET; THENCE NORTH 00°08'00" EAST 306.00 FEET TO THE SOUTHEASTERLY RIGHT-OF-WAY LINE OF COMMERCE WAY; THENCE ALONG SAID RIGHT-OF-WAY LINE THE FOLLOWING TWO (2) COURSES: (1) TO THE LEFT ALONG THE ARC OF A 329.84 FOOT RADIUS CURVE A DISTANCE OF 323.05 FEET, CHORD BEARS NORTH 82°04'30" EAST 310.29 FEET; (2) NORTH 34° 01' 00" EAST 1000.00 FEET TO THE POINT OF BEGINNING. CONTAINING 12.03 ACRES.

- The survey reflected by this plat was actually made upon the ground, that the attached plat of survey is made of local in accordance with the Minimum Standards established by the State of Utah for surveys and with the "Minimum Standard Detail Requirements for ALTA/ACSM Land Title Surveys" jointly established and adopted by ALTA and ACSM in 1999 and meets the Accuracy Standards (as adopted by ALTA, NSPS and ACSM) and in effect on the date of this certificate) of an Urban Survey, with accuracy and precision requirements modified to meet current minimum angular and linear tolerance requirements of the state in which the subject property is located, and contains items 1, 2, 3, 4, 6, 7(a), 8, 9, 10, 11a, 13 and 15 of Table A thereto.
- The survey correctly shows the location of all buildings, structures and other improvements situated on the Property.
- Except as shown, all utilities serving the Property enter through adjoining public streets and/or easements of record; that except as shown, there are no visible easements or rights of way across said Property; that the property described herein is the same as the property described in Chicago Title Company Order No. 42578, Commitment No. 42578 and that all easements, encumbrances and restrictions referenced in said title commitment, or easement, which the undersigned has been advised or has knowledge, have been plotted hereon or otherwise noted as to their effect on the subject property;
- Except as shown, there are no encroachments onto adjoining premises, streets or alleys by any buildings, structures or other improvements, and no encroachments onto said Premises by buildings, structures or other improvements situated on adjoining premises;
- Said described property is located within the OCIP Zone as designated by the City of Ogden. Any building shall have setbacks as follows: 20.00 feet from the front property line, 10.00 feet from the side and 10.00 feet from the rear property line. There are no maximum or minimum building height requirements. Buildings located within this zone must encompass at least 20,000 square feet.
- Said described property is located within Floodzone X, areas determined to be outside the 0.2% annual chance floodplain, as shown on the Flood Insurance Rate Map Panel No. 409 of 600, Map Number 49087C0409E with an effective date of December 16, 2005.
- The property has direct physical access to Commerce Way.
- The Property comprises tax parcels 15-180-0002 and 15-180-0003.
- There are 554 designated parking stalls and 8 handicap parking stalls on the property.
- Except as shown, no existing improvements violate applicable set back lines and front, side and rear yard requirements.
- There are no Wetlands that exist on this parcel.
- The Property contains 12.03 acres by record and 12.03 acres by survey.

- A blanket type right-of-way and easement to construct, operate and maintain lines of telephone and telegraph including the necessary poles, wires and fixtures as may be constructed on or across the subject property, but not specifically defined as to the exact location in favor of Mountain States Telephone and Telegraph Co., its successors and assigns. Recorded January 29, 1925 in Book 103, Page 291 of the Official Records. (Not Plotted)
- A blanket type right-of-way and easement to lay, maintain, operate and remove pipe lines, as may be constructed on or across the subject property but not specifically defined as to the exact location in favor of Wasatch Gas Co., its successors and assigns. Recorded March 26, 1929 in Book 5, Page 80 of the Official Records. (Not Plotted)
- A right-of-way and easement for the erection and continued maintenance, repair, alteration and replacement of electric transmission, distribution and telephone circuits, and 5 poles, with the necessary guys, stubs, crossarms and other attachments thereon, or affixed thereto, for the support of said circuits, with other recited rights, terms and conditions created in favor of Morrison-Knudsen Company, Inc., its successors in interest and assigns. Recorded April 20, 1956 as Entry No. 254987, in Book 511, Page 373 of the Official Records.
- A right-of-way and easement for the erection and continued maintenance, repair, alteration and replacement of electric transmission, distribution and telephone circuits and one guy anchor and 6 poles, with the necessary guys, stubs, cross-arms and other attachments thereon, or affixed thereto, for the support of said circuits, with other recited rights in favor of Utah Power and Light Company, its successors in interest and assigns. Recorded June 7, 1961 as Entry No. 358380, in Book 680, Page 278 of the Official Records.
- A right-of-way and easement 7.00 feet in width to construct, operate, maintain and remove communication and other facilities, with other recited rights, terms and conditions in favor of The Mountain States Telephone and Telegraph Company, its successors, assigns, licensees and agents. Recorded December 20, 1989 as Entry No. 1087412, in Book 1573, Page 1082 of the Official Records.
- Easements for public utilities and incidental purposes over, along and across the said property as shown on the recorded plat of Ogden Commercial and Industrial Park-Plat "F".
- Ogden Commercial And Industrial Park Protective Covenants, recorded April 26, 1979 as Entry No. 774782, in Book 1289, Page 224 of the Official Records.

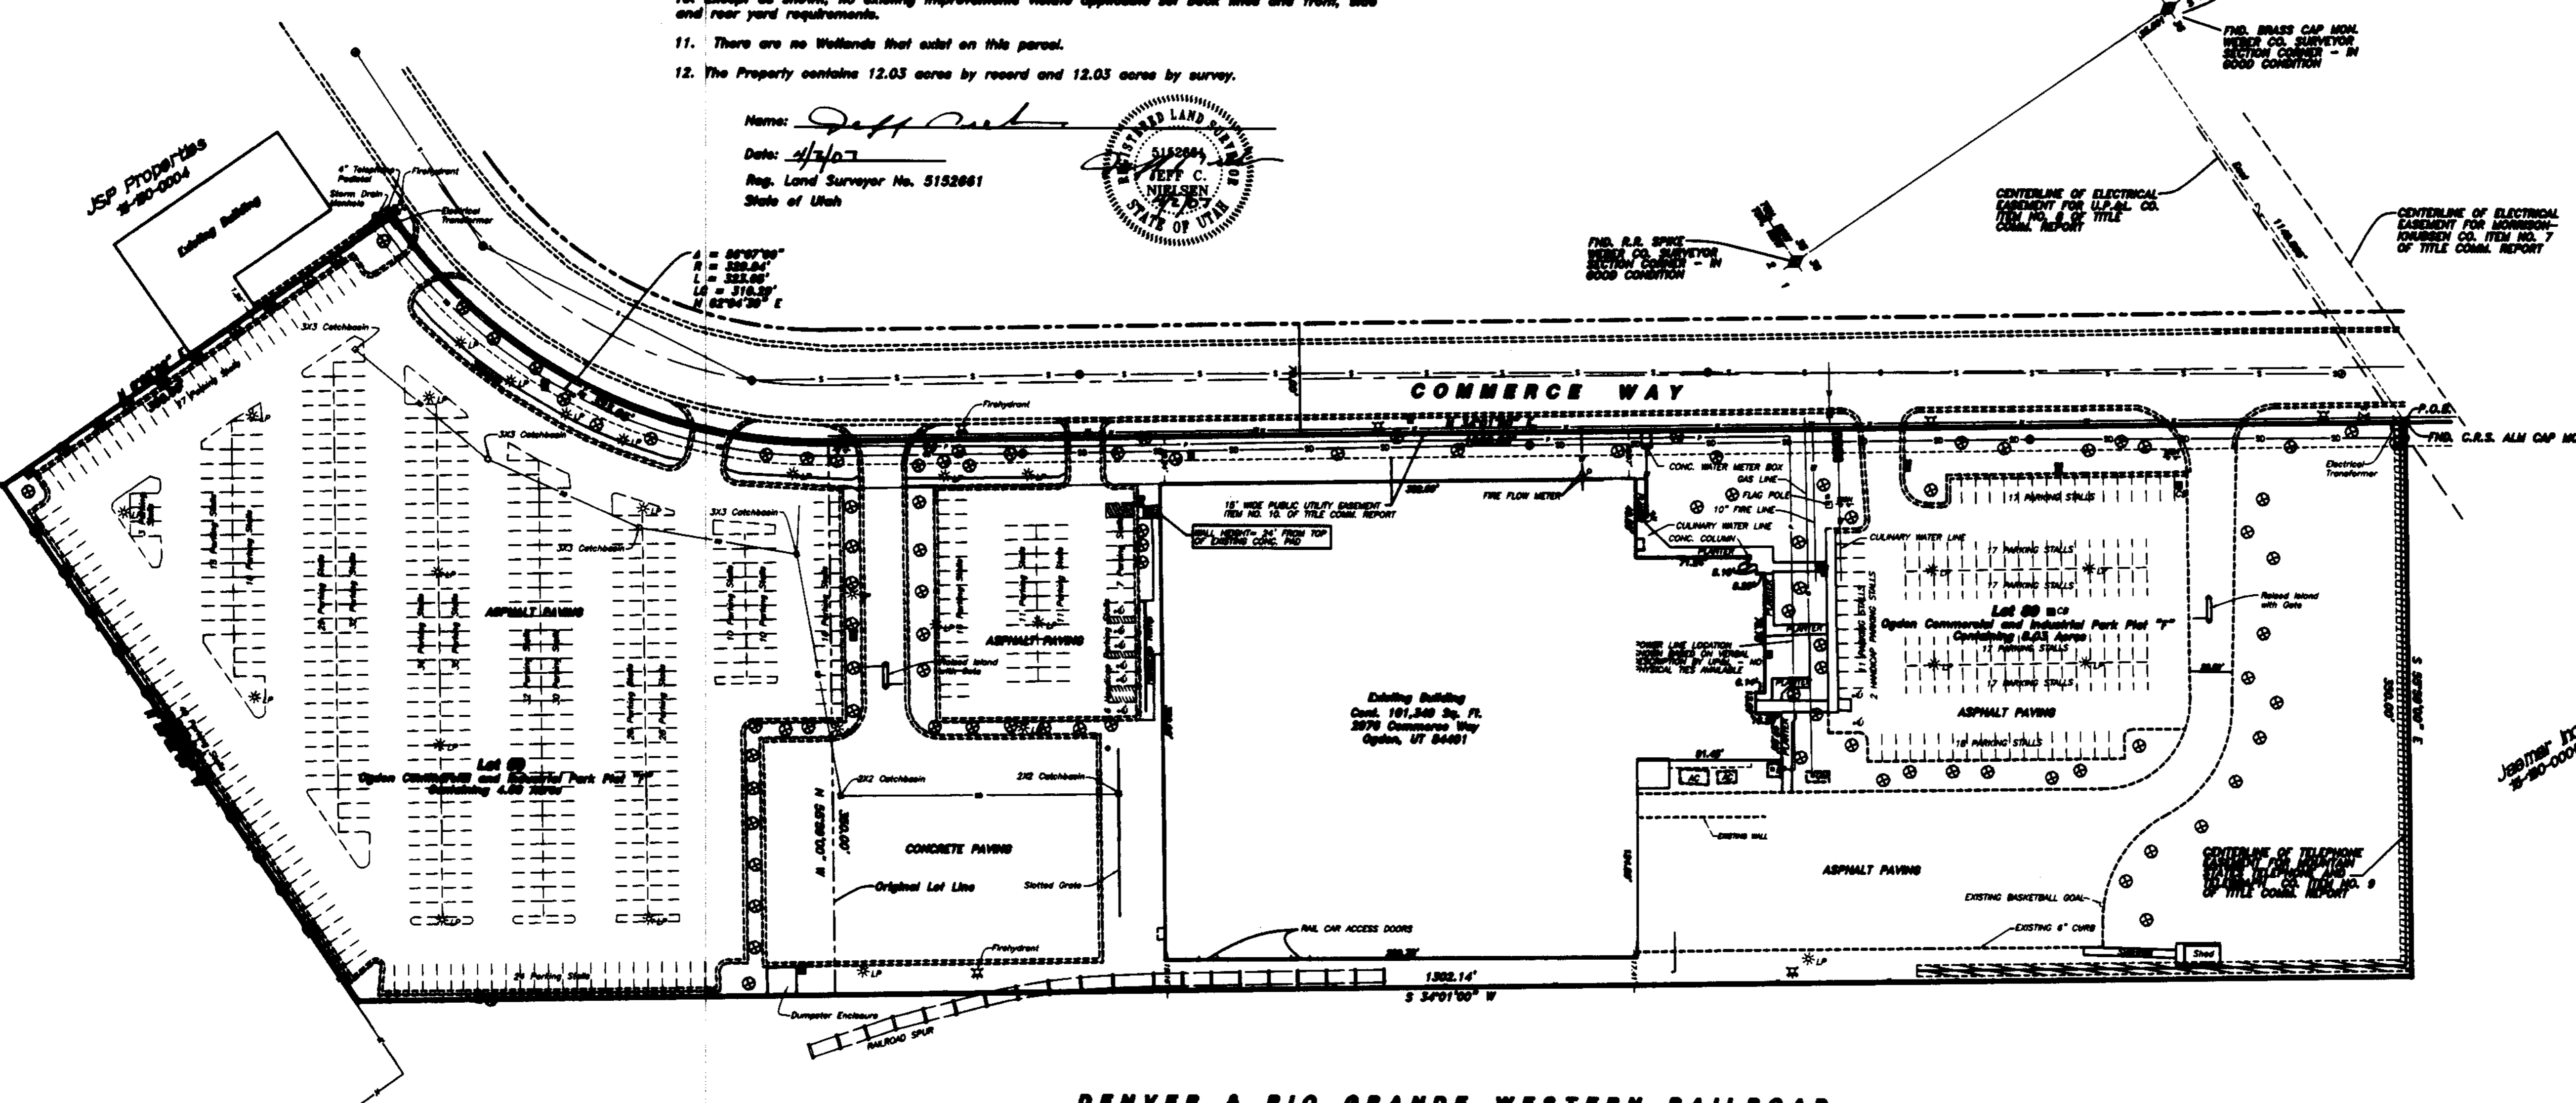

 Date: 4/17/07
 Reg. Land Surveyor No. 5152861
 State of Utah

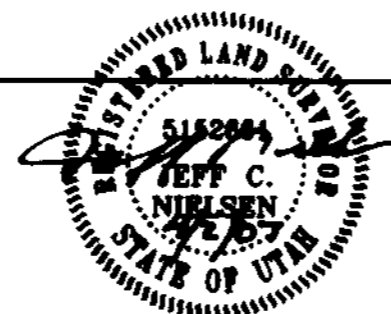

Scale: 1" = 80'
 Drawn By: JH Date: 1/23/2007
 Checked By: [Signature]
 Approved By: [Signature]
 Drawing File: 06-3-228.dwg
 JOB NUMBER: 06-3-228

RECEIVED
 MAY 17 2007
 WEBER CO SURVEYOR

ALTA/ACSM SURVEY FOR:
Fund IX, X and XI
and REIT Joint Venture
 Ogden Commercial and Industrial Park "Plat F"
 A PART OF THE NORTHWEST QUARTER OF SECTION 36,
 TOWNSHIP 6 NORTH, RANGE 2 WEST, S.L.B. & M.

FA HANSEN & ASSOCIATES, INC.
 Consulting Engineers and Land Surveyors
 538 North Main Brigham City, Utah 84302
 Brigham City Ogden Logan
 723-3481 399-4905 782-8272

SHEET
1
 OF
1
 SHEETS