

East Quarter Corner Sec. 33,
T7N, R2W, SL&M Found Weber
Co. Survey Brass Cap Mon. 1965
N 89°58'58" W
96.35'

East Quarter Corner
Previous Survey - Unknown

2200

North

Four Mile Estate Subdivision

R & A Robinson
190350014

Aime Jean Skoen
190350012

Barnard Spiers
190350038


Parcel No. 1
Containing 2.93 Acres

Diane Thomas
190350036

Chevoni Tawatarl
190350021

RECEIVED
MAY 17 2007
WEBER CO SURVEYOR

003828

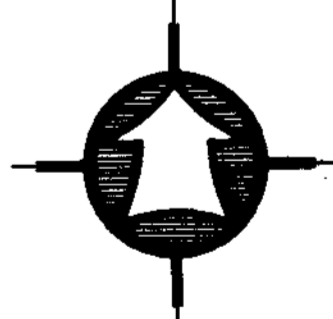

Scale: 1" = 100'


LEGEND:

	PROPERTY LINE
	CENTERLINE
	CLUB & GUTTER
	EDGE OF PAVEMENT
	DITCH
	FENCE LINE
	STREET MONUMENT
	SET 5/8" REBAR W/ CAP
	SET 03/08/07

SURVEY CERTIFICATE

I, K. Greg Hansen, do hereby certify that I am a Registered Land Surveyor, and that I hold Certificate No. 167819 as prescribed by the Laws of the State of Utah, and that I have made and/or supervised the survey of the property shown and described hereon and that this plot is a true and correct representation of said survey to the best of my knowledge and belief.

K. Greg Hansen,
R.L.S. No. 167819

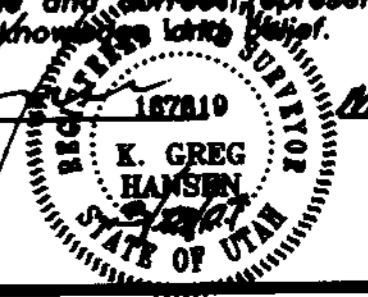

March 22 2007
date

Narrative

The purpose of this survey was to establish and set the property corners of the parcel as shown and described hereon. The survey was ordered by Steve Griffin. The control used to establish the property corners was the existing Weber County Survey Monumentation surrounding Section 33, T7N, R2W, SL&M. The basis of bearing to the East line of the southeast quarter of said Section which bears North 03°03'50" East. The east line of said southeast quarter a surveyed by previous recorded surveys was used on this survey. Said line bears North 01°00'00" East. The southeast corner of the section appears to be 40' south of what maybe the true location. The parcels on the north side of 1975 were adjusted accordingly. The north property line by deed went through the north portion of the existing home. Additional land is being acquired from the adjacent by Oull Claim Description to fit the boundary as shown and described hereon.

**Parcel No. 1
As Surveyed Description**

A PART OF THE SOUTHEAST QUARTER OF SECTION 33, TOWNSHIP 7 NORTH, RANGE 2 WEST OF THE SALT LAKE BASE AND MERIDIAN.
BEGINNING AT A POINT LOCATED NORTH 01°00'00" EAST 1032.25 FEET FROM ALONG THE EAST LINE OF SAID SOUTHEAST QUARTER AND NORTH 89°00'00" WEST 373.68 FEET FROM THE SOUTHEAST CORNER OF SAID SOUTHEAST QUARTER, SAID POINT BEING ON THE WEST BOUNDARY LINE OF PARCEL 190350036; RUNNING THENCE SOUTH 00°59'08" WEST 180.28 FEET TO THE NORTHEAST CORNER OF PARCEL 190350021; THENCE NORTH 88°29'38" WEST 363.02 FEET ALONG AN EXISTING FENCE LINE WHICH IS PARALLEL TO 1975 NORTH STREET TO THE EAST RIGHT-OF-WAY LINE OF 3800 WEST STREET; THENCE NORTH 00°59'08" EAST 348.58 FEET ALONG SAID EAST RIGHT-OF-WAY LINE; THENCE NORTH 89°51'41" EAST 383.07 FEET TO THE WEST BOUNDARY LINE OF PARCEL 190350038; THENCE SOUTH 00°59'08" WEST 206.75 FEET ALONG SAID WEST BOUNDARY LINE TO THE POINT OF BEGINNING.
CONTAINING 2.93 ACRES.

S 86°41'48" E

2696.50'

<p>PROPERTY SURVEY FOR Steve Griffin 2068 North 3600 West Plain City, Weber County, Utah A PART OF THE SOUTHEAST QUARTER OF SECTION 33, TOWNSHIP 7 NORTH, RANGE 2 WEST, S.L.& M.</p>	
<p>Drawn By: JGH Designed By: DESIGN Checked By: Approved By: Scale: 1"=100' Drawing File: 02-3-33.dwg JOB NUMBER: 02-3-33</p>	<p>DATE: 03/08/07</p>
<p>HANSEN & ASSOCIATES, INC. Consulting Engineers and Land Surveyors Brigham City, Utah 84302 Logan, Utah 84321 Ogden, Utah (435) 752-8197 (435) 723-3481 (435) 723-7863 (801) 398-4905 (435) 752-8272</p>	
<p>SHEET 1 OF 1 SHEETS</p>	<p>Revision By Date No.</p>