


**SURVEYOR'S CERTIFICATE**

I DALLAS K. BUTTARS, HOLDING LICENSE NUMBER 167594 IN ACCORDANCE WITH TITLE 58, CHAPTER 22, PROFESSIONAL ENGINEERS AND LAND SURVEYORS LICENSING ACT, HAVE COMPLETED A SURVEY OF THE PROPERTY DESCRIBED ON THE PLAT IN ACCORDANCE WITH SECTION 17-23-17 AND HAVE VERIFIED ALL MEASUREMENTS AND PLACED MONUMENTS AS REPRESENTED ON THE PLAT.

I DO ALSO HEREBY CERTIFY THAT THIS PLAT OF STEVE BAUCH PROPERTY


IN WEBER COUNTY, UTAH, HAS BEEN CORRECTLY DRAWN TO SCALE AND IS A TRUE AND CORRECT REPRESENTATION OF THE FOLLOWING DESCRIPTION OF LANDS INCLUDED IN SAID SUBDIVISION, BASED ON DATA COMPILED FROM RECORDS IN THE WEBER COUNTY RECORDERS OFFICE, WEBER COUNTY SURVEYORS OFFICE AND OF A SURVEY MADE ON THE GROUND AND I FURTHER CERTIFY THAT ALL LOTS MEET CURRENT LOT WIDTH AND AREA REQUIREMENTS FOR WEBER COUNTY ZONING.

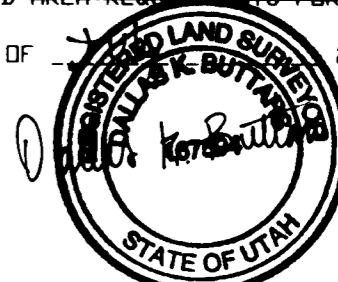

SIGNED THIS 5<sup>th</sup> DAY OF JUNE 2007

**BOUNDARY DESCRIPTION**

ALL OF LOTS 5, 6, 7 AND THE WESTERLY 11.20 FEET OF LOT 8, BLOCK 1, RIVER PARK ADDITION, ACCORDING TO THE OFFICIAL PLAT THEREOF AS RECORDED IN THE OFFICE OF THE WEBER COUNTY RECORDER.

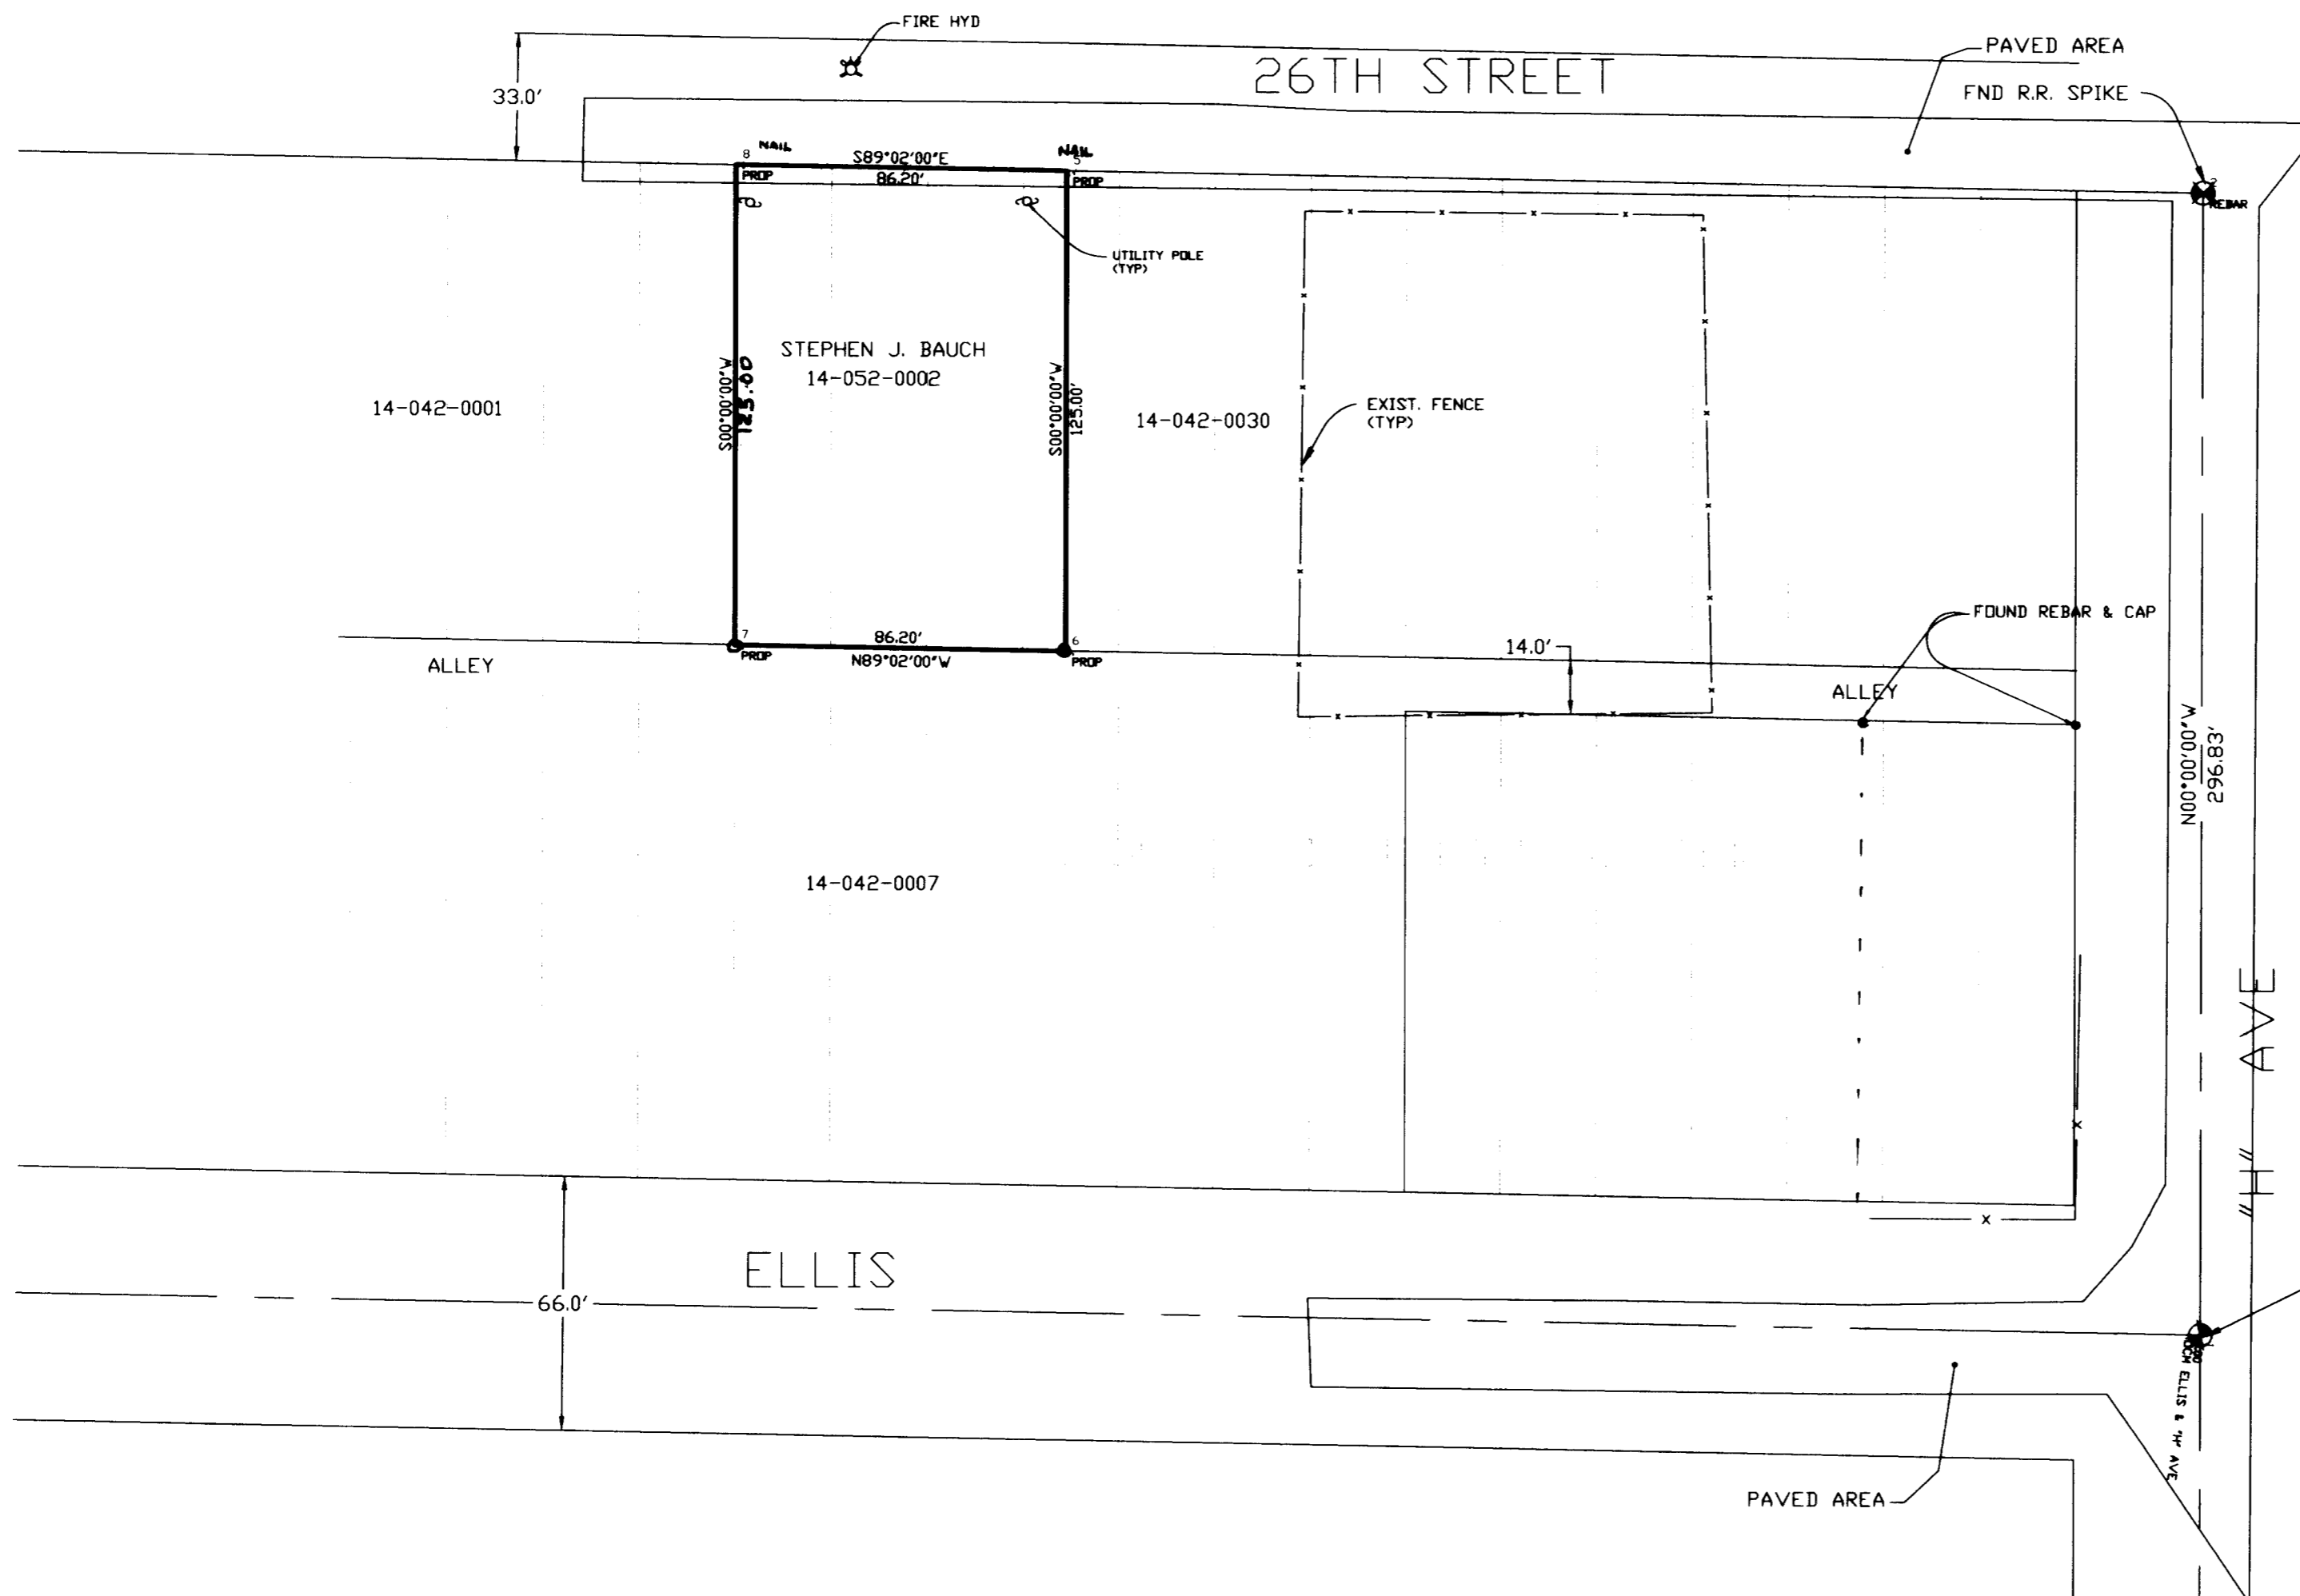

**NARRATIVE**

THE PURPOSE OF THIS SURVEY WAS TO DETERMINE THE BOUNDARY OF SHOWN PARCEL. MONUMENTS AND FOUND REBAR ARE SHOWN.

**RECEIVED**  
AUG 31 2007  
WEBER CO SURVEYOR

**LANDMARK SURVEYING, INC.**  
A COMPLETE LAND SURVEYING SERVICE  
4646 S. 3500 W. #3, WEST HAVEN, UTAH 84401  
PHONE 801-731-4075

CLIENT: STEVE BAUCH  
LOCATION: 26TH ST. & 'H' ST. OGDEN, UTAH  
SURVEYED: JUNE 2007

REVISIONS:	DRAWN BY: D.B.
	CHECKED BY: D.B.
	DATE: 7-5-07
	FILE: 2939