

RECORD OF SURVEY

LOTS 31, 32, 33, 34 WEBER INDUSTRIAL PARK OGDEN CITY, WEBER COUNTY, UTAH



SCALE: 1" = 100'


○ = 5/8"x24" LENGTH REBAR WITH CAP STAMPED 167594

SURVEYORS CERTIFICATE

I, DALLAS K. BUTTARS, HOLDING LICENSE NUMBER 167594 IN ACCORDANCE WITH TITLE 5B, CHAPTER 22, PROFESSIONAL ENGINEERS AND LAND SURVEYORS LICENSING ACT, HAVE COMPLETED A SURVEY OF THE PROPERTY DESCRIBED ON THE PLAT IN ACCORDANCE WITH SECTION 17-23-17 AND HAVE VERIFIED ALL MONUMENTS AND PLACED MONUMENTS AS REPRESENTED ON THIS PLAT.

SIGNED THIS 12 DAY OF AUGUST 2007

R.L.S. # 167594

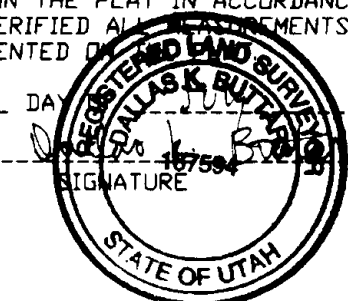

BOUNDARY DESCRIPTION

ALL OF LOTS 31, 32, AND 33 OF WEBER INDUSTRIAL PARK SUBDIVISION, PLAT "B", ACCORDING TO THE OFFICIAL PLAT THEREOF, ON FILE AND OF RECORD IN THE OFFICE OF THE WEBER COUNTY RECORDER, STATE OF UTAH, CONTAINS 12.83 ACRES

NARRATIVE

THE PURPOSE OF THIS SURVEY WAS TO SET THE PROPERTY CORNERS FOR THE PARCEL SHOWN ON THIS PLAT. THE BASIS OF BEARING IS UTAH STATE PLANE GRID BEARING.

002879

RECEIVED

AUG 31 2007

WEBER CO SURVEYOR

LANDMARK SURVEYING, INC. A COMPLETE LAND SURVEYING SERVICE 4646 S. 3500 W. #A-3, WEST HAVEN, UTAH 84401 PHONE 801-731-4075 FAX 801-731-8506	
CLIENT: TONY CALABRESE	
LOCATION: LOTS 31, 32, 33, 34 WEBER INDUSTRIAL PARK, OGDEN UT.	
SURVEYED: 07-12-06	
REVISIONS:	DRAWN BY: K.R.
	CHECKED BY: D.B.
	DATE: 07-13-06
	FILE: 2835r0fs