

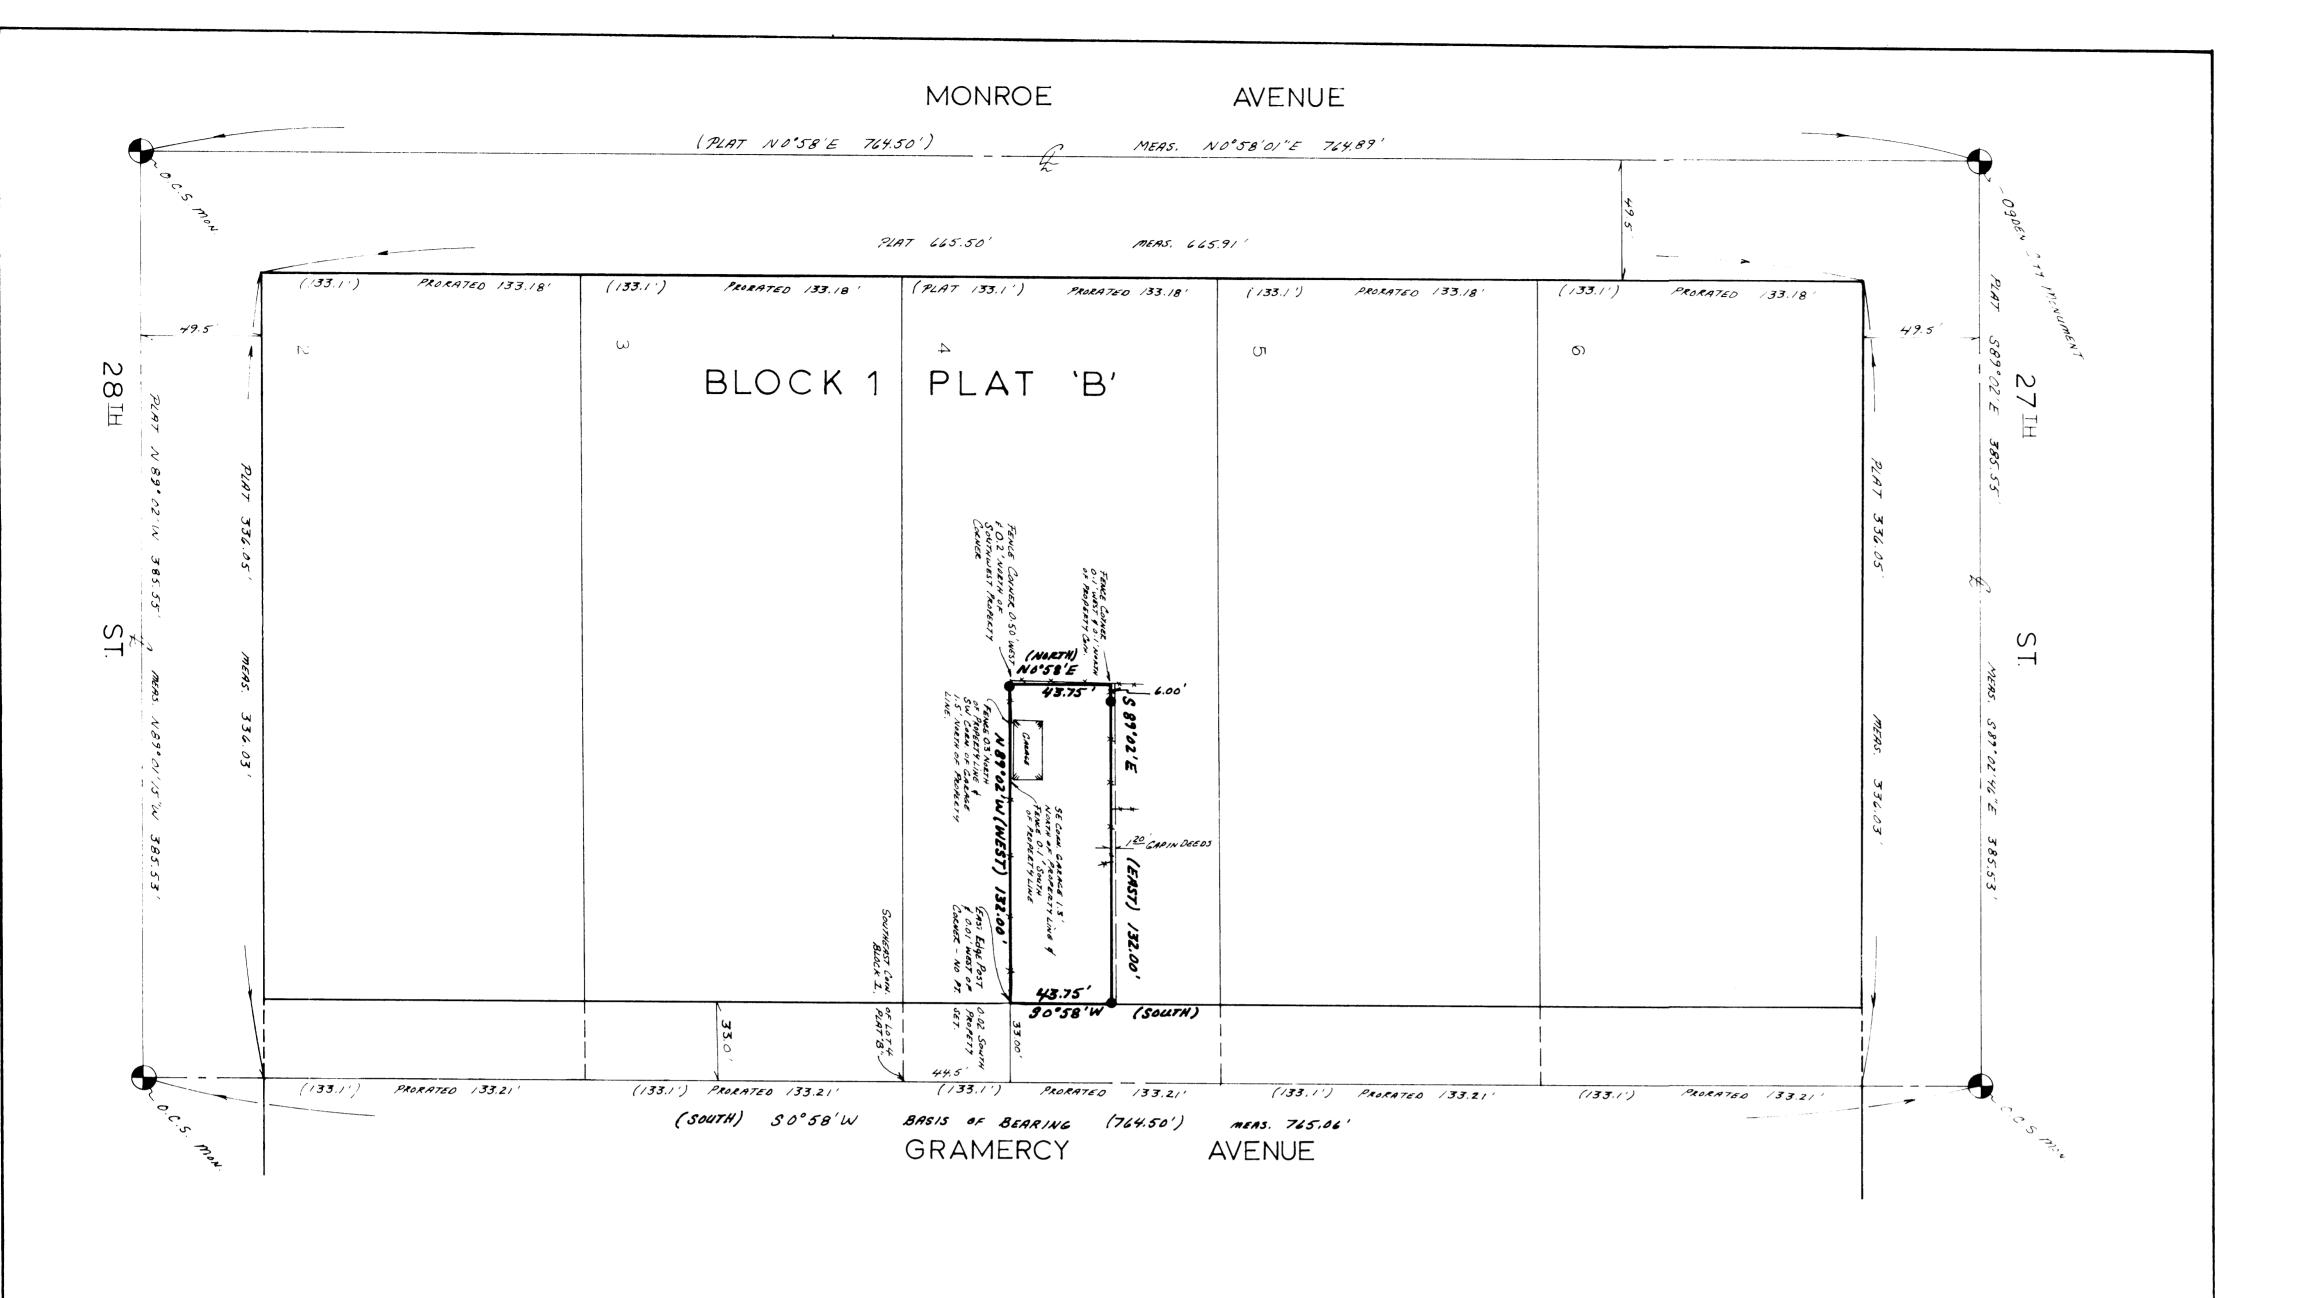

POSE OF THIS SURVEY WAS DONE BECAUSE CLIENT (CLARA L. THOUGHT THAT HER SOUTH FENCE LINE BELONGED MATELY 2.5 FEET SOUTH OF ITS EXISTING LOCATION OF WHAT A CITY SURVEY CREW OR INSPECTOR HAD TOLD HER OING SOME MEASURING TOLD HER THAT SHE HAD ALL HER TO HER PROPERTY WITHIN HER NORTH AND SOUTH FENCES, THERE WAS PROBABLY NOTHING WRONG, SO SHE DECIDED HAVE IT SURVEYED AT THAT TIME.

CONTACTED AGAIN THIS WINTER (1990) BY CLARA BOYLE AND CONTACTED AGAIN THIS WINTER (1990) BY CLARA BOYLE AND CIT I WOULD DO HER SURVEY, I AGREED TO AND FOUND THAT I HE MOST PROBABLE CAUSE THAT I FOUND WHY SOME ONE THE COUNTY OWNERSHIP PLATS SHOW LOT WIDTHS OF 132 ND OGDEN CITY SURVEY PLATS SHOW LOT WIDTHS OF 132 ND OGDEN CITY SURVEY PLATS SHOW THEM TO BE 133.1 FEET MODE 2.5 FEET AND 133.21 FEET AND 133.21 FEET THE I FEET MORE OR LESS SOUTH I FEET AND 133.21 WOULD GIVE THE IMPRESSION THAT THEN THE TAKEN FROM O.C.S. MONUMENT AT THE CENTER TERSECTION OF 28th STREET AND GRAMERCY AVENUE (AS MONUMENTED) BETWEEN 28th STREETS.

STER L. NELSON DO HEREBY CERTIFY THAT I TERED LAND SURVEYOR, AND THAT I HOLD CERNS PRESCRIBED BY THE LAWS OF THE STATE CONTROLORY ON THE GROUND, AND BER COUNTY RECORDERS OFFICE AND AS DESCRET THIS PLAT.

OF LOT 4, BLOCK 1, PLAT "B" DGDEN CITY SURVING AT A POINT 44.5 FEET N. 0° 58' E. (NORT N. 89° 02' W. (WEST) FROM THE SOUTHEAST CORN AND RUNNING THENCE N. 89° 02' W. (WEST) 13 N. 0° 58' E. (NORTH) 43.75 FEET, THENCE SST) 132 FEET, THENCE S. 0° 58' W. (SOUTH) 4 INNING.


JUL 2 5 1990
Weber County Surveyor

SET 5/8" X 24" REBAR W/ C & L S SURVEY CAP.

EXISTING FENCE.

DISTANCE AND OR BEARING PER DEED OR PLAT.

NO PARENTHESES IS MEASURED DISTANCE OR ROTATED PLAT OR DEED BEARING TO OGDEN CITY SURVEY BASIS OF BEARING.