


Surveyor's Certificate

I, **ROBERT D. KUNZ**, DO HEREBY CERTIFY THAT I AM A REGISTERED PROFESSIONAL LAND SURVEYOR IN THE STATE OF UTAH IN ACCORDANCE WITH TITLE 58, CHAPTER 22, PROFESSIONAL ENGINEERS AND LAND SURVEYORS ACT; AND THAT I HAVE COMPLETED A SURVEY OF THE PROPERTY DESCRIBED ON THIS PLAT IN ACCORDANCE WITH SECTION 17-23-17 AND HAVE VERIFIED ALL MEASUREMENTS, AND HAVE PLACED MONUMENTS AS REPRESENTED ON THIS PLAT. I FURTHER CERTIFY THAT THIS PLAT IS A CORRECT REPRESENTATION OF THE LAND SURVEYED AND HAS BEEN PREPARED IN CONFORMITY WITH THE MINIMUM STANDARDS AND REQUIREMENTS OF THE LAW.

SIGNED THIS 15th DAY OF November, 2007

150228-2201
UTAH LICENSE NUMBER

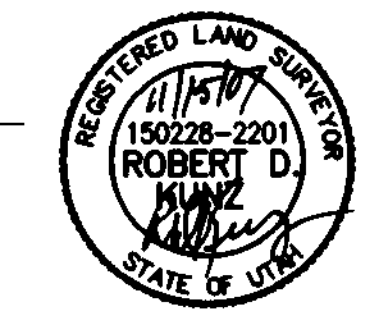

Robert D. Kunz
ROBERT D. KUNZ

Basis Of Bearings

THE BASIS OF BEARINGS FOR THIS PLAT IS THE SECTION LINE BETWEEN THE SOUTHEAST CORNER AND NORTHEAST CORNER OF SECTION 22, T.5N., R.3W., S.L.B.&M., U.S. SURVEY. SHOWN HEREON AS N00°31'42"W

Narrative

THE PURPOSE OF THIS SURVEY IS TO DETERMINE THE BOUNDARY OF PARCEL A AND PARCEL B. ALL BOUNDARY CORNERS WERE SET WITH A 5/8" REBAR AND PLASTIC CAP STAMPED "REEVE & ASSOCIATES". SURVEY REQUESTED BY

Parcel A Description

PART OF THE EAST HALF OF SECTION 22, T.5N., R.3W., S.L.B.&M., U.S. SURVEY, DESCRIBED AS FOLLOWS:

BEGINNING AT A POINT, SAID POINT BEING N00°31'42"W 1443.35 FEET AND S89°28'18"W 1307.65 FEET FROM THE SOUTHEAST CORNER OF SECTION 22; THENCE S88°33'15"W 615.55 FEET; THENCE N12°51'08"E 228.76 FEET; THENCE N07°07'45"E 259.44 FEET; THENCE N03°10'54"E 346.18 FEET; THENCE N00°01'28"W 163.96 FEET; THENCE N02°34'15"W 184.62 FEET; THENCE N01°43'45"W 388.70 FEET; THENCE N00°15'13"W 148.11 FEET; THENCE N43°49'52"E 250.72 FEET; THENCE N48°22'19"E 265.62 FEET; THENCE N39°21'35"E 89.66 FEET; THENCE N89°37'48"E 87.03 FEET; THENCE S00°34'20"E 1010.69 FEET; THENCE N89°57'35"W 20.44 FEET; THENCE S01°26'45"E 1112.54 FEET;

CONTAINING 23.41 ACRES

Parcel B Description


PART OF THE EAST HALF OF SECTION 22, T.5N., R.3W., S.L.B.&M., U.S. SURVEY, DESCRIBED AS FOLLOWS:

BEGINNING AT A POINT, SAID POINT BEING N00°31'42"W 1443.35 FEET AND S89°28'18"W 1307.65 FEET FROM THE SOUTHEAST CORNER OF SECTION 22; THENCE S01°26'45"E 361.95 FEET; THENCE S00°52'53"W 739.64 FEET; THENCE S00°00'22"E 321.97 FEET; THENCE N89°50'58"W 841.04 FEET; THENCE N08°00'08"E 285.10 FEET; THENCE N18°35'26"E 223.20 FEET; THENCE N08°46'18"E 67.40 FEET; THENCE N18°40'02"E 112.67 FEET; THENCE N03°49'31"E 237.46 FEET; THENCE N14°06'14"W 65.67 FEET; THENCE N01°39'37"E 114.50 FEET; THENCE N10°36'28"E 154.72 FEET; THENCE N12°51'08"E 175.64 FEET; THENCE N88°33'15"E 615.55 FEET;

CONTAINING 23.42 ACRES

Legend

- = SECTION CORNER
- = SET 5/8" REBAR AND PLASTIC CAP STAMPED "REEVE & ASSOCIATES"
- = BOUNDARY LINE
- = LOT LINE
- = ADJOINING PROPERTY
- = DITCH
- = SECTION TIE LINE
- = EXISTING FENCE

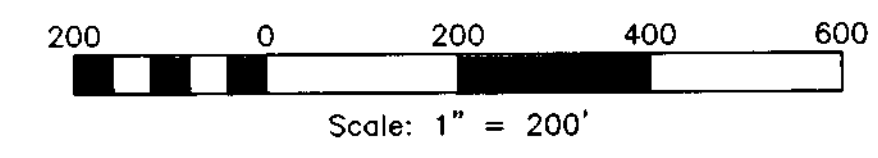

Reeve & Associates, Inc.
TEL: (801) 821-3100 FAX: (801) 821-3666 www.reeve-assoc.com

REVISIONS	DESCRIPTION
DATE	

Record of Survey
PART OF THE EAST HALF OF SECTION 22, T.5N., R.3W., S.L.B.&M., U.S. SURVEY

Parker Property

003945

003945

Project Info.

Surveyor:	R. KUNZ
Designer:	N. ANDERSON
Begin Date:	02-01-07
Name:	PARKER PROPERTY
Scale:	1"=200'
Checked:	MYLR 10/16/07
Number:	4628-02