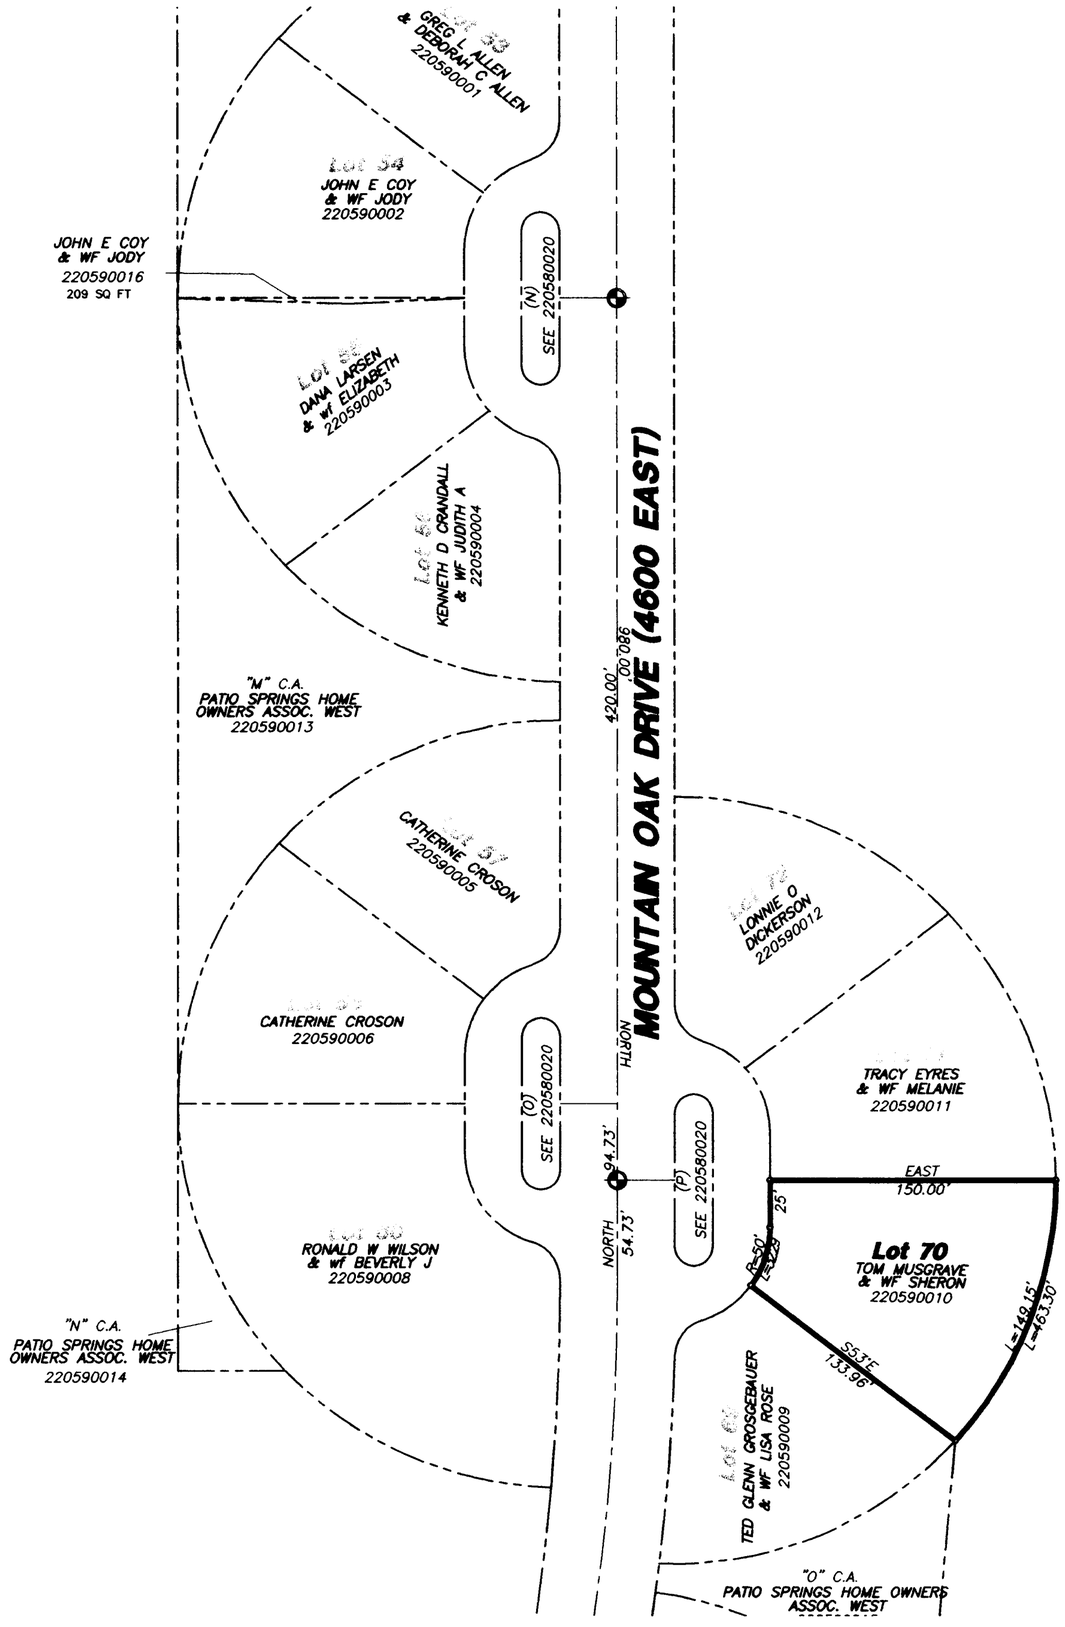


RECEIVED
FEB 05 2008
WEBER CO SURVEYOR

Scale: 1" = 60'

## LEGEND:

- PROPERTY LINE
- CENTERLINE
- EDGE OF PAVEMENT
- DITCH
- FENCE LINE
- SET 5/8" REBAR W/ CAP SET 09/01/07
- WEBER COUNTY BRASS CAP MONUMENT

## SURVEY CERTIFICATE

I, K. Greg Hansen, do hereby certify that I am a Registered Land Surveyor, and that I hold Certificate No. 167819 as prescribed by the Laws of the State of Utah, and that I have made and/or Supervised the survey of the property shown and described hereon and that this plat is a true and correct representation of said survey to the best of my knowledge and belief.

K. Greg Hansen, R.L.S. No. 167819 — Dec. 11, 2007 date

REGISTERED LAND SURVEYOR 167819 K. GREG HANSEN STATE OF UTAH

## Narrative

The purpose of this survey was to establish and set the property corners of the parcel as shown and described hereon. The survey was ordered by Tom Musgrave. The control used to establish the property corners was the existing Weber County Survey Monumentation at the west quarter corner of Section 22, T7N, R1E, SLB&M along with found HAI rebar from the 1991 survey done by HAI for Weber Co. on Patio Springs. The basis of bearing is the North line of the southwest quarter of said Section assumed to bear N 89°31'15" W.

| No. | Date | By | Revision |
|---|---|---|---|

HANSEN & ASSOCIATES, INC.
Consulting Engineers and Land Surveyors
538 North Main Brigham City, Utah 84302
Brigham City (435)723-3491 | Ogden (801)399-4905 | Logan (435)752-8272

Drawn By: kgh Date: 01/02/07
Designed By:
Checked By:
Approved By:
Scale: 1" = 60'
Drawing File: 07-3-127.dwg
JOB NUMBER: 07-3-127

PROPERTY SURVEY FOR
# Tom Musgrave
3770 North Willowbrooke Lane
Eden, Weber Co., Utah
A Part of the Southwest Quarter of Section 22, T 7 N., R 1 E., S.L.B.&M.

SHEET 1 OF 1 SHEETS