


003993

RECEIVED  
FEB 05 2008  
WEBER CO SURVEYOR

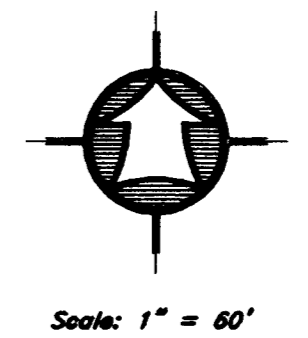

- LEGEND:**
- PROPERTY LINE
  - CENTERLINE
  - EDGE OF PAVEMENT
  - DITCH
  - FENCE LINE
  - SET 5/8" REBAR W/ CAP SET 03/25/04
  - WEBER COUNTY BRASS CAP MONUMENT

**SURVEY CERTIFICATE**

I, K. Greg Hansen, do hereby certify that I am a Registered Land Surveyor, and that I hold Certificate No. 167819 as prescribed by the Laws of the State of Utah, and that I have made and/or Supervised the survey of the property shown and described hereon and that this plat is a true and correct representation of said survey to the best of my knowledge and belief.

K. Greg Hansen, R.L.S. No. 167819  
 K. GREG HANSEN  
 STATE OF UTAH  
 date: Dec 11, 2007

**Narrative**

The purpose of this survey was to establish and set the property corners of the parcel as shown and described hereon. The survey was ordered by Matt Musgrave. The control used to establish the property corners was the existing Weber County Survey Monumentation at the west quarter corner of Section 22, 17N, 11E, SLB&M along with found HAI rebar from the 1991 survey done by HAI for Weber Co. on Patio Springs. The basis of bearing is the North line of the southwest quarter of said Section assumed to bear N 89°31'15" W.

PROPERTY SURVEY FOR		Date: 07/02/07	
<b>Matt Musgrave</b>		Designed By: _____	
3770 North Willowbrooke Lane Eden, Weber Co., Utah		Checked By: _____	
A Part of the Southwest Quarter of Section 22, T 7 N., R 1 E., S.L.B.&M.		Approved By: _____	
		Scale: 1" = 60'	
		Drawing File: 07-3-127.dwg	
		JOB NUMBER: 07-3-127	
		HANSEN & ASSOCIATES, INC. Consulting Engineers and Land Surveyors	
		538 North Main Brigham City, Utah 84302	
		Brigham City Ogden Logan	
		(801)399-4905 (435)723-3491 (435)752-8272	
		No. _____	
		Date _____	
		By _____	
		Revision _____	
SHEET			
1			
OF			
1			
SHEETS			