


PINNACLE
Engineering & Land Surveying, Inc.
Layton • West Bountiful • Mount Pleasant • St. George
1513 North Hinfield Rd., Suite #2
Layton, UT 84041
Phone: (801) 866-0676
Fax: (801) 866-0678

MILLER SURVEY
BOUNDARY SURVEY/PARCEL SPLIT
LINDA MILLER
3885 SOUTH 5900 WEST
HOOPER, UT
JOB# 04-086

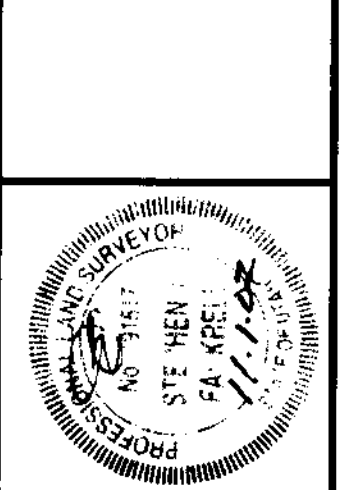

DATE	REVISION
09/2004	
07/2007	

SURVEYED BY	DATE	DESIGNED BY	DATE	DRAWN BY	DATE	APPROVED BY	DATE
SPB	09/2004	BTA	07/2007	SJF			

SHEET #	OF
1	1