


**Narrative**  
 The purpose of this survey was to establish and set the property corners of the parcel as shown and described hereon. The survey was ordered by Mike Daniels. The control used to establish the property corners was the existing found rebar located around lot 54, 55 and 56 of the Big Sky Subd. The basis of bearing is the south line of lot 55 assumed to bear S 70°46'45" W.

**Property Description**  
 ALL OF LOT 52, BIG SKY ESTATES NO. 2, WEBER CO., UTAH

- LEGEND:**
- PROPERTY LINE
  - CENTERLINE
  - EDGE OF PAVEMENT
  - DITCH
  - FENCE LINE
  - FOUND T-BAR FENCE POST
  - SET 5/8" REBAR W/ CAP SET 05/23/08

(C1)  
 $\Delta = 1^{\circ}54'57''$   
 $R = 708.53'$   
 $L = 23.69'$   
 $LC = 23.69'$   
 $S 24^{\circ}45'50'' E$

RECEIVED  
 JUL 21 2008  
 WEBER CO SURVEYOR

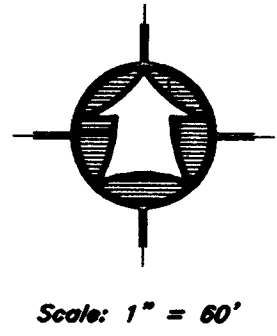

**SURVEY CERTIFICATE**  
 I, K. Greg Hansen, do hereby certify that I am a Registered Land Surveyor, and that I hold Certificate No. 167819 as prescribed by the Laws of the State of Utah, and that I have made and/or Supervised the survey of the property shown and described hereon and that this plot is a true and correct representation of said survey to the best of my knowledge and belief.

K. Greg Hansen, RLS No. 167819  
 K. GREG HANSEN  
 167819  
 STATE OF UTAH  
 July 19, 2008  
 date

PROPERTY SURVEY FOR		HANSEN & ASSOCIATES, INC. Consulting Engineers and Land Surveyors	
Mike Daniels		538 North Main Brigham City, Utah 84302	
2063 North Big Sky Drive Liberty, Weber County, Utah		Ogden 399-4905	
A Part of the Southwest Quarter of Section 33, T 7 N., R 1 E., S.L.B.&M.		Logan 752-8272	
Drawn By: kgh	Date: 08/20/08	Job Number:	08-3-87
Designed By:		Scale: 1" = 60'	
Checked By:			
Approved By:			
SHEET 1		OF 1	
SHEETS			