





GREAT BASIN ENGINEERING, INC.
REGISTERED PROFESSIONAL ENGINEERS
ODDEN & SALT LAKE CITY, UTAH

Property Survey For
JOHN HANSEN

Drawn: R. Porter
Checked: G. Newman
PS-30-58

NOTE: Bearings in parenthesis are State Plane
Grid Bearings according to information
from Weber County Surveyor (W.C.S.).

RECEIVED
DEC 07 1990
Weber County Surveyor

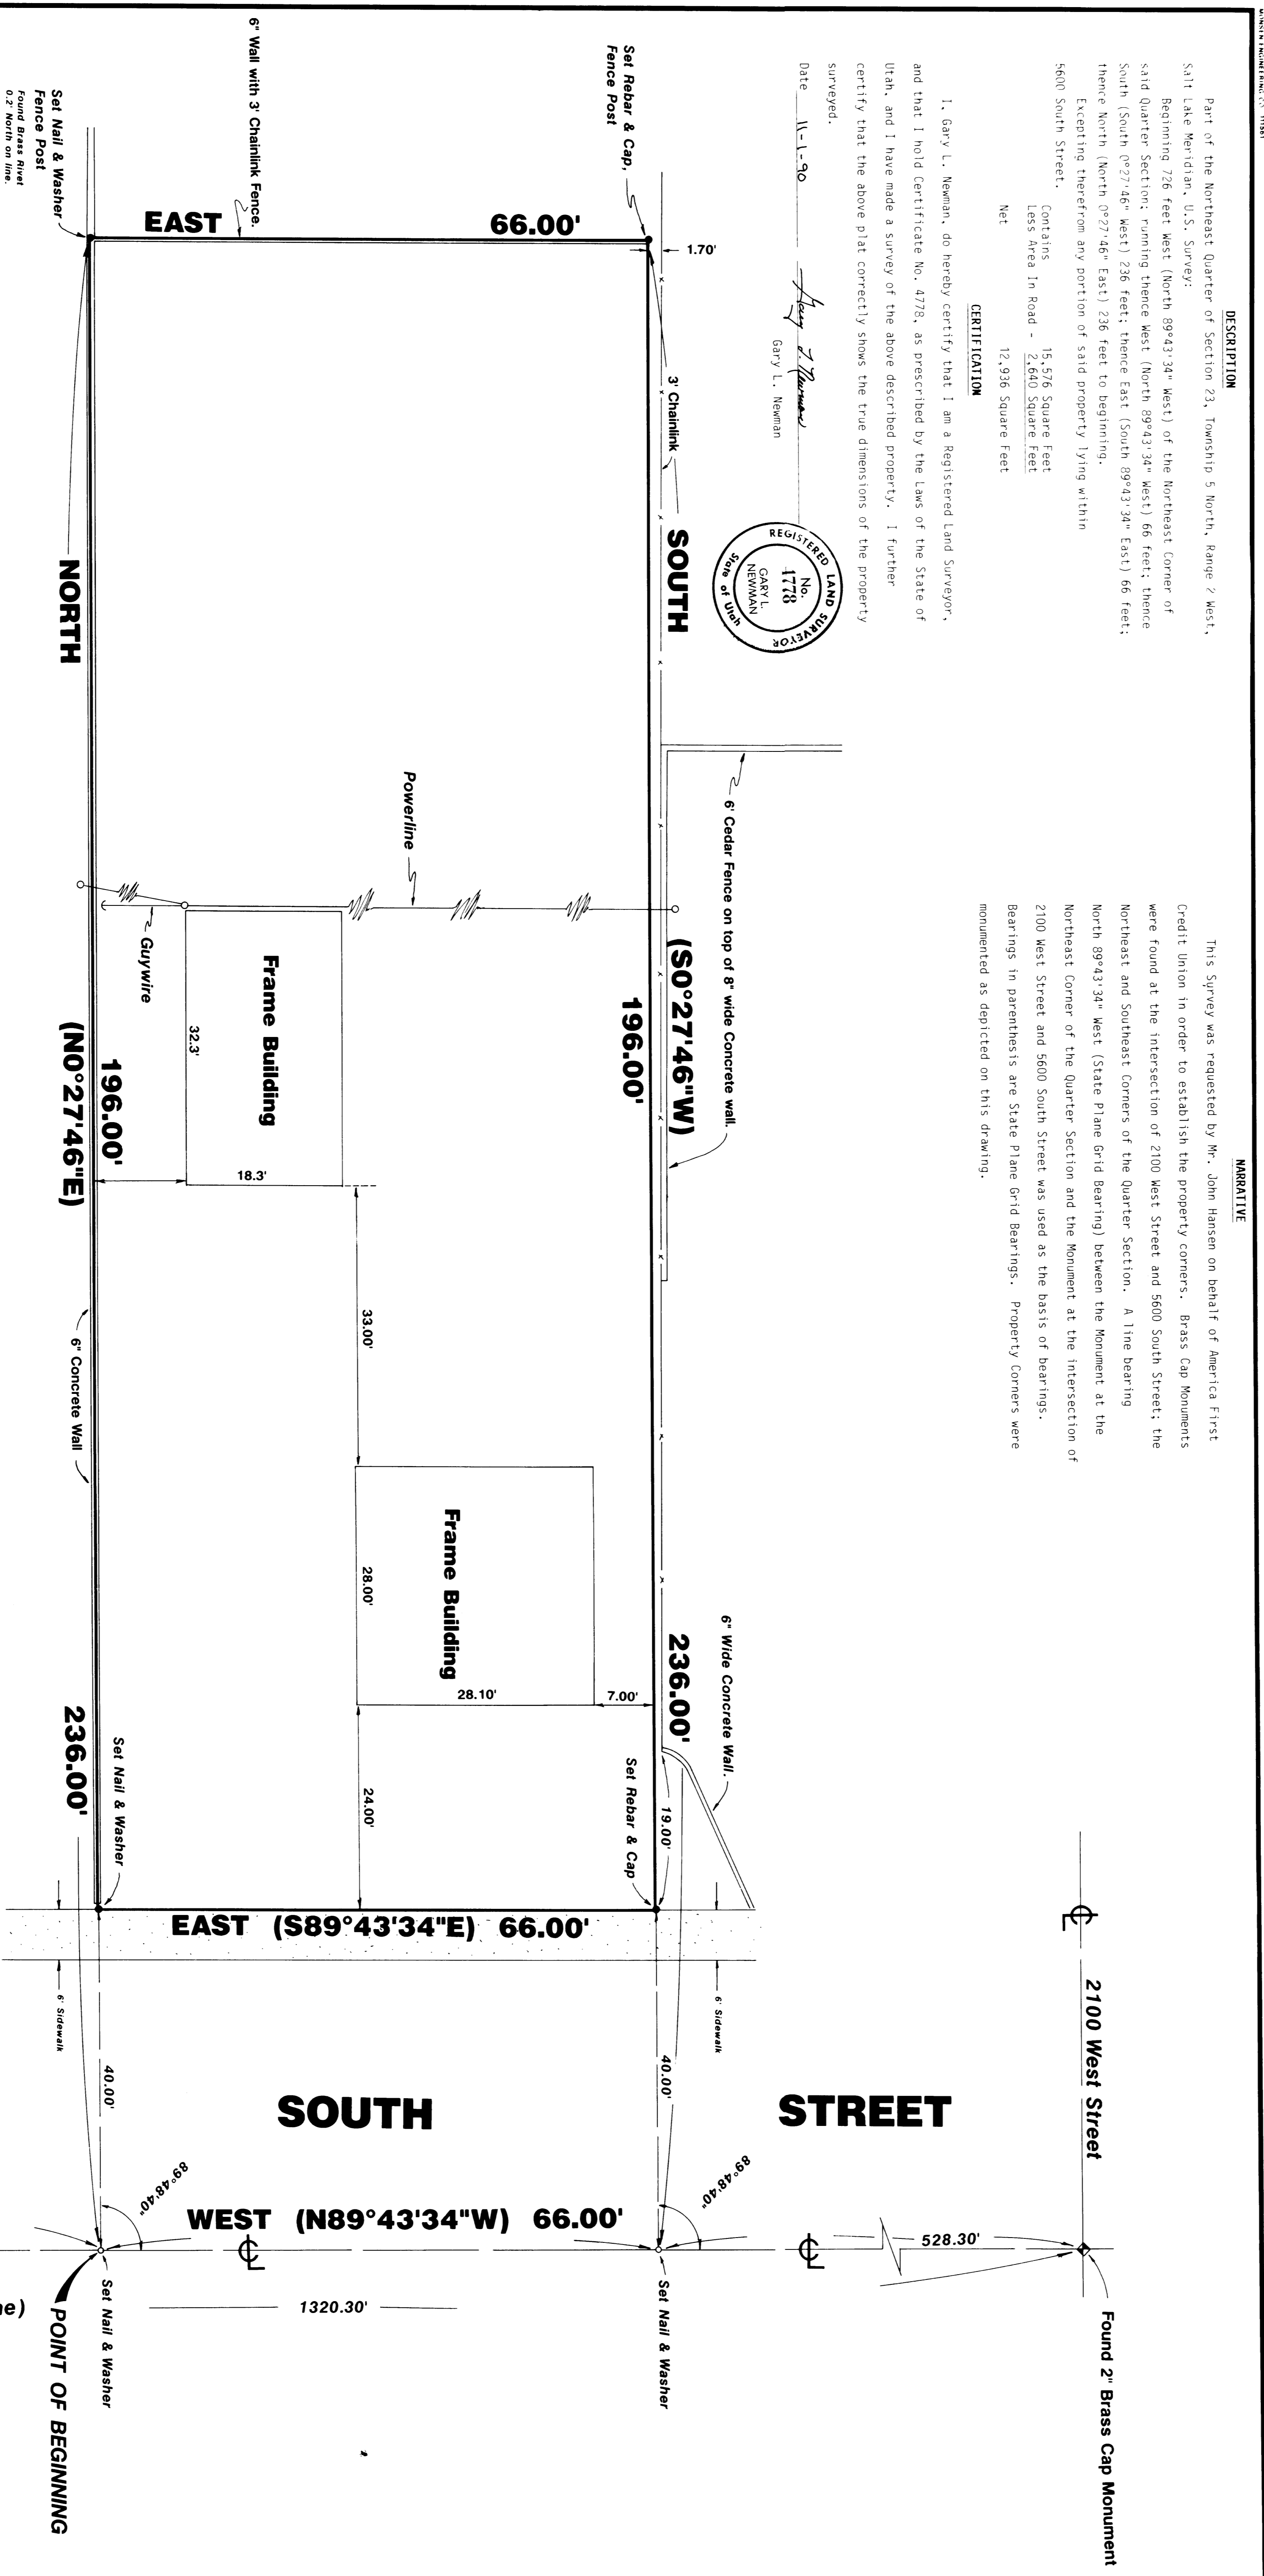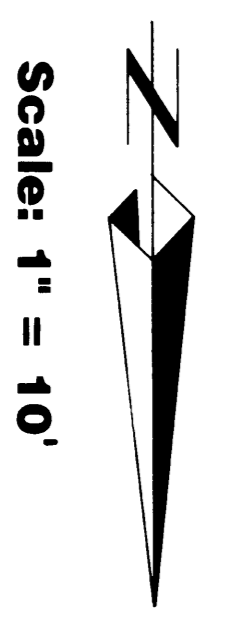








