

West Quarter Corner Section 36,
Township 7 North, Range 2 West,
Salt Lake Base and Meridian.

35 36
35 36

839.52'

S00°03'07"W 2639.52'

S89°35'49"E 67.75'

Found Number 5 Rebar & Cap
Cap Obliterated

S89°35'49"E 165.00'

Found Number 5 Rebar & Cap
Landmark Surveying, Inc.

N00°16'52"W 96.04'

SUBJECT PARCEL
2132 NORTH 1875 WEST
15,058 sq. ft.
0.35 acres

S00°11'11"E 40.44'

Found Number 5 Rebar & Cap
Landmark Surveying, Inc.

S44°12'48"W 128.68'

L=99.58' R=50.00'
Δ=114°6'16"

S30°16'54"E
Rebar

S83°49'22"W
Radial

1875 WEST STREET

No centerline monumentation
was found.

Southwest Corner Section 36,
Township 7 North, Range 2 West,
Salt Lake Base and Meridian.


35 36
2 1

SURVEYORS CERTIFICATE:

I, David E. Hawkes, certify that I am a Professional Land Surveyor holding license number 356548 in accordance with Title 58, Chapter 22, Professional Engineers and Land Surveyors Licensing Act and that a survey of the described tract of land has been completed by me in accordance with Section 17-23-17 and that I have verified all measurements and have placed monuments as shown hereon.

David E. Hawkes
DAVID E. HAWKES

DATE

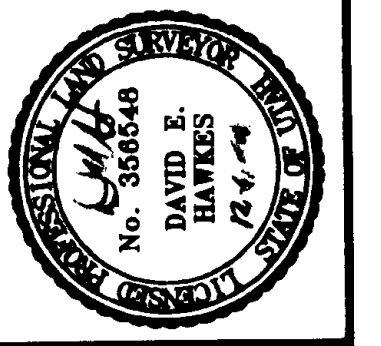

NARRATIVE:

Boundary Consultants were retained by Annette Finster to set the corners of her lot prior to fencing the property. The northwest, northeast and east corners were found and accepted as number 5 rebar and caps set by Landmark Surveying.

DESCRIPTIONS:

All of Lot 4, Stacey Subdivision, Farr West, Weber County, Utah.
Plat Number 66-030, Weber County Recorder's Office


DATE 12-11-08
PLAT DATE
SCALE 1"=10'
PROJECT 08002001

RECORD OF SURVEY OF
TAX PARCEL 19-253-0004

LYING AND SITUATE IN THE SOUTHWEST QUARTER OF SECTION 36,
TOWNSHIP 7 NORTH, RANGE 2 WEST, SALT LAKE BASE AND MERIDIAN

RECEIVED
DEC 15 2008
WEBER CO SURVEYOR

004208

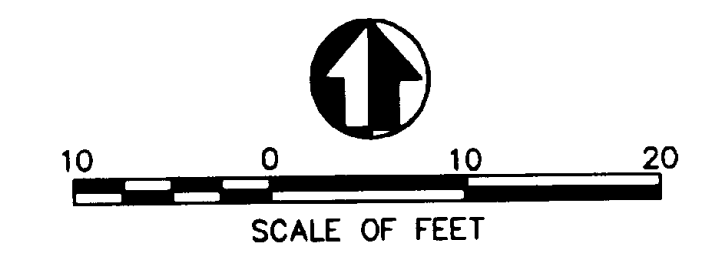

- LEGEND**
- 17 = SECTION CORNER (NOT FOUND) & SECTION LINE
 - 18 = FOUND STREET MONUMENT & CENTER LINES
 - ◆ = SET 5/8" BAR & CAP LS 356548 & PROPERTY LINE
 - = FOUND BAR & CAP AS NOTED
 - ⊙ = EXISTING RIGHT OF WAY LINE (ROW)
 - - - = ADJOINING PROPERTY LINES
 - = DIMENSION LINES

Boundary Consultants
Professional Land Surveyors
7950 South 860 West, Willard, Utah
801-792-1569 435-723-7715 FAX

DEH	DEH	J
1	1	